

AERIAL AS-BUILT PAD LAYOUT



NOTES

UPDATED AERIAL ORTHOIMAGERY COLLECTED BY RPG RESOURCES BY USE OF UAV IN AUGUST, 2021

AREA INSIDE FENCE: 3.08 ACRES

INT. RECLAMATION PAD FOOTPRINT AREA: 1.91 ACRES

ACCESS ROAD SURFACE AREA: 0.46 ACRES



LEGEND

- Access Road
- Fence Line
- Pad Edge
- Well Head




STATE ANTELOPE 14-24 AS-BUILT EXHIBITS

SECTION 24, TOWNSHIP 5N, RANGE 62W,
WELD COUNTY, COLORADO

SHEET NAME:	SHEET NO.
AERIAL IMAGERY	1 OF 4

TOPO AS-BUILT PAD LAYOUT


STATE ANTELOPE 14-24
SWSW_24_5N_62W_108539

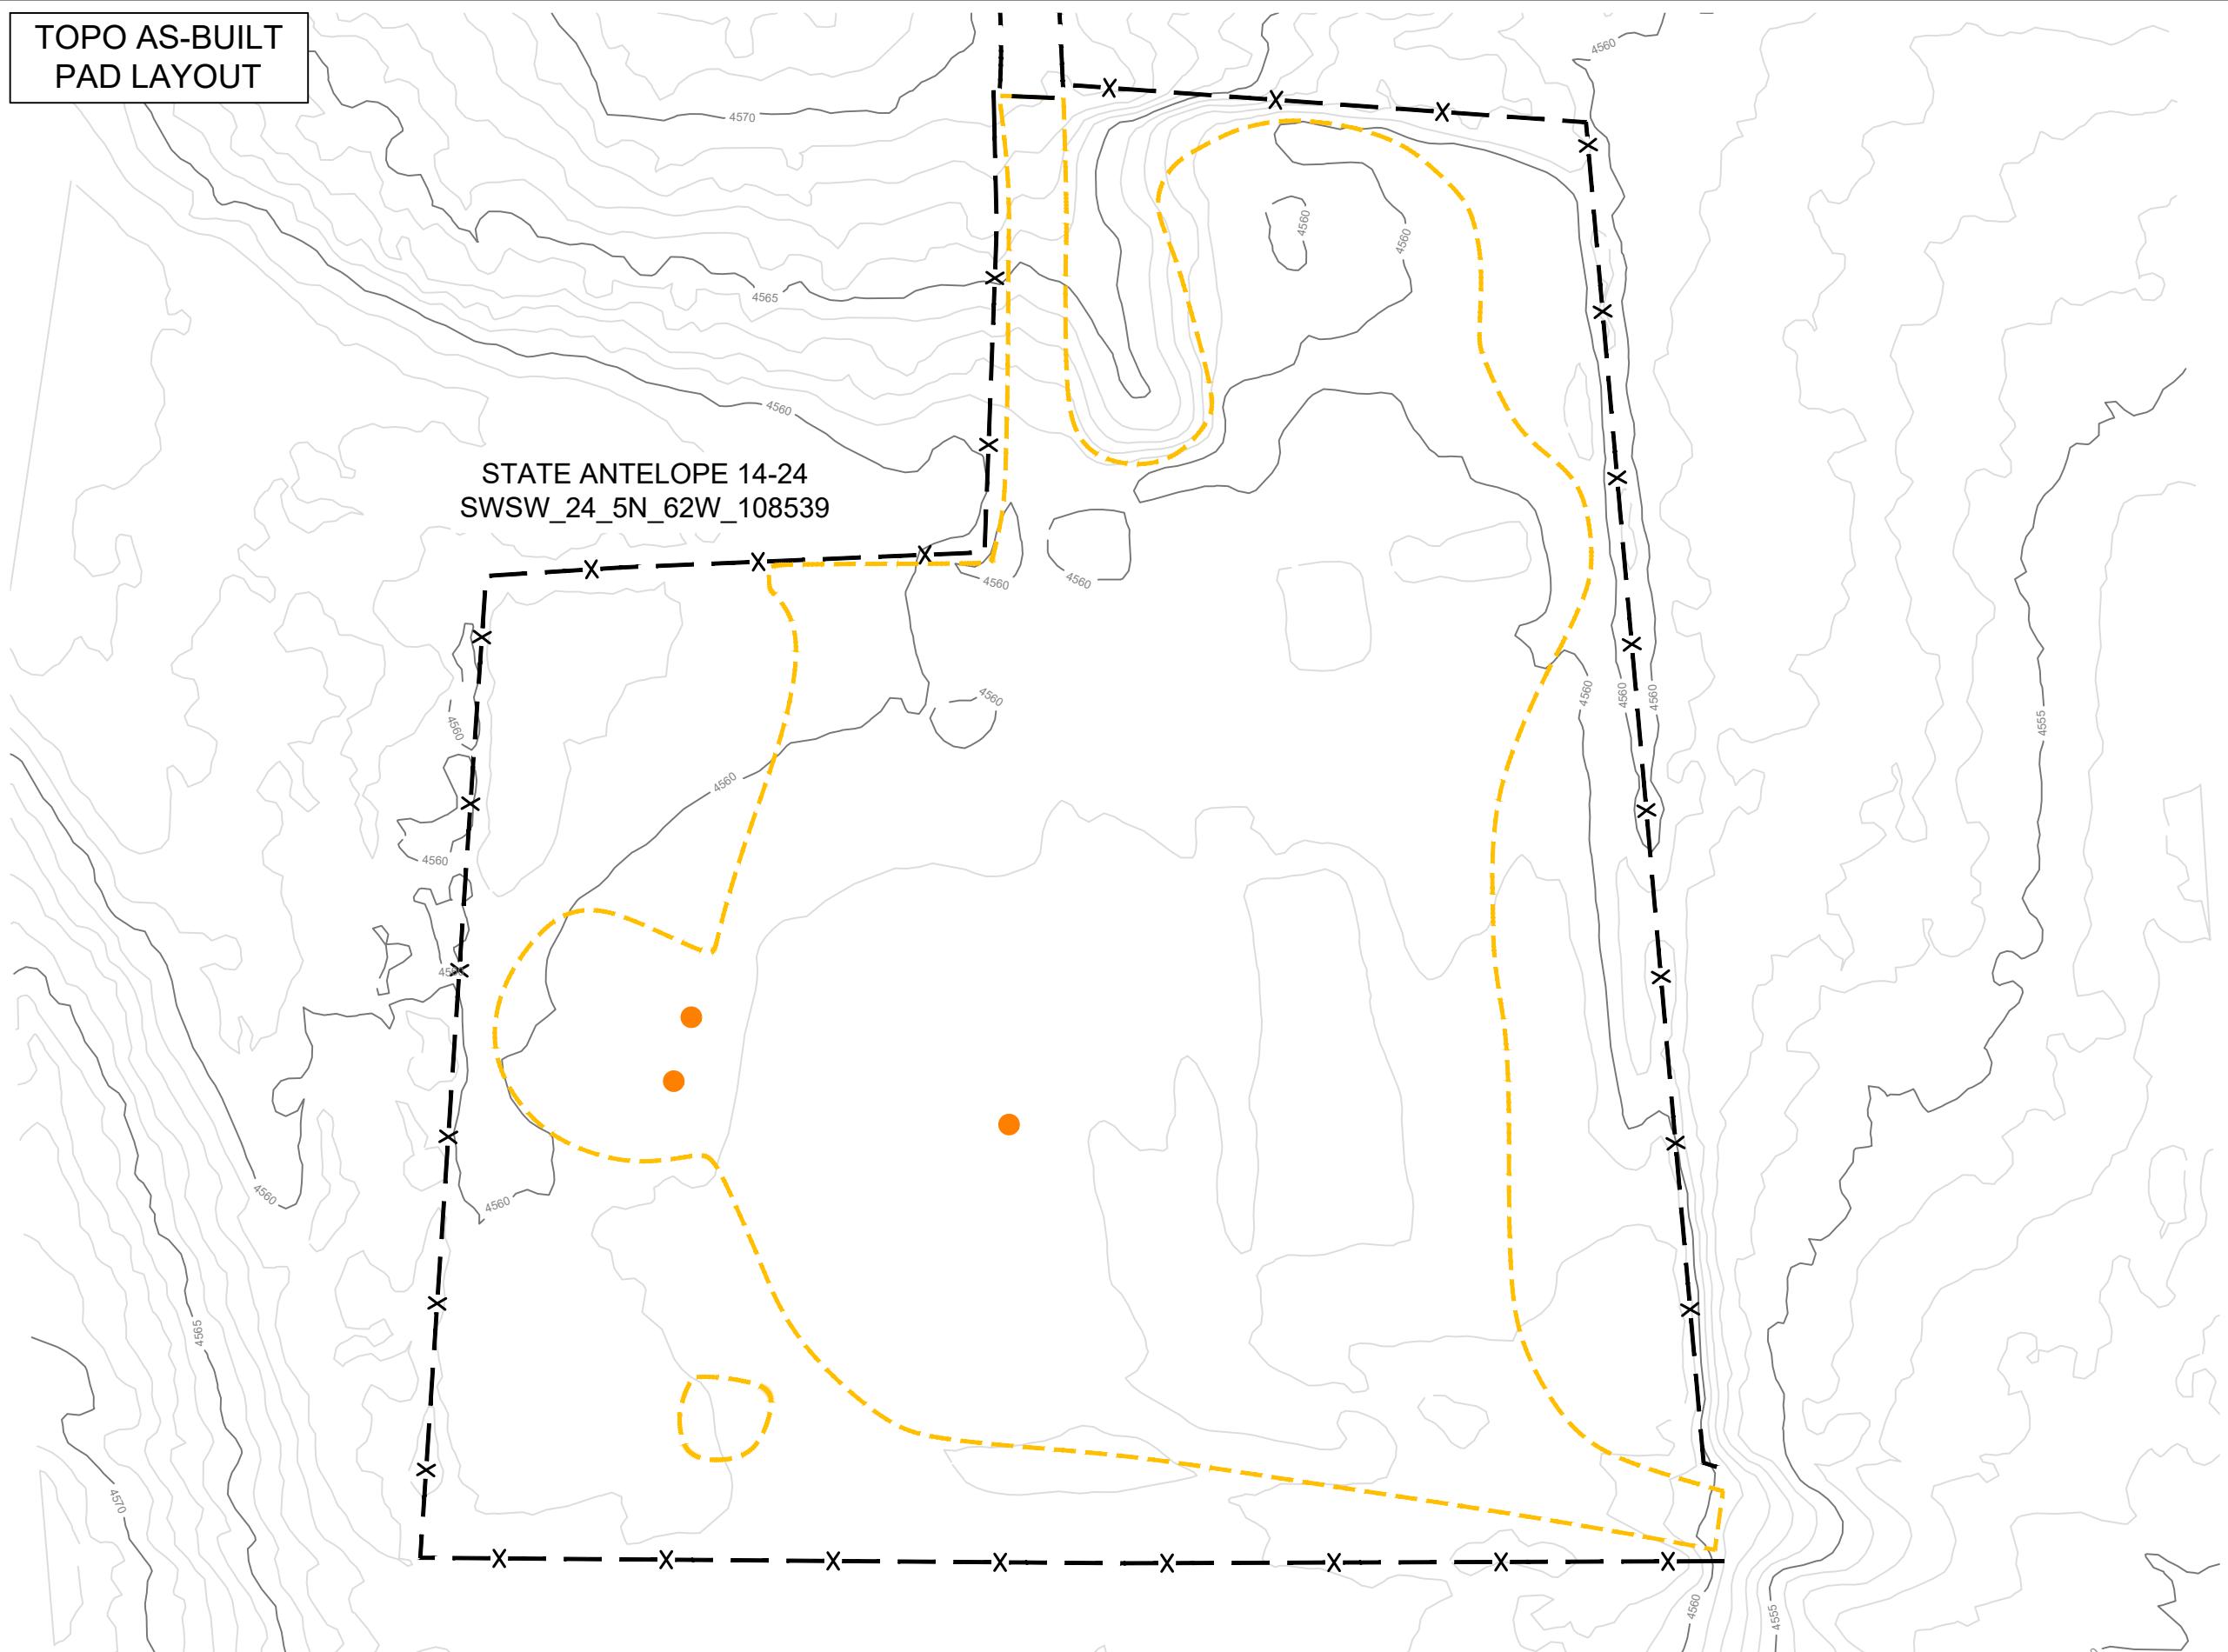

NOTES

**UPDATED TOPO DATA COLLECTED BY RPG
RESOURCES BY USE OF UAV IN AUGUST, 2021**

AREA INSIDE FENCE: 3.08 ACRES
INT. RECLAMATION PAD FOOTPRINT AREA: 1.91 ACRES
ACCESS ROAD SURFACE AREA: 0.46 ACRES

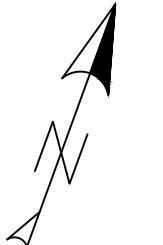

0 50 100
FT

1" = 50'

LEGEND

- The legend consists of five entries, each with a symbol followed by a label:

 - A solid horizontal line with the number "4600" above it, labeled "MAJOR CONTOUR".
 - A dashed horizontal line, labeled "MINOR CONTOUR".
 - A dashed line with vertical dashes, labeled "ACCESS ROAD".
 - A dashed line with "X" marks at the ends, labeled "FENCE LINE".
 - A dashed yellow line, labeled "PAD EDGE".



STATE ANTELOPE 14-24 AS-BUILT EXHIBITS

**SECTION 24, TOWNSHIP 5N, RANGE 62W,
WELD COUNTY, COLORADO**

SHEET NAME:	SHEET NO.
TOPO OVERVIEW	2 OF 4

AERIAL AS-BUILT
PAD LAYOUT





NOTES

**UPDATED AERIAL ORTHOIMAGERY COLLECTED BY
RPG RESOURCES BY USE OF UAV IN AUGUST, 2021**

AREA INSIDE FENCE: 3.08 ACRES

INT. RECLAMATION PAD FOOTPRINT AREA: 1.91 ACRES

ACCESS ROAD SURFACE AREA: 0.46 ACRES

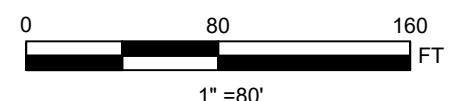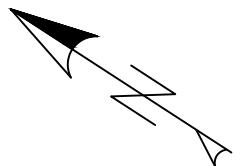

LEGEND

- ACCESS ROAD
- FENCE LINE
- PAD EDGE




STATE ANTELOPE 14-24
AS-BUILT EXHIBITS

SECTION 24, TOWNSHIP 5N, RANGE 62W,
WELD COUNTY, COLORADO

SHEET NAME:	SHEET NO.
ACCESS RD IMAGERY	3 OF 4


**TOPO AS-BUILT
PAD LAYOUT**

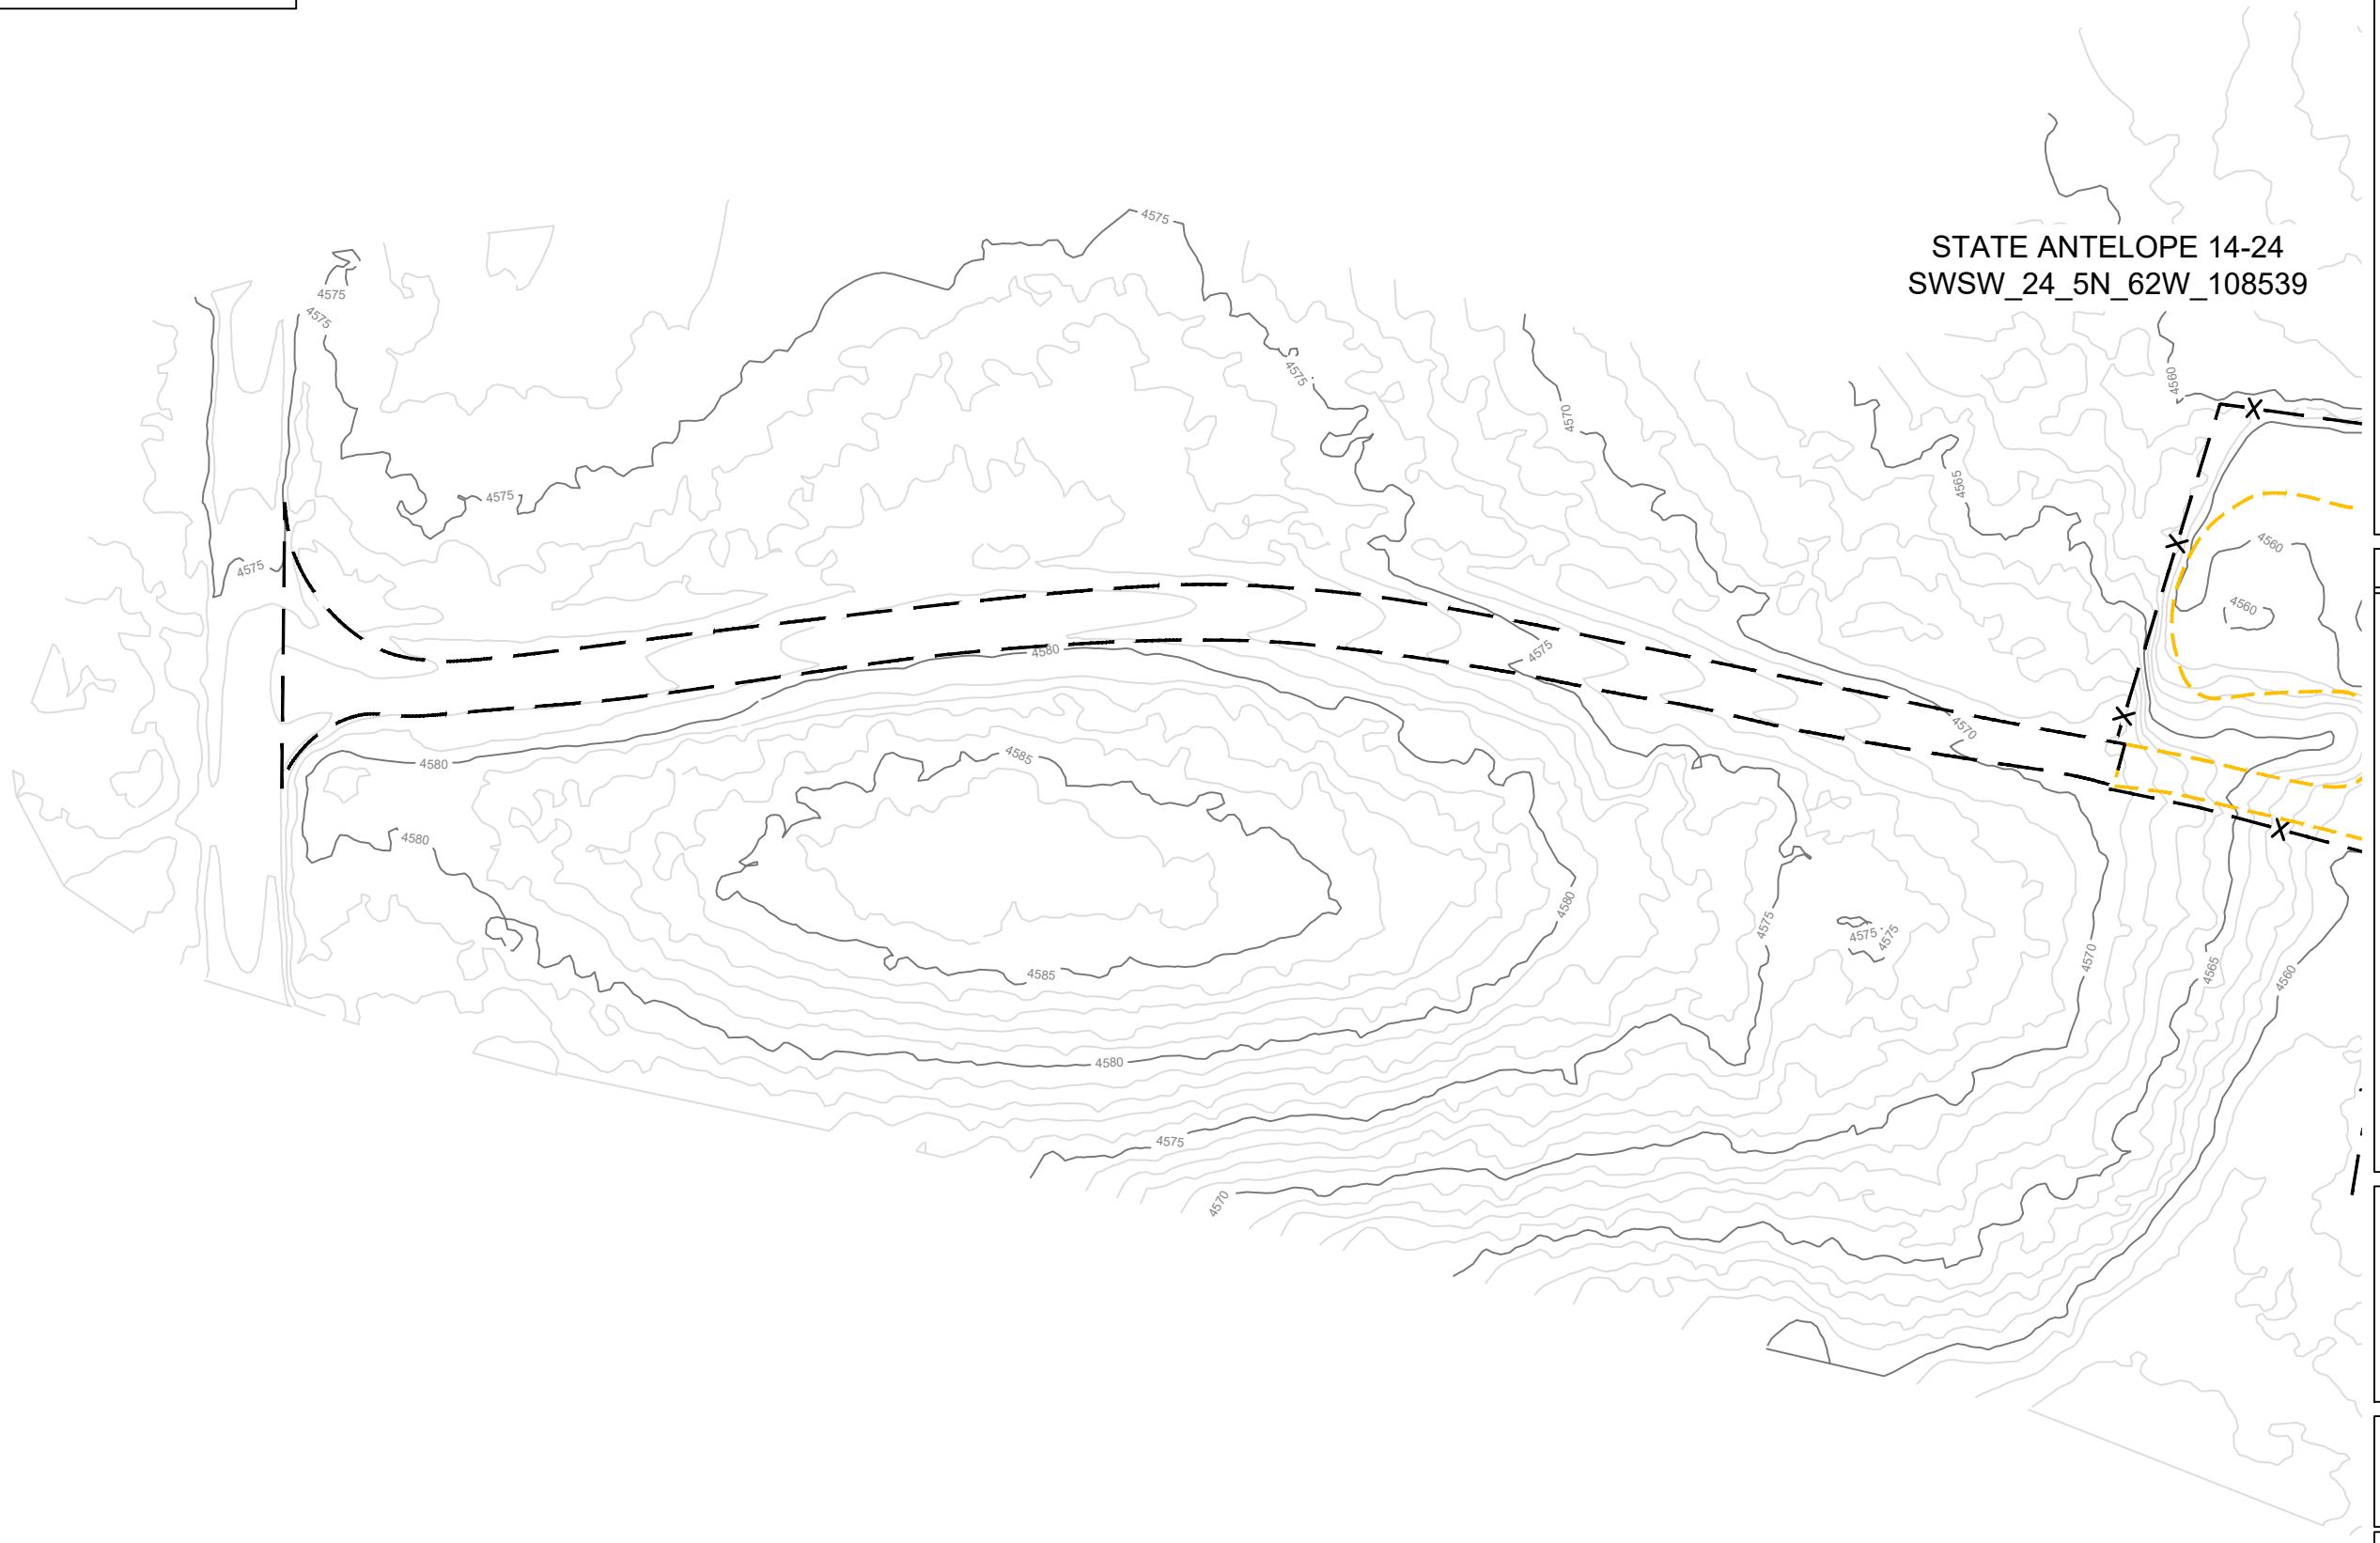

NOTES

UPDATED TOPO DATA COLLECTED BY RPG RESOURCES BY USE OF UAV IN AUGUST, 2021

AREA INSIDE FENCE: 3.08 ACRES
INT. RECLAMATION PAD FOOTPRINT AREA: 1.91 ACRES
ACCESS ROAD SURFACE AREA: 0.46 ACRES

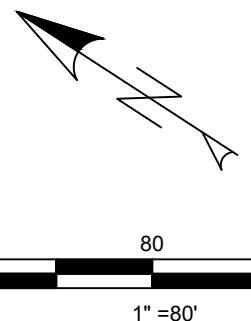

LEGEND

- 4600 — MAJOR CONTOUR
- 4580 — MINOR CONTOUR
- - - - ACCESS ROAD
- - - - FENCE LINE
- - - - PAD EDGE



**STATE ANTELOPE 14-24
AS-BUILT EXHIBITS**

SECTION 24, TOWNSHIP 5N, RANGE 62W,
WELD COUNTY, COLORADO

SHEET NAME:	SHEET NO.
ACCESS RD TOPO	4 OF 4