

AERIAL AS-BUILT PAD LAYOUT




NOTES

UPDATED AERIAL ORTHOIMAGERY COLLECTED BY RPG RESOURCES BY USE OF UAV IN AUGUST, 2021

AREA INSIDE FENCE: 2.80 ACRES

INT. RECLAMATION PAD FOOTPRINT AREA: 1.12 ACRES

ACCESS ROAD SURFACE AREA: 0.05 ACRES

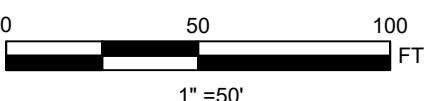

LEGEND

- ACCESS ROAD
- FENCE LINE
- PAD EDGE
- WELL HEAD




STATE ANTELOPE 11-13HZ AS-BUILT EXHIBITS

SECTION 13, TOWNSHIP 5N, RANGE 62W,
WELD COUNTY, COLORADO

SHEET NAME:	SHEET NO.
AERIAL IMAGERY	1 OF 2

TOPO AS-BUILT PAD LAYOUT

STATE ANTELOPE 11-13HZ
NWNW 13 5N 62W 108516

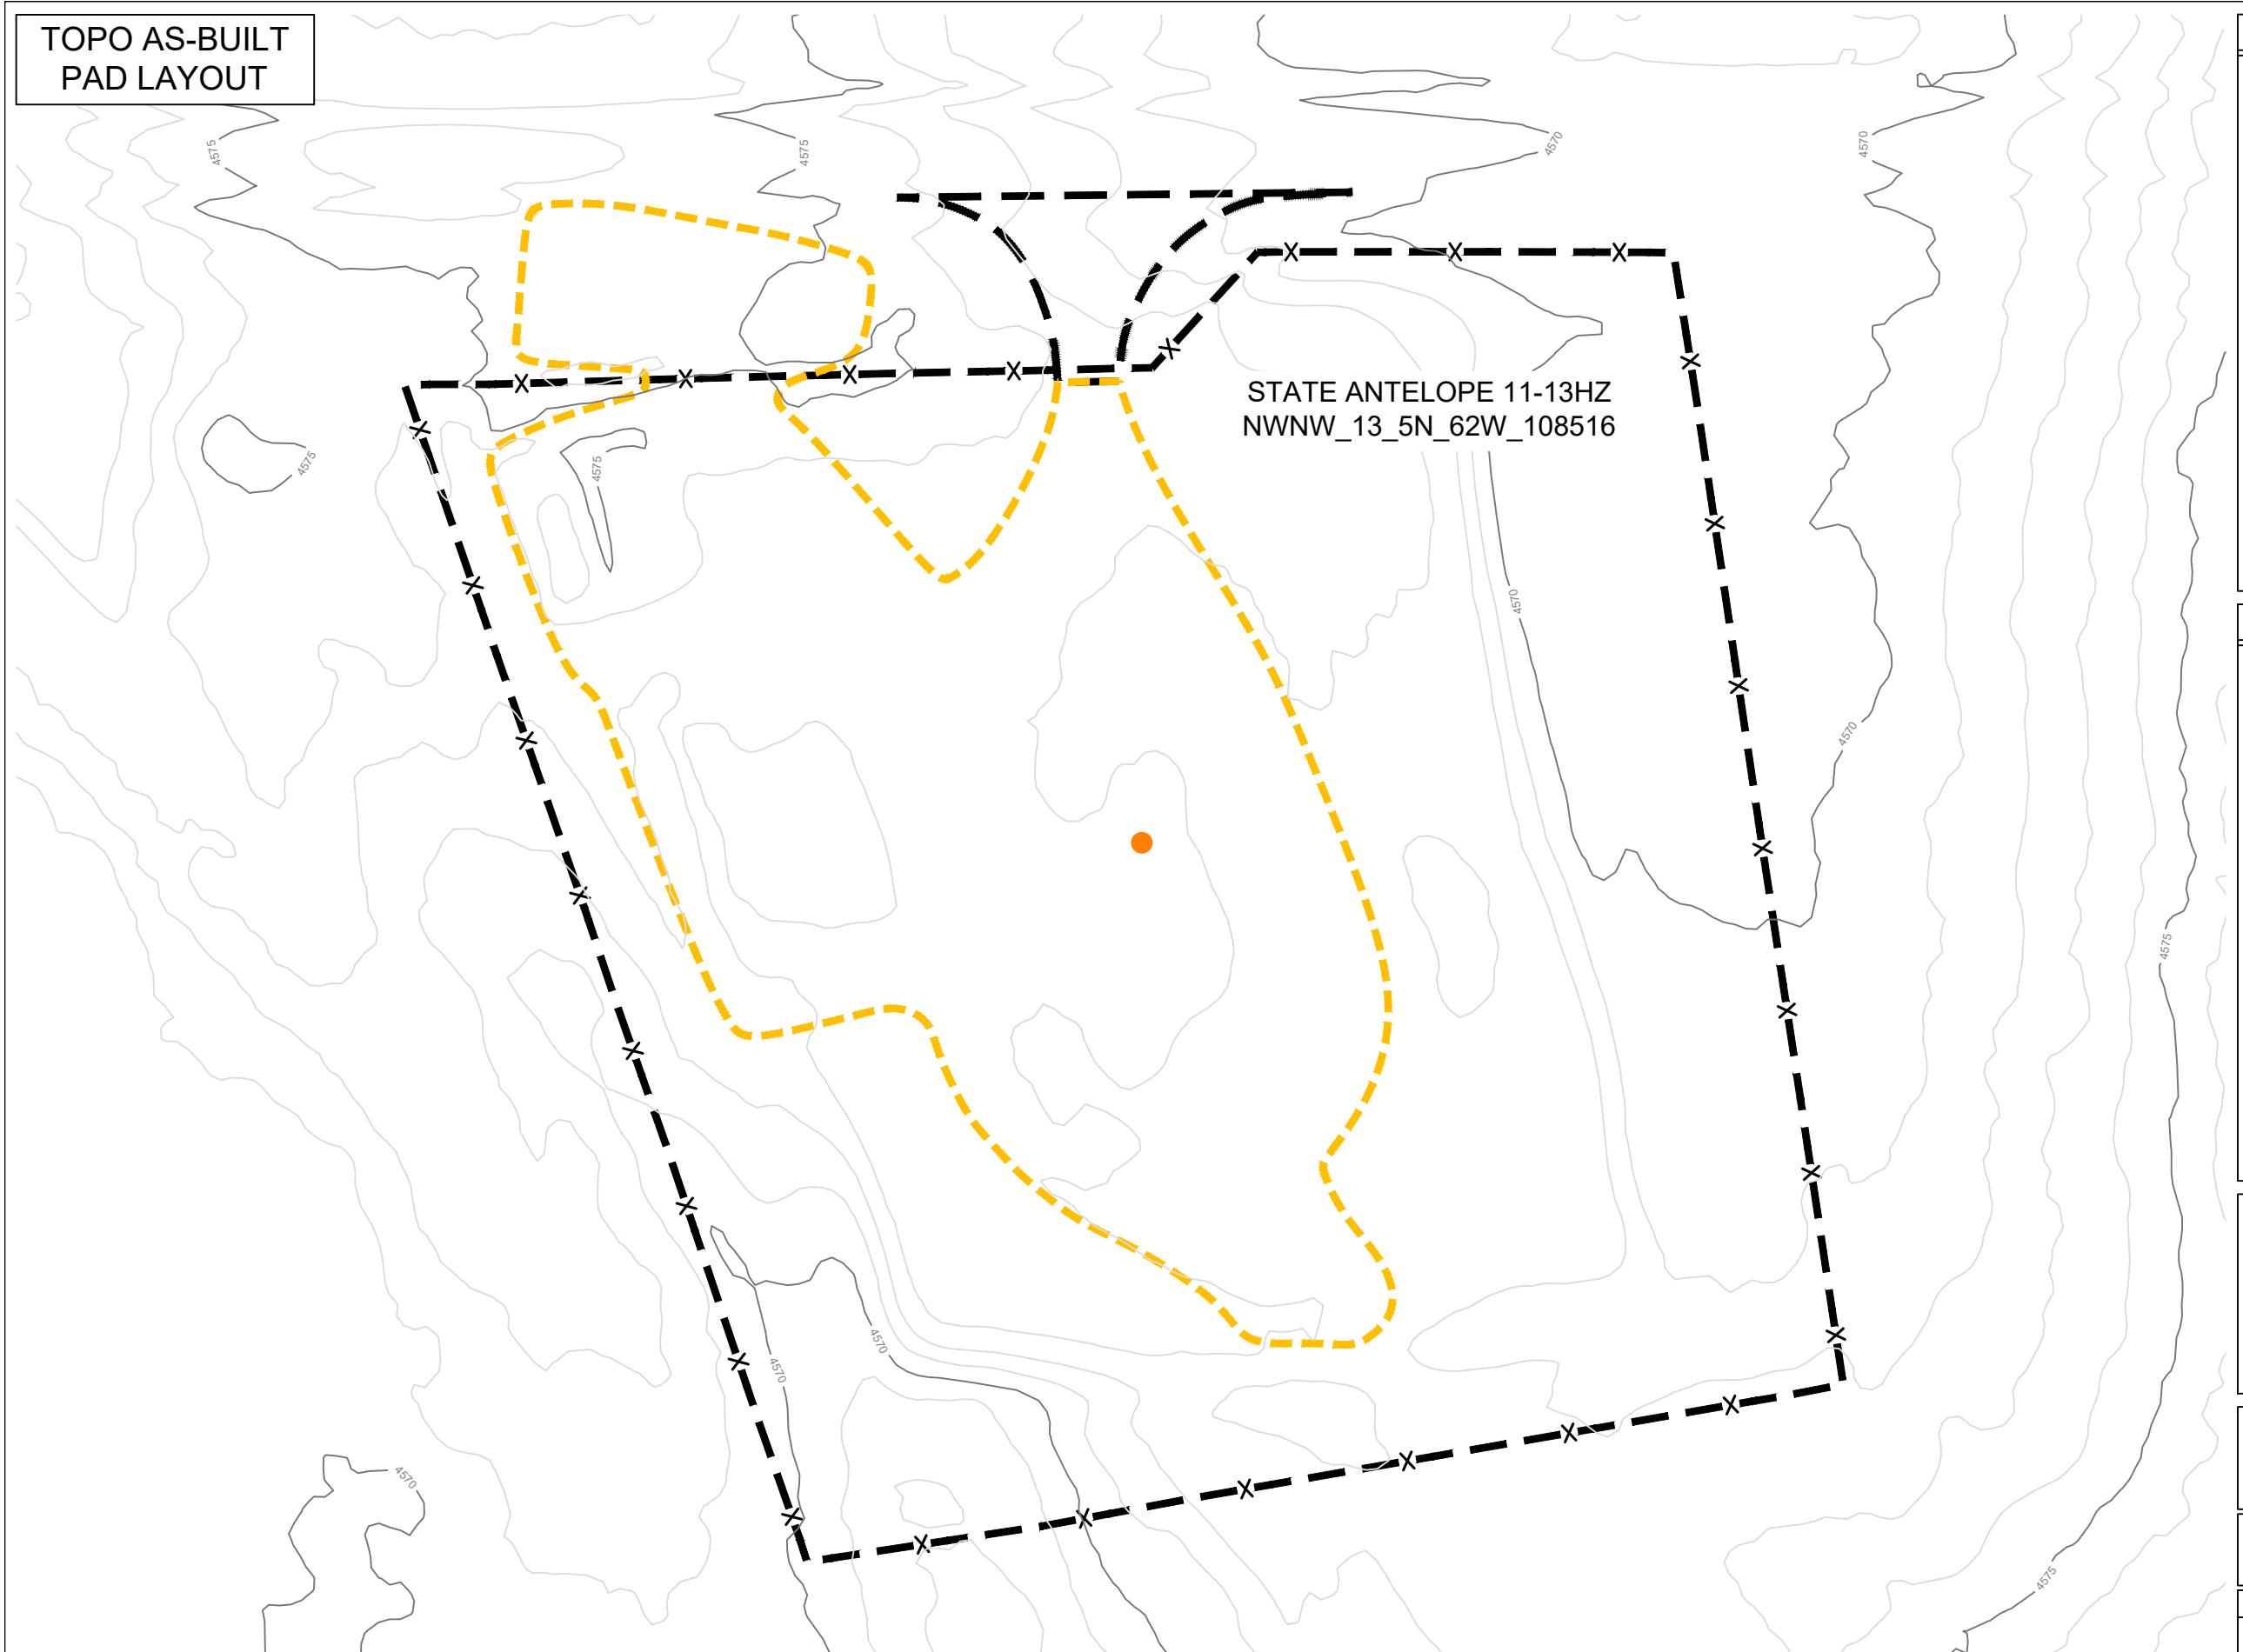


NOTES

**UPDATED TOPO DATA COLLECTED BY RPG
RESOURCES BY USE OF UAV IN AUGUST, 2021**

AREA INSIDE FENCE: 2.80 ACRES

INT. RECLAMATION PAD FOOTPRINT AREA: 1.12 ACRES

ACCESS ROAD SURFACE AREA: 0.05 ACRES

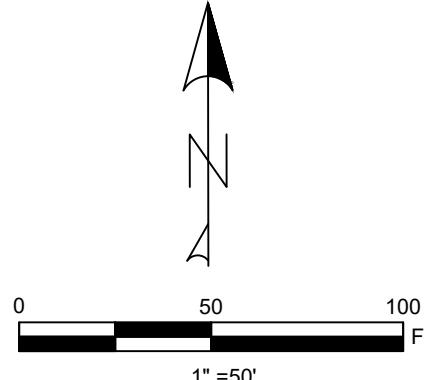

LEGEND

- The legend consists of five entries, each showing a symbol followed by its name:

 - MAJOR CONTOUR**: Represented by a solid horizontal line.
 - MINOR CONTOUR**: Represented by a dashed horizontal line.
 - ACCESS ROAD**: Represented by a line with short horizontal dashes.
 - FENCE LINE**: Represented by a line with 'X' marks.
 - PAD EDGE**: Represented by a yellow dashed line.
 - WELL HEAD**: Represented by an orange circle.



**STATE ANTELOPE 11-13HZ
AS-BUILT EXHIBITS**

**SECTION 13, TOWNSHIP 5N, RANGE 62W,
WELD COUNTY, COLORADO**

SHEET NAME:	SHEET NO.
TOPO OVERVIEW	2 OF 2