

AERIAL AS-BUILT PAD LAYOUT




NOTES

UPDATED AERIAL ORTHOIMAGERY COLLECTED BY RPG RESOURCES BY USE OF UAV IN SEPTEMBER, 2021

AREA INSIDE FENCE: 6.15 ACRES

INT. RECLAMATION PAD FOOTPRINT AREA: 2.79 ACRES

ACCESS ROAD SURFACE AREA: 0.87 ACRES

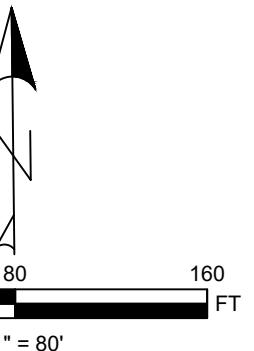

LEGEND

- — — ACCESS ROAD
- x-x-x- FENCE LINE
- - - PAD EDGE
- WELL HEAD




STATE SEVENTY HOLES 21-6 AS-BUILT EXHIBITS

SECTION 6, TOWNSHIP 4N, RANGE 62W,
WELD COUNTY, COLORADO

SHEET NAME:	SHEET NO.
AERIAL IMAGERY	1 OF 8


**TOPO AS-BUILT
PAD LAYOUT**

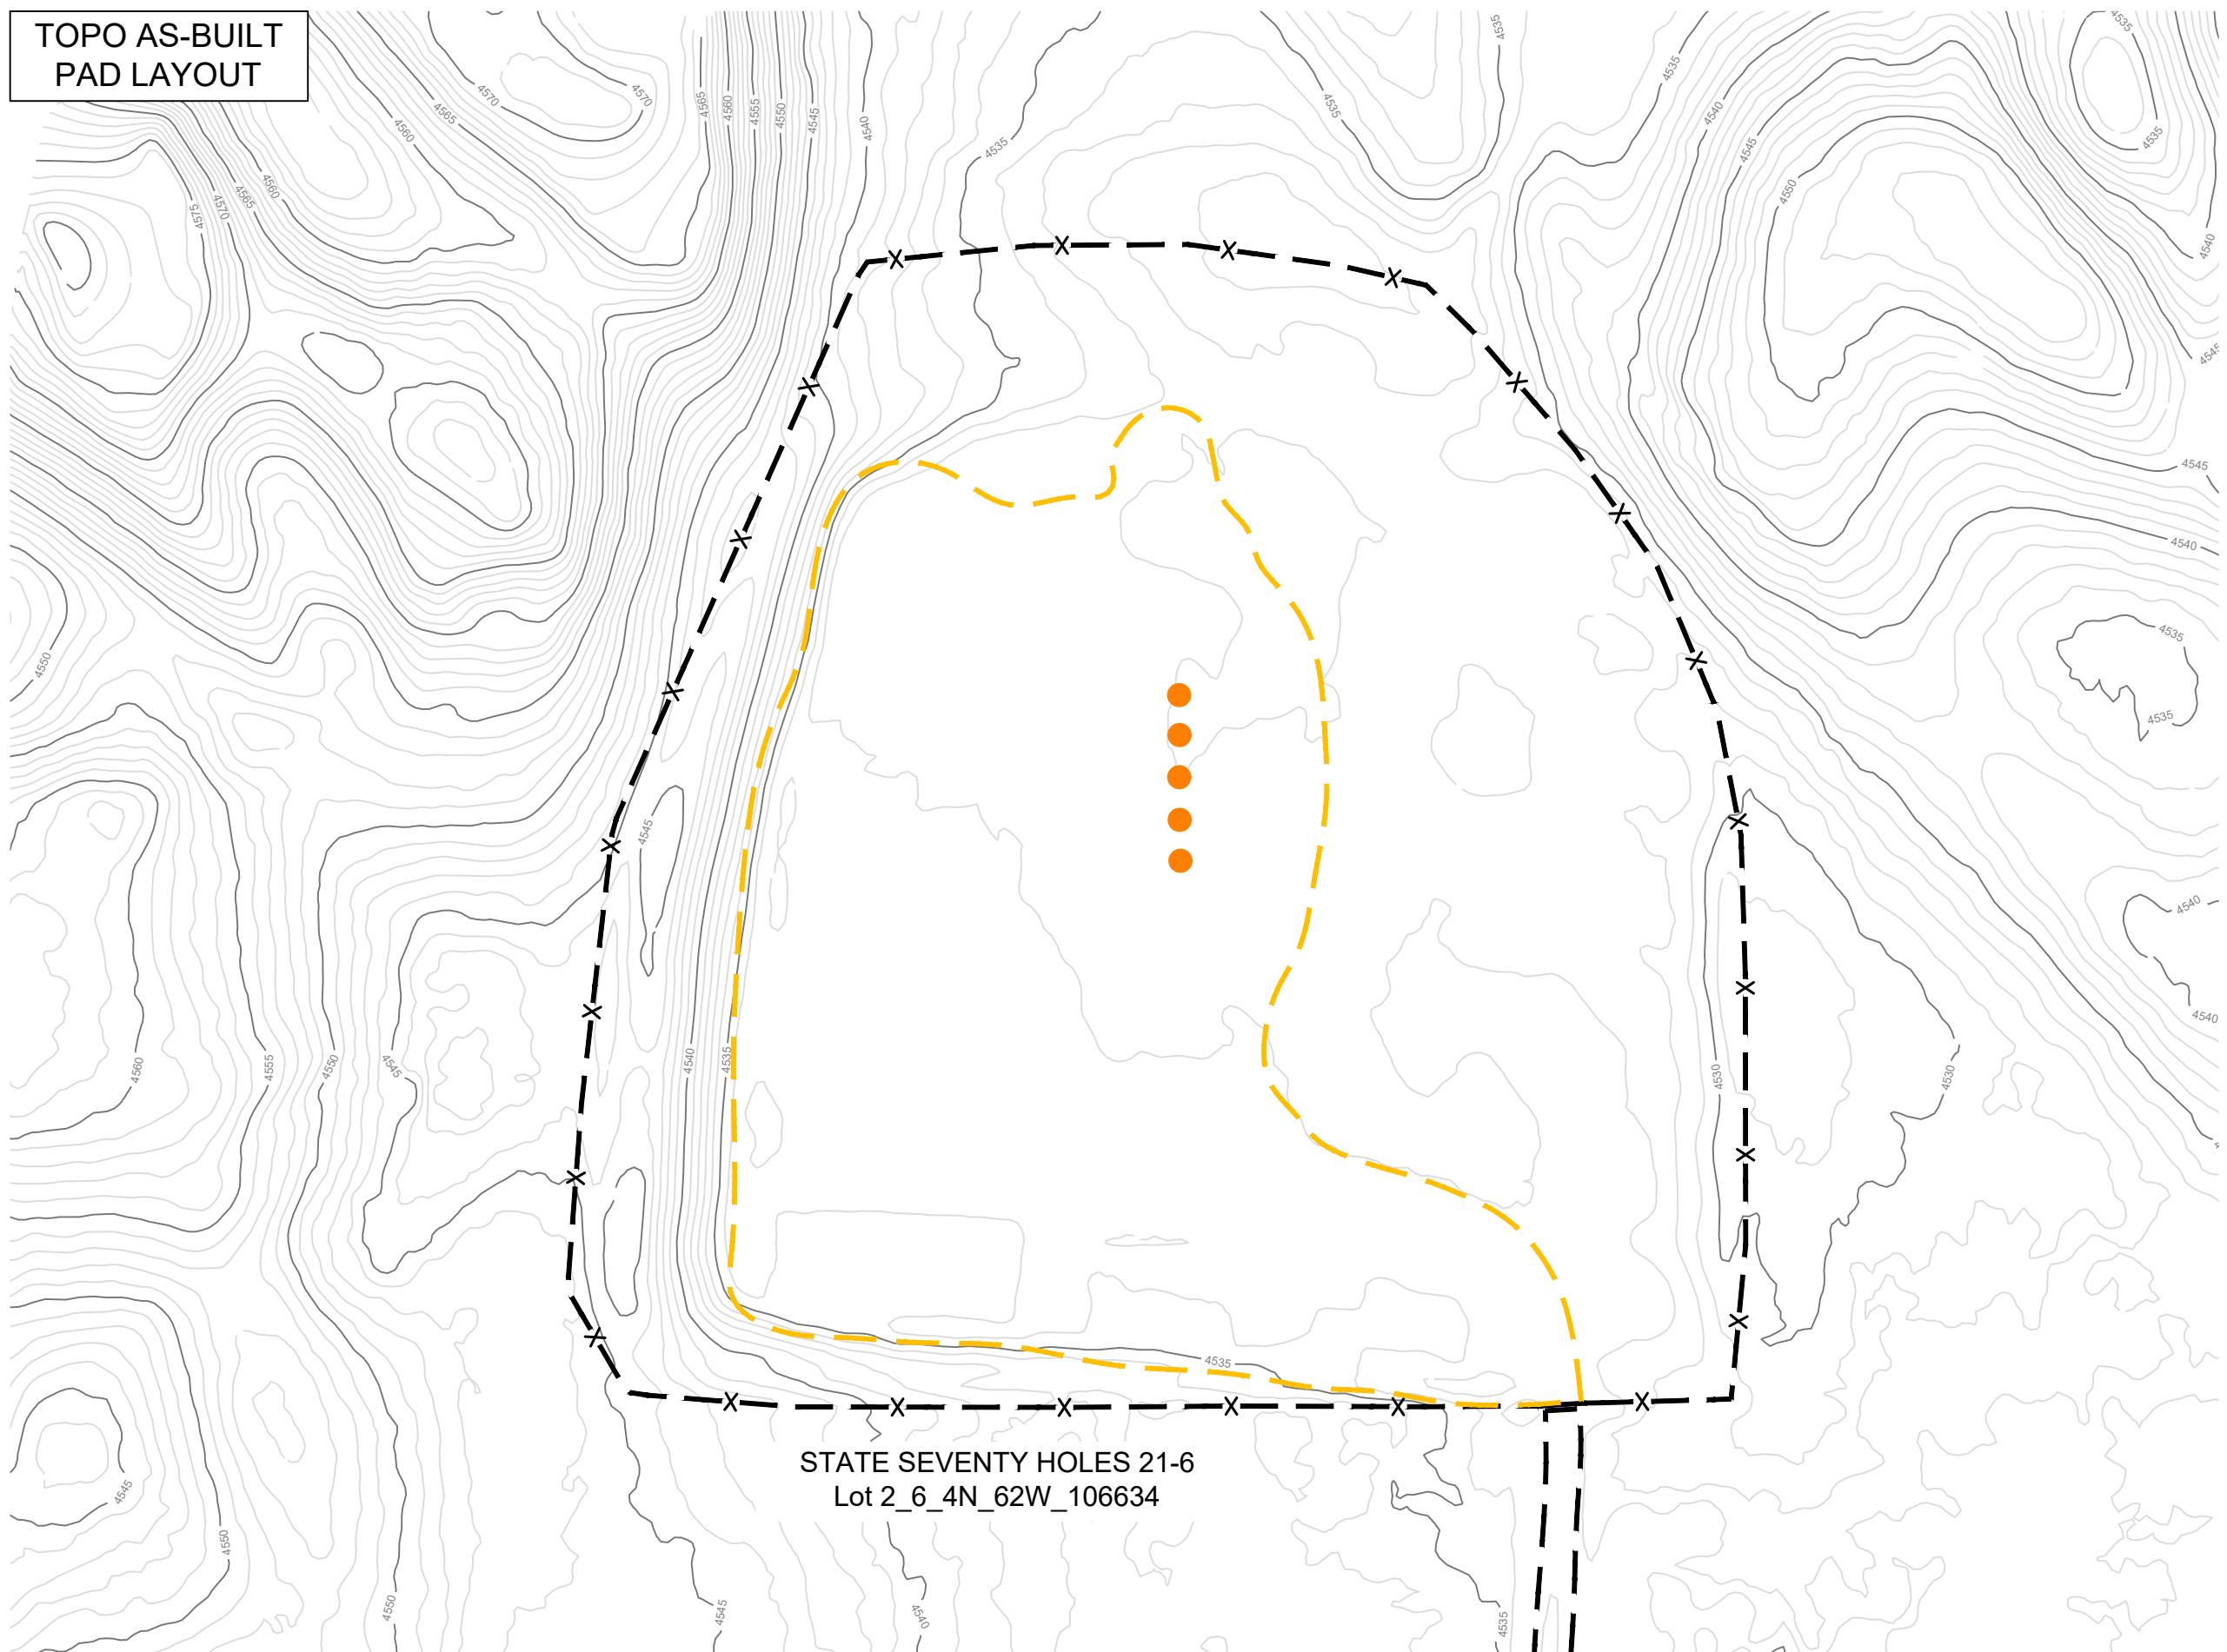

NOTES

**UPDATED TOPO DATA COLLECTED BY RPG
RESOURCES BY USE OF UAV IN SEPTEMBER, 2021**

AREA INSIDE FENCE: 6.15 ACRES
INT. RECLAMATION PAD FOOTPRINT AREA: 2.79 ACRES
ACCESS ROAD SURFACE AREA: 0.87 ACRES

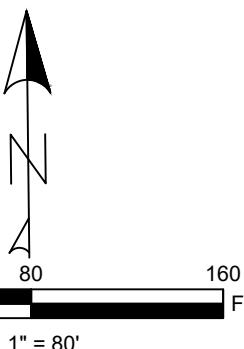

LEGEND

- 4505 — MAJOR CONTOUR
- 4540 — MINOR CONTOUR
- X — ACCESS ROAD
- X — FENCE LINE
- Y — PAD EDGE
- WELL HEAD




**STATE SEVENTY HOLES 21-6
AS-BUILT EXHIBITS**

SECTION 6, TOWNSHIP 4N, RANGE 62W,
WELD COUNTY, COLORADO



SHEET NAME:	SHEET NO.
TOPO OVERVIEW	2 OF 8

AERIAL AS-BUILT
ACCESS ROAD

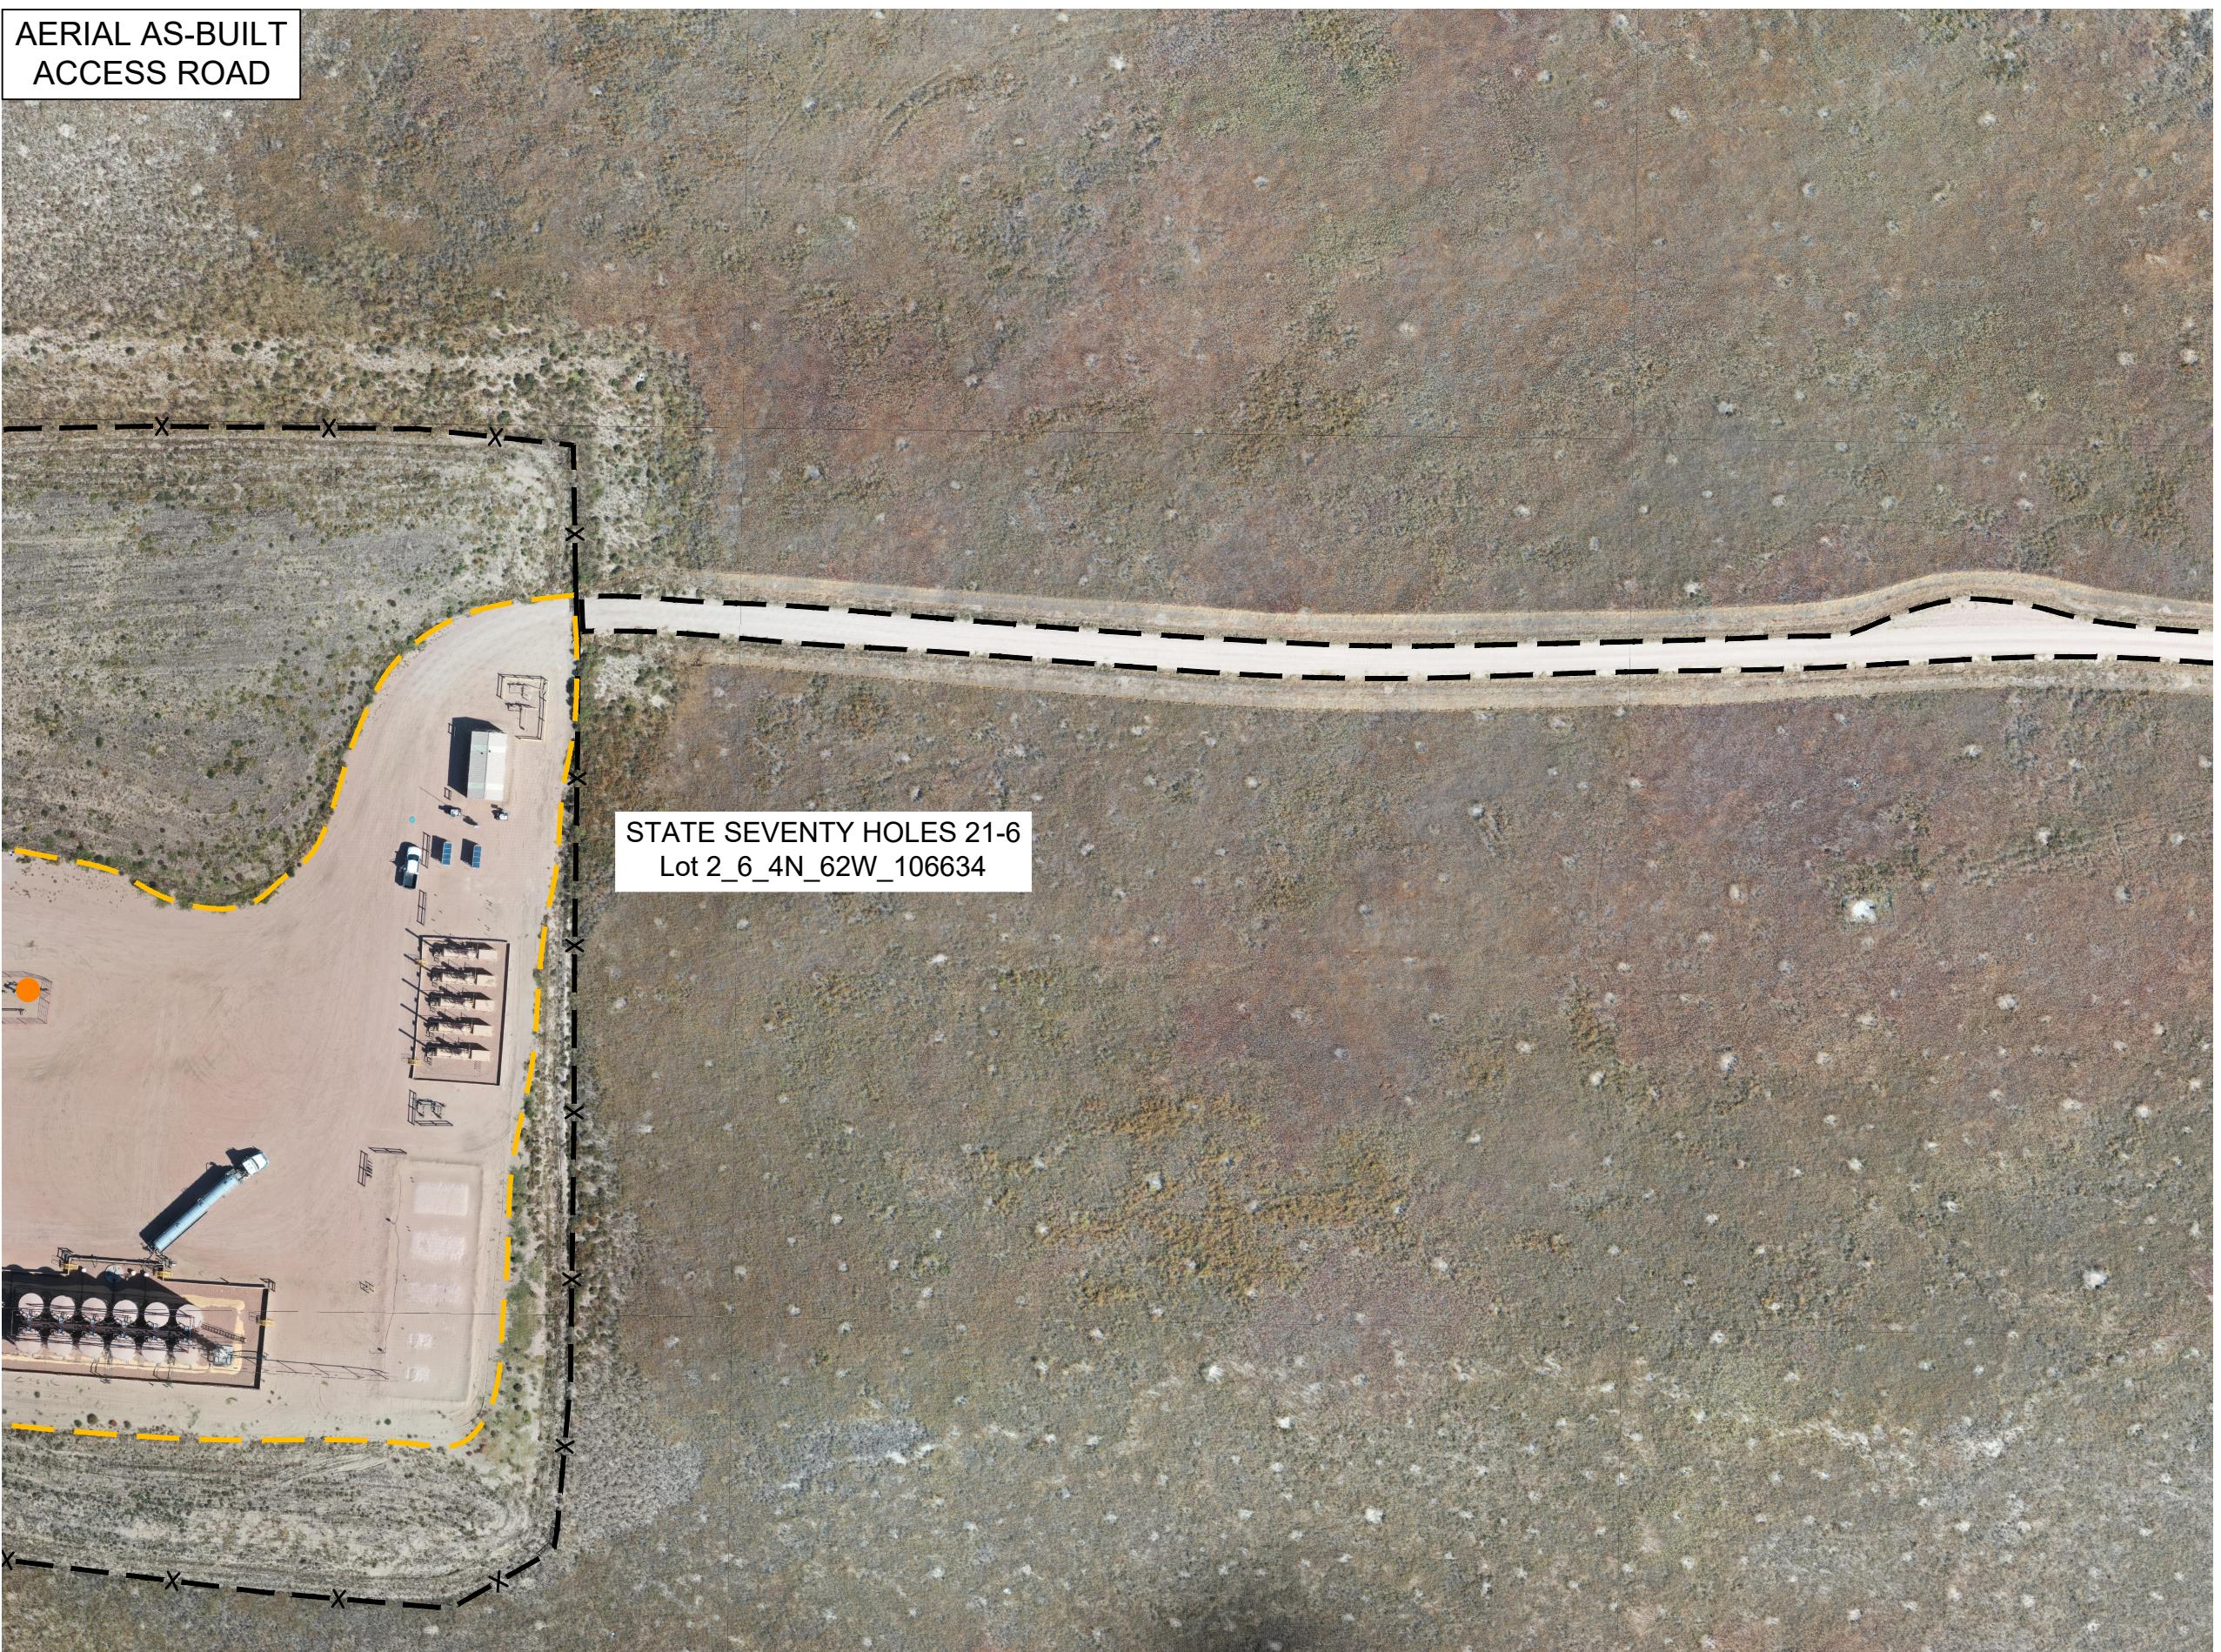

NOTES

UPDATED AERIAL ORTHOIMAGERY COLLECTED BY RPG RESOURCES BY USE OF UAV IN SEPTEMBER, 2021
PERMITTED DISTURBANCE AREA: 5.80 ACRES
AREA INSIDE FENCE: 6.15 ACRES
INT. RECLAMATION PAD FOOTPRINT AREA: 2.79 ACRES
ACCESS ROAD SURFACE AREA: 0.87 ACRES

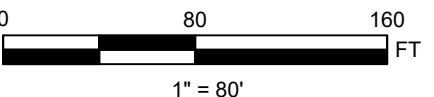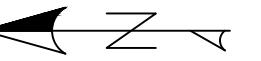

LEGEND


- ACCESS ROAD
- x-x-x-x FENCE LINE
- PAD EDGE
- WELL HEAD



STATE SEVENTY HOLES 21-6
AS-BUILT EXHIBITS

SECTION 6, TOWNSHIP 4N, RANGE 62W, WELD COUNTY, COLORADO	SHEET NAME:	SHEET NO.
ACCESS ROAD IMAGERY		3 OF 8

**TOPO AS-BUILT
ACCESS ROAD**

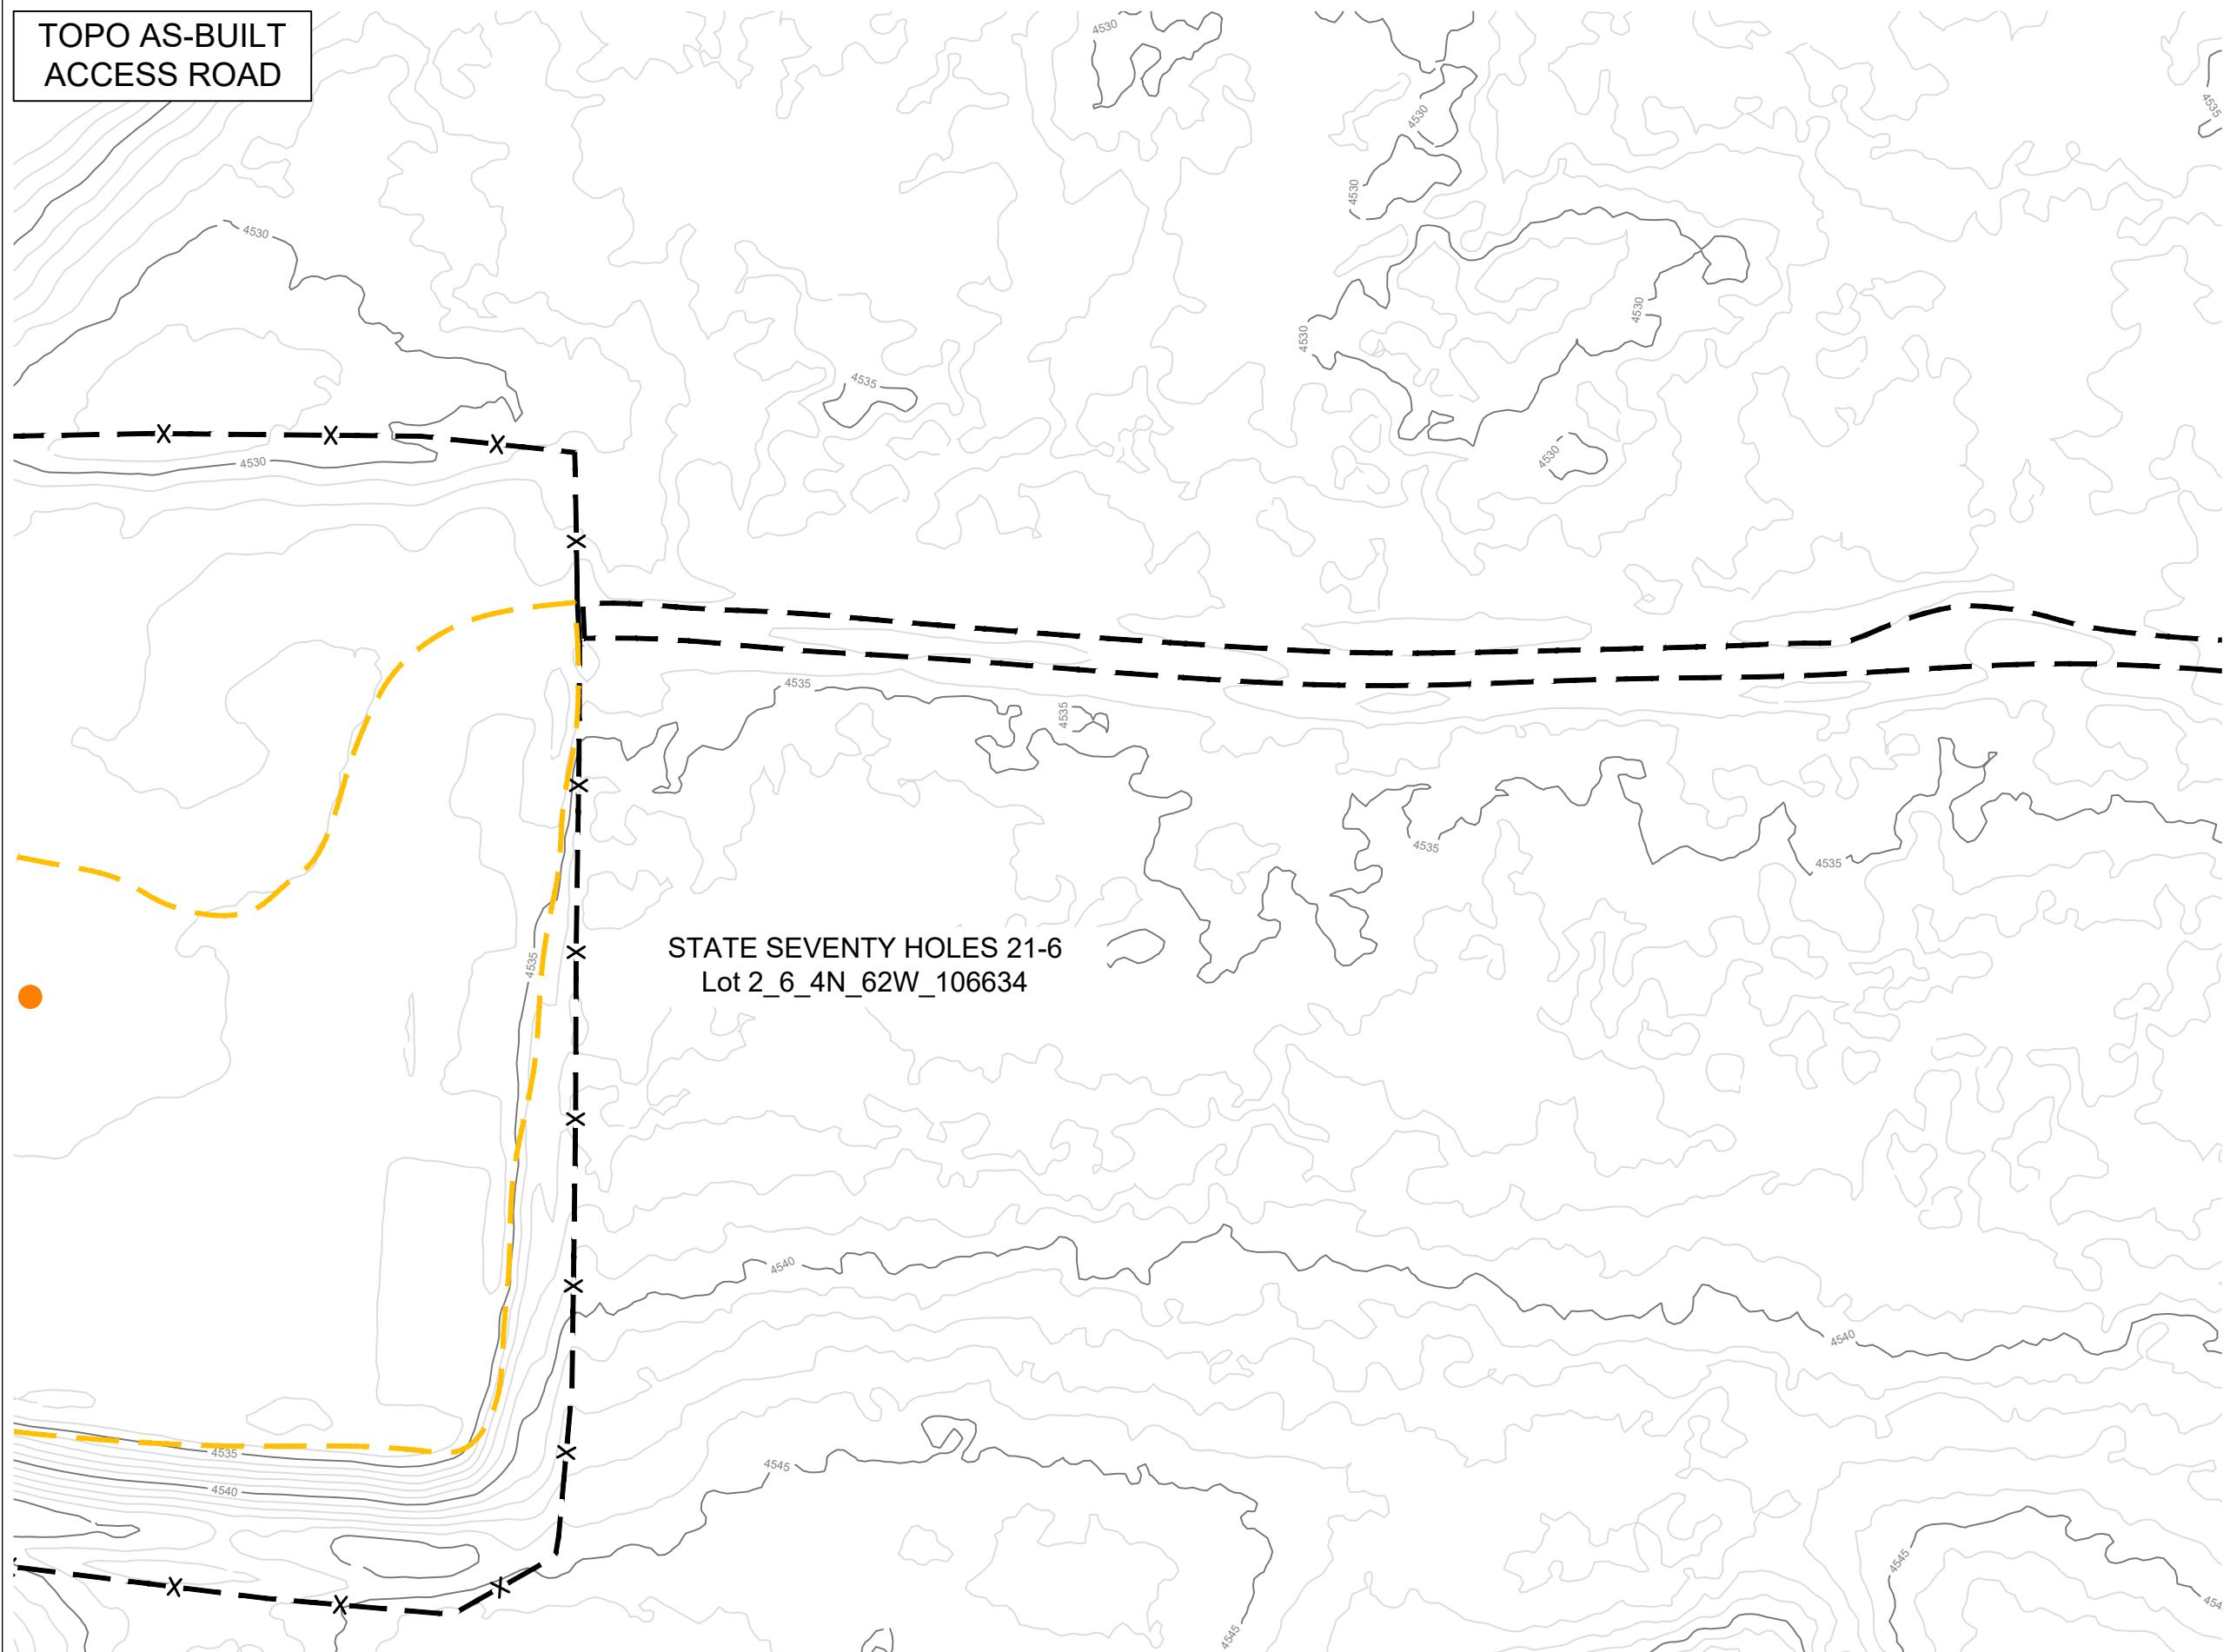

NOTES



**UPDATED TOPO DATA COLLECTED BY RPG
RESOURCES BY USE OF UAV IN SEPTEMBER, 2021**

PERMITTED DISTURBANCE AREA: 5.80 ACRES

AREA INSIDE FENCE: 6.15 ACRES

INT. RECLAMATION PAD FOOTPRINT AREA: 2.79 ACRES

ACCESS ROAD SURFACE AREA: 0.87 ACRES

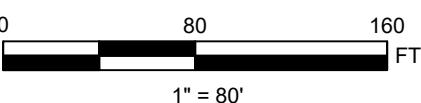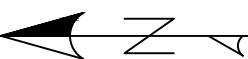

LEGEND

- 4505 — MAJOR CONTOUR
- 4530 — MINOR CONTOUR
- — — ACCESS ROAD
- x-x- FENCE LINE
- — — PAD EDGE
- WELL HEAD



**STATE SEVENTY HOLES 21-6
AS-BUILT EXHIBITS**

SECTION 6, TOWNSHIP 4N, RANGE 62W,
WELD COUNTY, COLORADO



SHEET NAME:	SHEET NO.
ACCESS ROAD TOPO	4 OF 8

AERIAL AS-BUILT
ACCESS ROAD



NOTES

**UPDATED AERIAL ORTHOIMAGERY COLLECTED BY
RPG RESOURCES BY USE OF UAV IN SEPTEMBER,
2021**
PERMITTED DISTURBANCE AREA: 5.80 ACRES
AREA INSIDE FENCE: 6.15 ACRES
INT. RECLAMATION PAD FOOTPRINT AREA: 2.79 ACRES
ACCESS ROAD SURFACE AREA: 0.87 ACRES

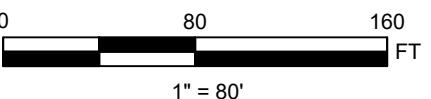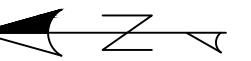

LEGEND

— — — — ACCESS ROAD



STATE SEVENTY HOLES 21-6
AS-BUILT EXHIBITS

SECTION 6, TOWNSHIP 4N, RANGE 62W,
WELD COUNTY, COLORADO

SHEET NAME:	SHEET NO.
ACCESS ROAD IMAGERY 2	5 OF 8

**TOPO AS-BUILT
ACCESS ROAD**



NOTES



**UPDATED TOPO DATA COLLECTED BY RPG
RESOURCES BY USE OF UAV IN SEPTEMBER, 2021**

PERMITTED DISTURBANCE AREA: 5.80 ACRES

AREA INSIDE FENCE: 6.15 ACRES

INT. RECLAMATION PAD FOOTPRINT AREA: 2.79 ACRES

ACCESS ROAD SURFACE AREA: 0.87 ACRES

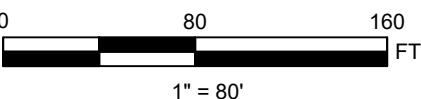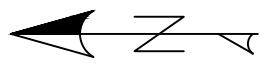

LEGEND

— 4505 — MAJOR CONTOUR

— 4530 — MINOR CONTOUR

- - - - - ACCESS ROAD



**STATE SEVENTY HOLES 21-6
AS-BUILT EXHIBITS**

SECTION 6, TOWNSHIP 4N, RANGE 62W,
WELD COUNTY, COLORADO



SHEET NAME:	SHEET NO.
ACCESS ROAD TOPO 2	6 OF 8

AERIAL AS-BUILT
ACCESS ROAD



NOTES

**UPDATED AERIAL ORTHOIMAGERY COLLECTED BY
RPG RESOURCES BY USE OF UAV IN SEPTEMBER,
2021**
PERMITTED DISTURBANCE AREA: 5.80 ACRES
AREA INSIDE FENCE: 6.15 ACRES
INT. RECLAMATION PAD FOOTPRINT AREA: 2.79 ACRES
ACCESS ROAD SURFACE AREA: 0.87 ACRES

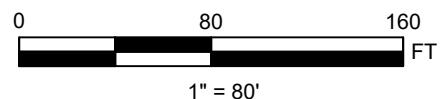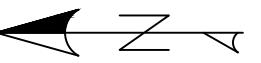

LEGEND

— — — — ACCESS ROAD




STATE SEVENTY HOLES 21-6
AS-BUILT EXHIBITS

SECTION 6, TOWNSHIP 4N, RANGE 62W,
WELD COUNTY, COLORADO

SHEET NAME:	SHEET NO.
ACCESS ROAD IMAGERY 3	7 OF 8

**TOPO AS-BUILT
ACCESS ROAD**

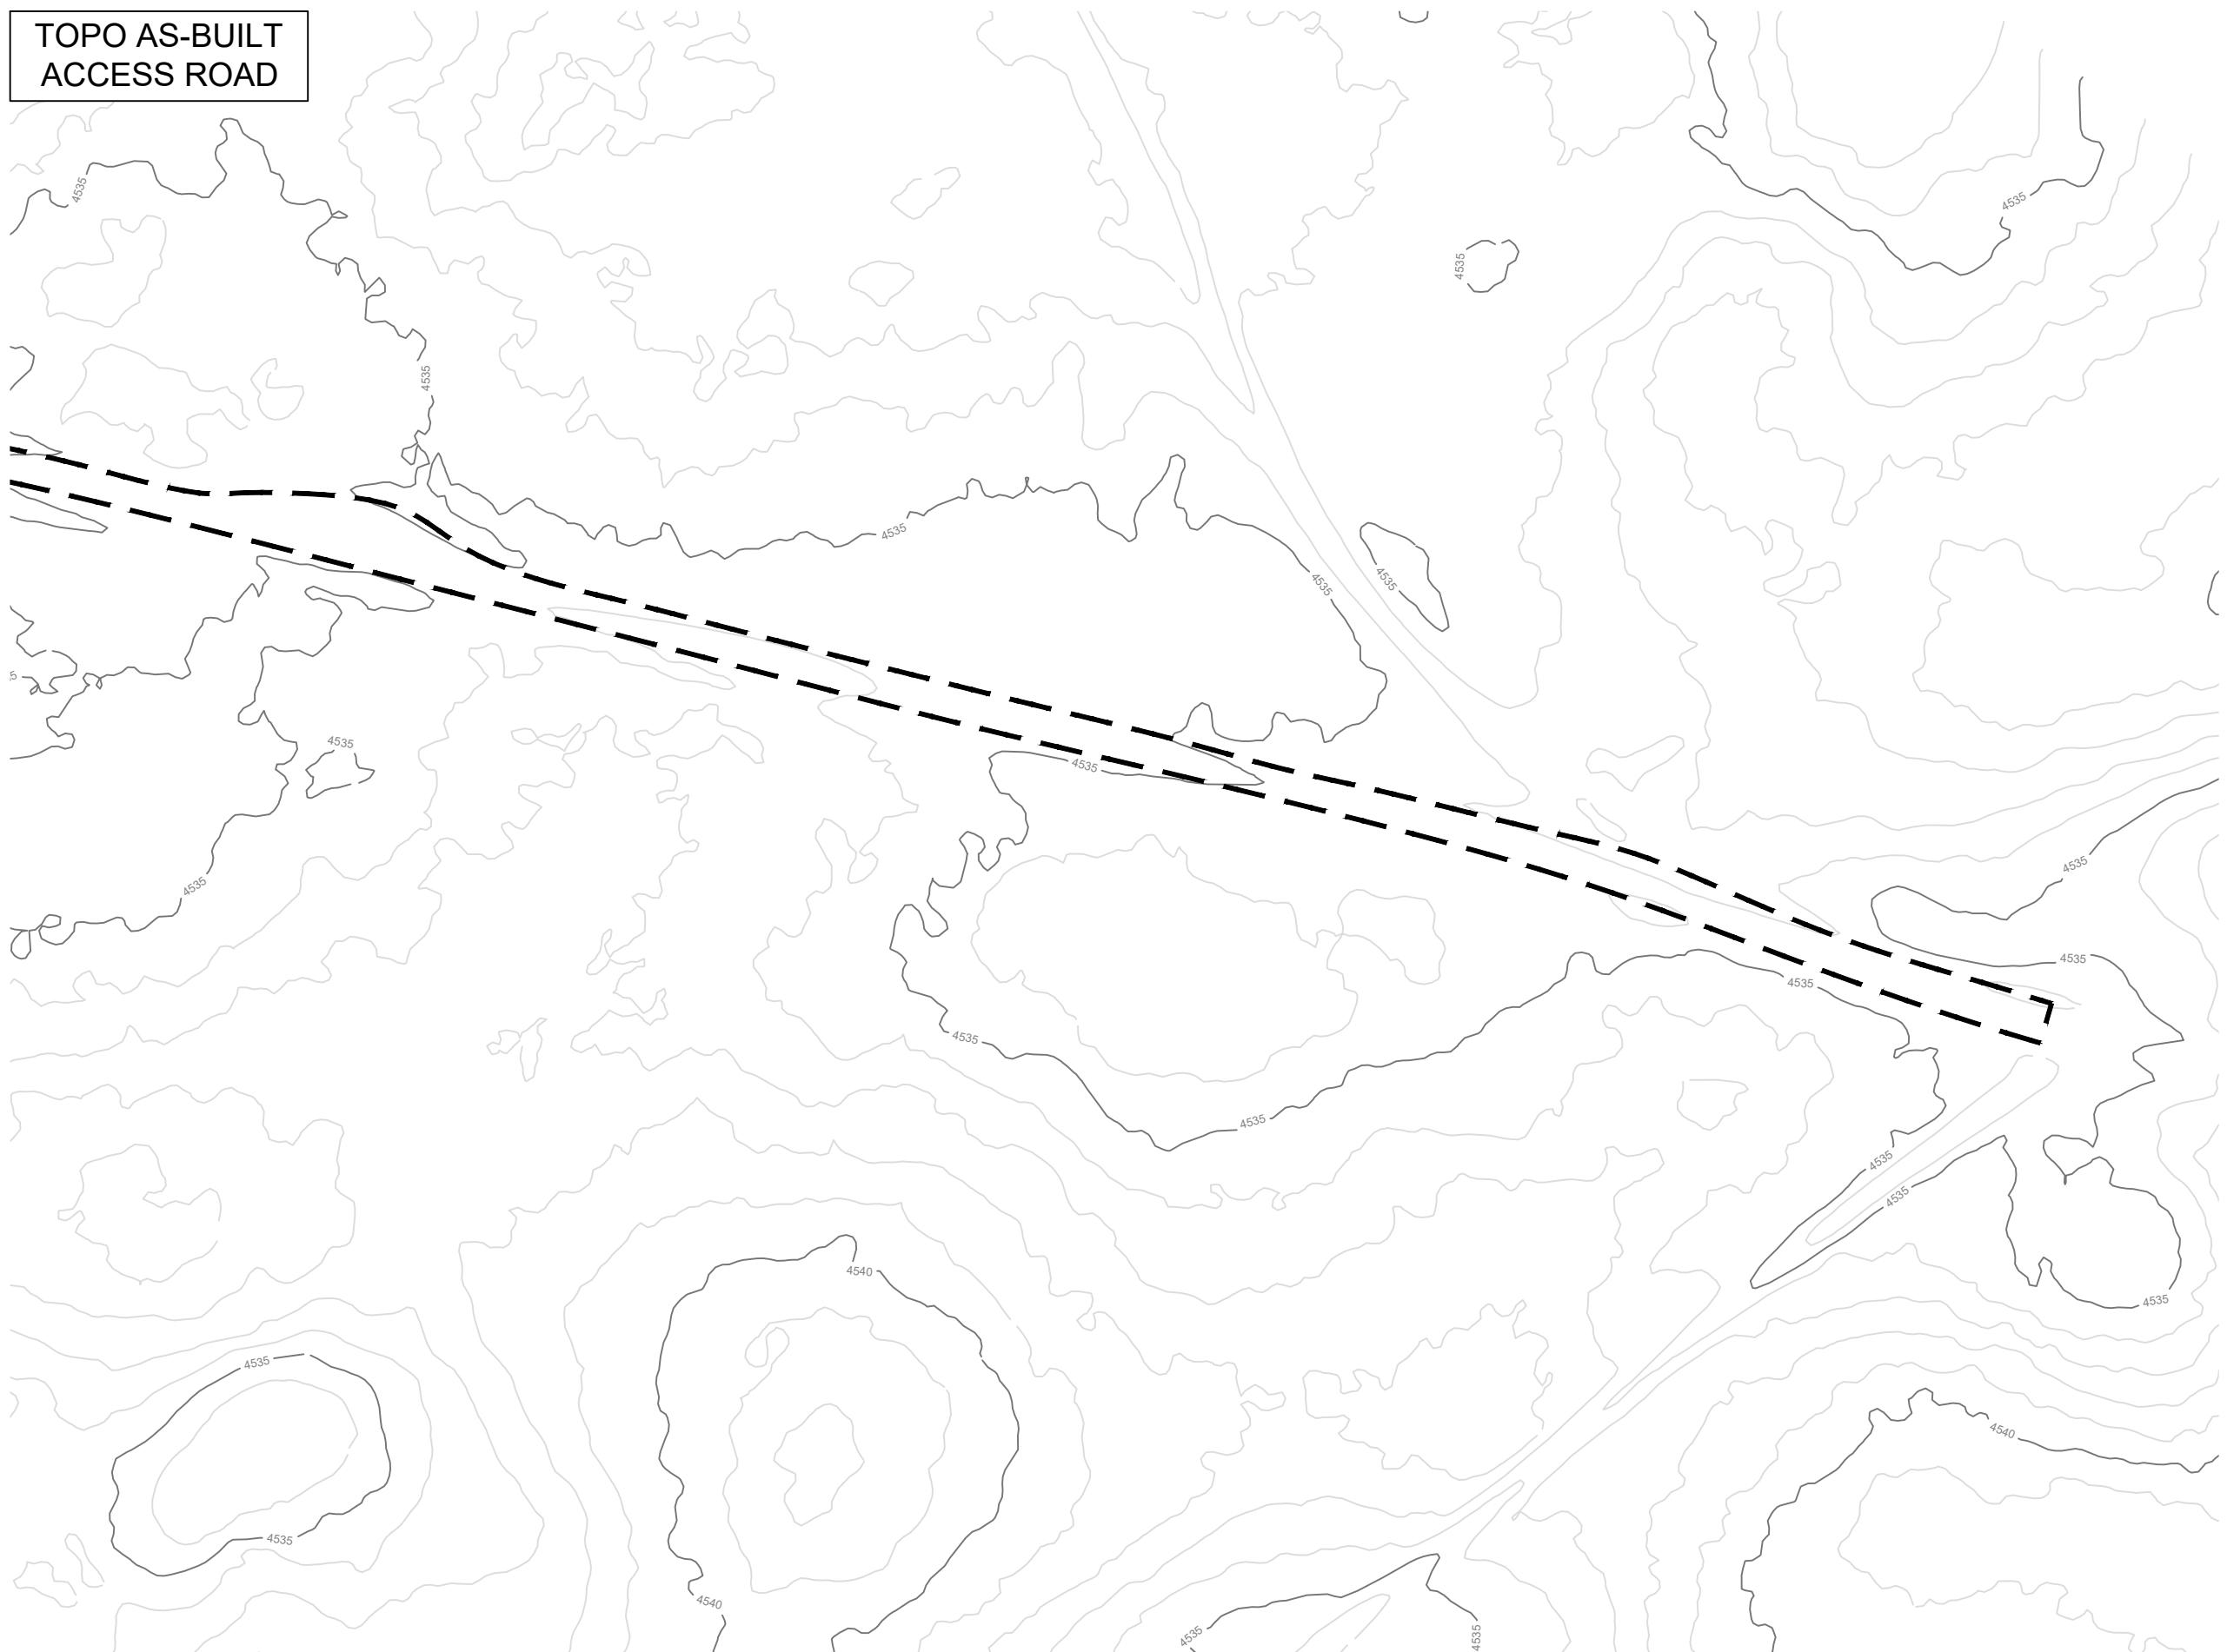

NOTES



**UPDATED TOPO DATA COLLECTED BY RPG
RESOURCES BY USE OF UAV IN SEPTEMBER, 2021**

PERMITTED DISTURBANCE AREA: 5.80 ACRES

AREA INSIDE FENCE: 6.15 ACRES

INT. RECLAMATION PAD FOOTPRINT AREA: 2.79 ACRES

ACCESS ROAD SURFACE AREA: 0.87 ACRES

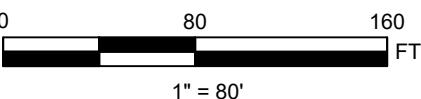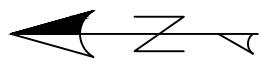

LEGEND

— 4505 — MAJOR CONTOUR

— 4535 — MINOR CONTOUR

- - - - - ACCESS ROAD



**STATE SEVENTY HOLES 21-6
AS-BUILT EXHIBITS**

SECTION 6, TOWNSHIP 4N, RANGE 62W,
WELD COUNTY, COLORADO

SHEET NAME:	SHEET NO.
ACCESS ROAD TOPO 3	8 OF 8