

AERIAL AS-BUILT PAD LAYOUT




NOTES

**UPDATED AERIAL ORTHOIMAGERY & TOPO DATA
COLLECTED BY RPG RESOURCES BY USE OF UAV IN
AUGUST, 2021**

AREA INSIDE FENCE: 5.19 ACRES

PAD AREA: 1.07 ACRES

ACCESS ROAD AREA: 0.12 ACRES

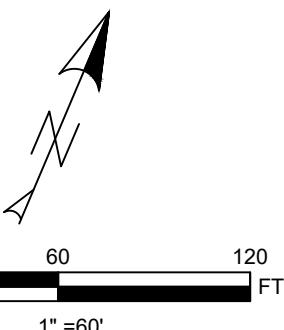

LEGEND

- X — X — FENCE LINE
- - - - PAD EDGE
- - - - ACCESS ROAD
- WELLHEAD




STATE ANTELOPE 41-15HZ AS-BUILT EXHIBITS

SECTION 15, TOWNSHIP 5N, RANGE 62W,
WELD COUNTY, COLORADO

SHEET NAME:	SHEET NO.
AERIAL IMAGERY	1 OF 4

**TOPO AS-BUILT
PAD LAYOUT**

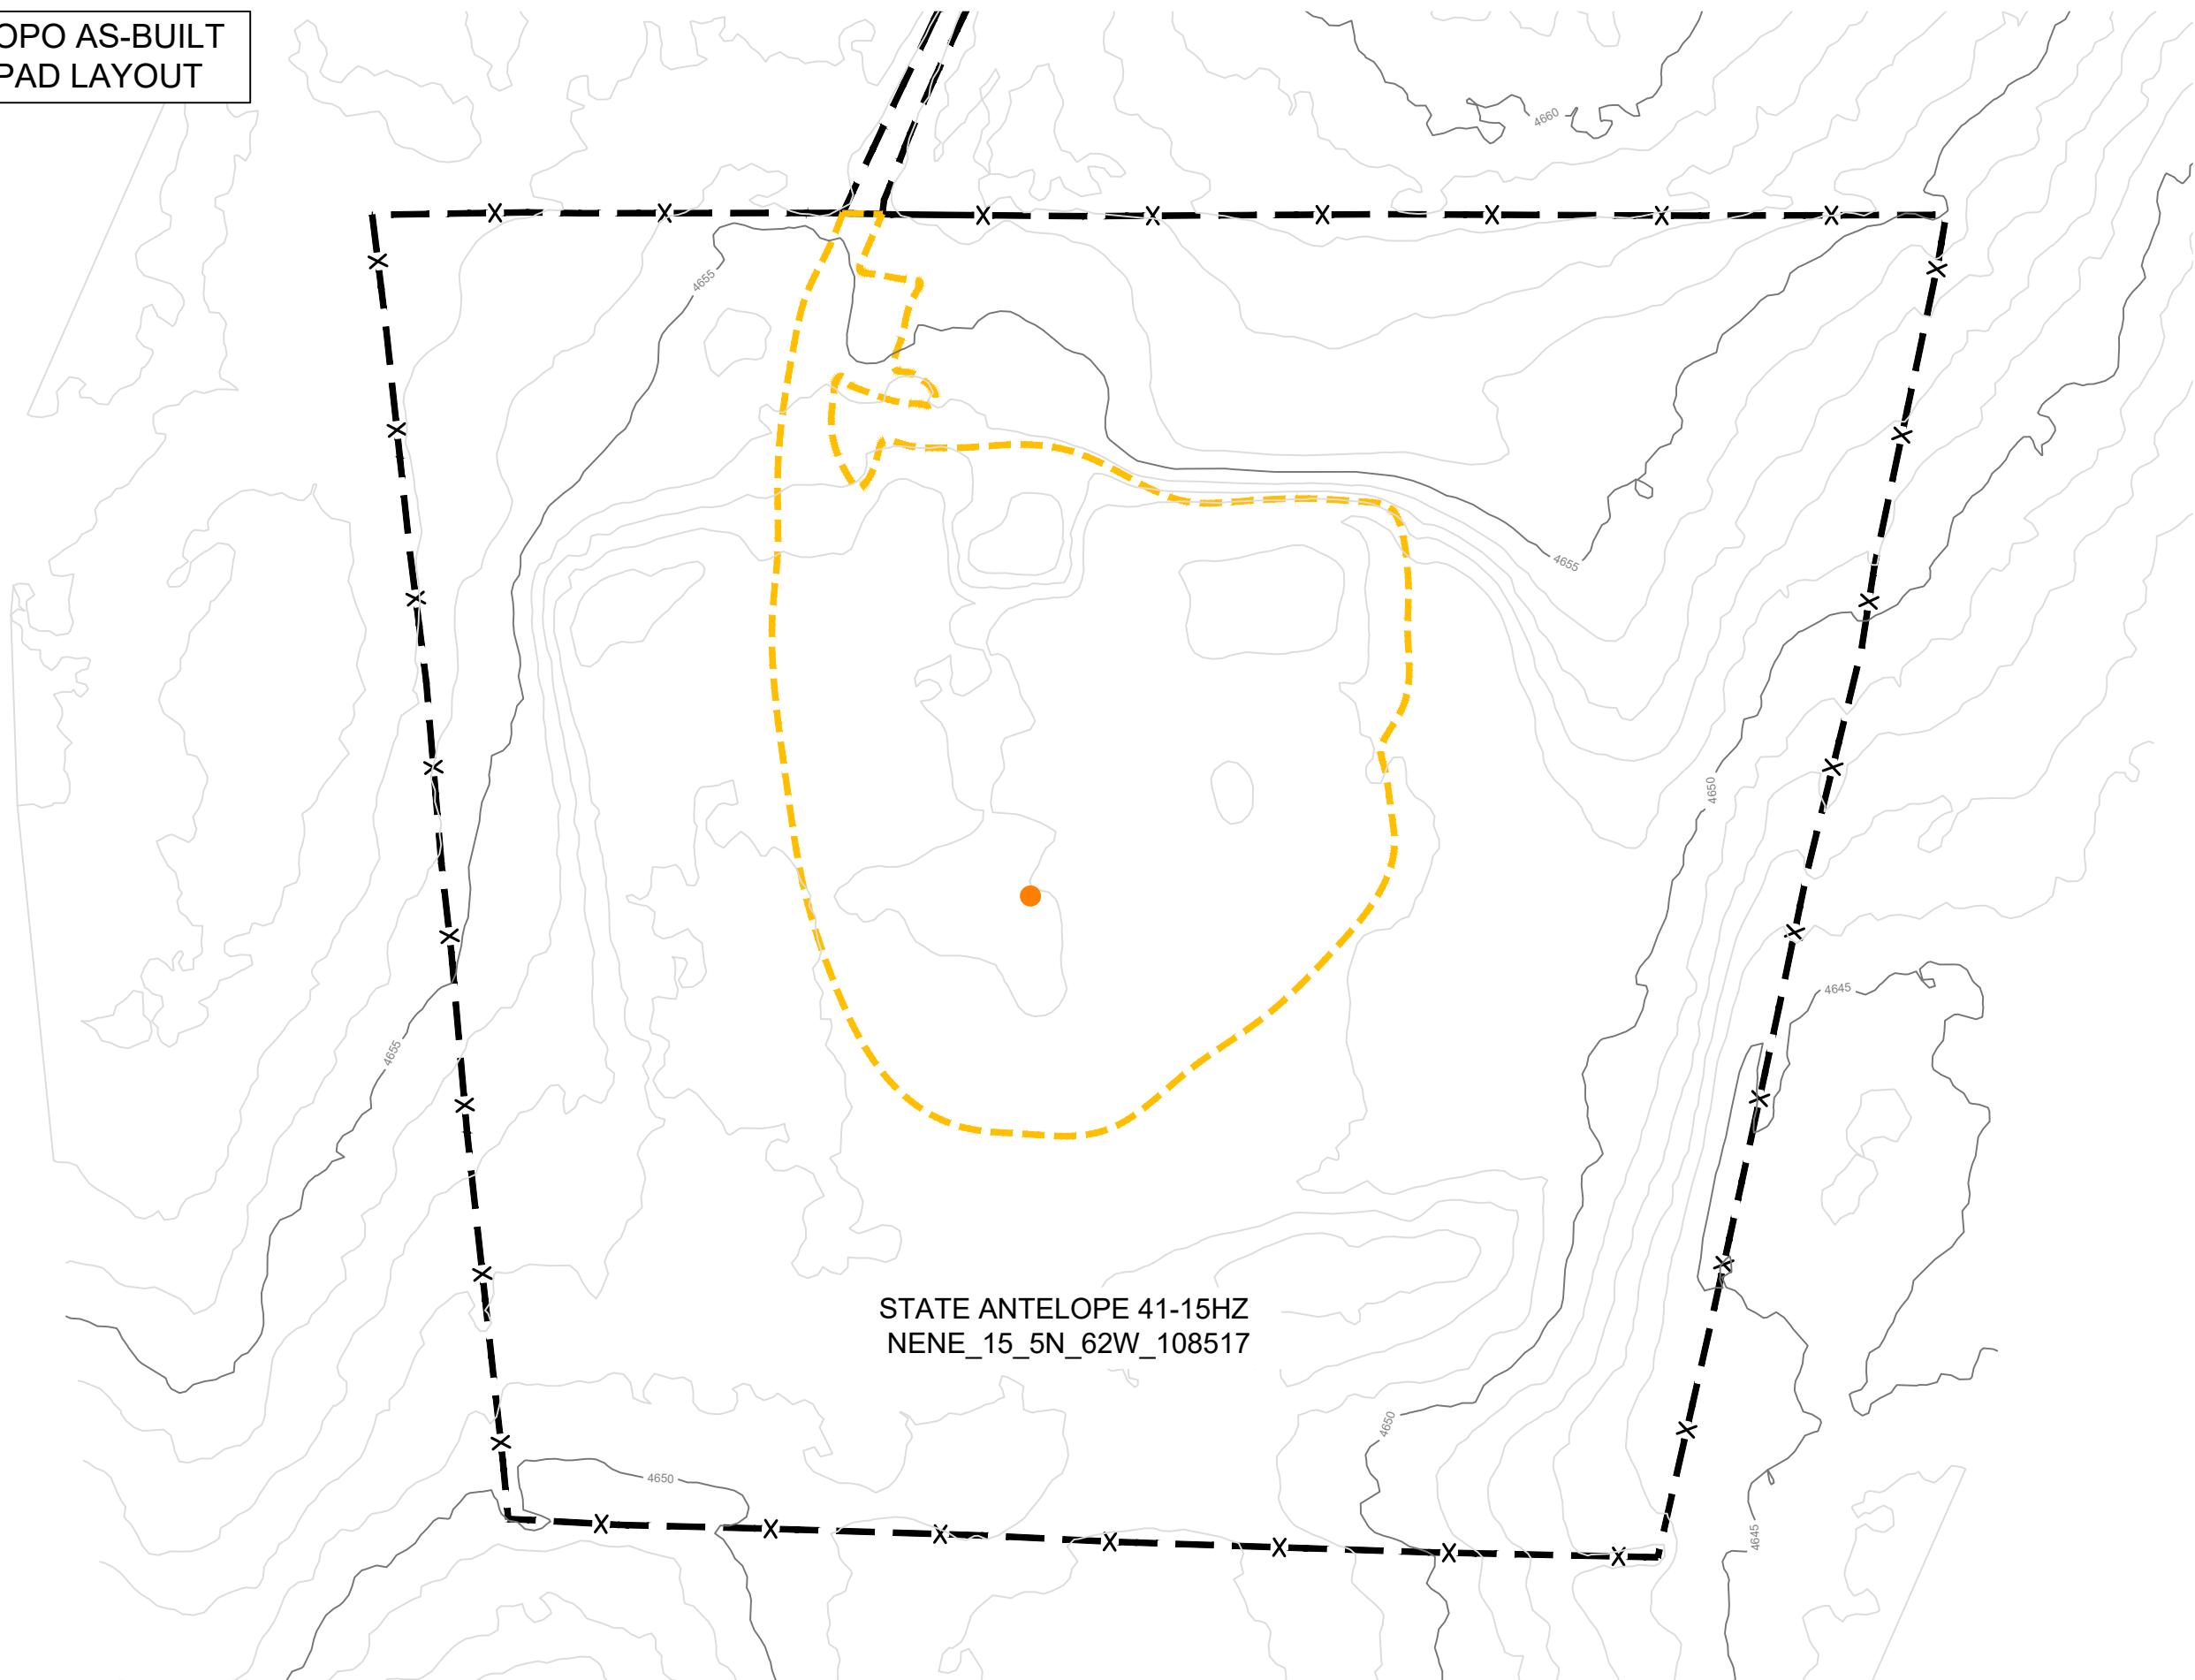

NOTES

**UPDATED AERIAL ORTHOIMAGERY & TOPO DATA
COLLECTED BY RPG RESOURCES BY USE OF UAV IN
AUGUST, 2021**

AREA INSIDE FENCE: 5.19 ACRES

PAD AREA: 1.07 ACRES

ACCESS ROAD AREA: 0.12 ACRES

LEGEND

- 4600 — MAJOR CONTOUR
- 4655 — MINOR CONTOUR
- x-x- FENCE LINE
- - - PAD EDGE
- - - ACCESS ROAD
- WELLHEAD



**STATE ANTELOPE 41-15HZ
AS-BUILT EXHIBITS**

SECTION 15, TOWNSHIP 5N, RANGE 62W,
WELD COUNTY, COLORADO

SHEET NAME:	SHEET NO.
TOPO OVERVIEW	2 OF 4

AERIAL AS-BUILT
ACCESS ROAD




NOTES

**UPDATED AERIAL ORTHOIMAGERY & TOPO DATA
COLLECTED BY RPG RESOURCES BY USE OF UAV IN
AUGUST, 2021**

AREA INSIDE FENCE: 5.19 ACRES

PAD AREA: 1.07 ACRES

ACCESS ROAD AREA: 0.12 ACRES

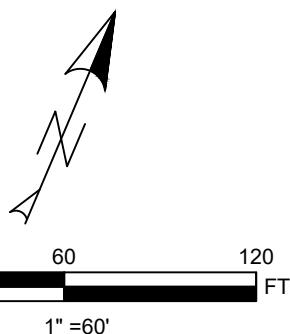

LEGEND

- x-x-x- FENCE LINE
- PAD EDGE
- ACCESS ROAD




STATE ANTELOPE 41-15HZ
AS-BUILT EXHIBITS

SECTION 15, TOWNSHIP 5N, RANGE 62W,
WELD COUNTY, COLORADO

SHEET NAME:	SHEET NO.
ACCESS ROAD AERIAL	3 OF 4

**TOPO AS-BUILT
ACCESS ROAD**

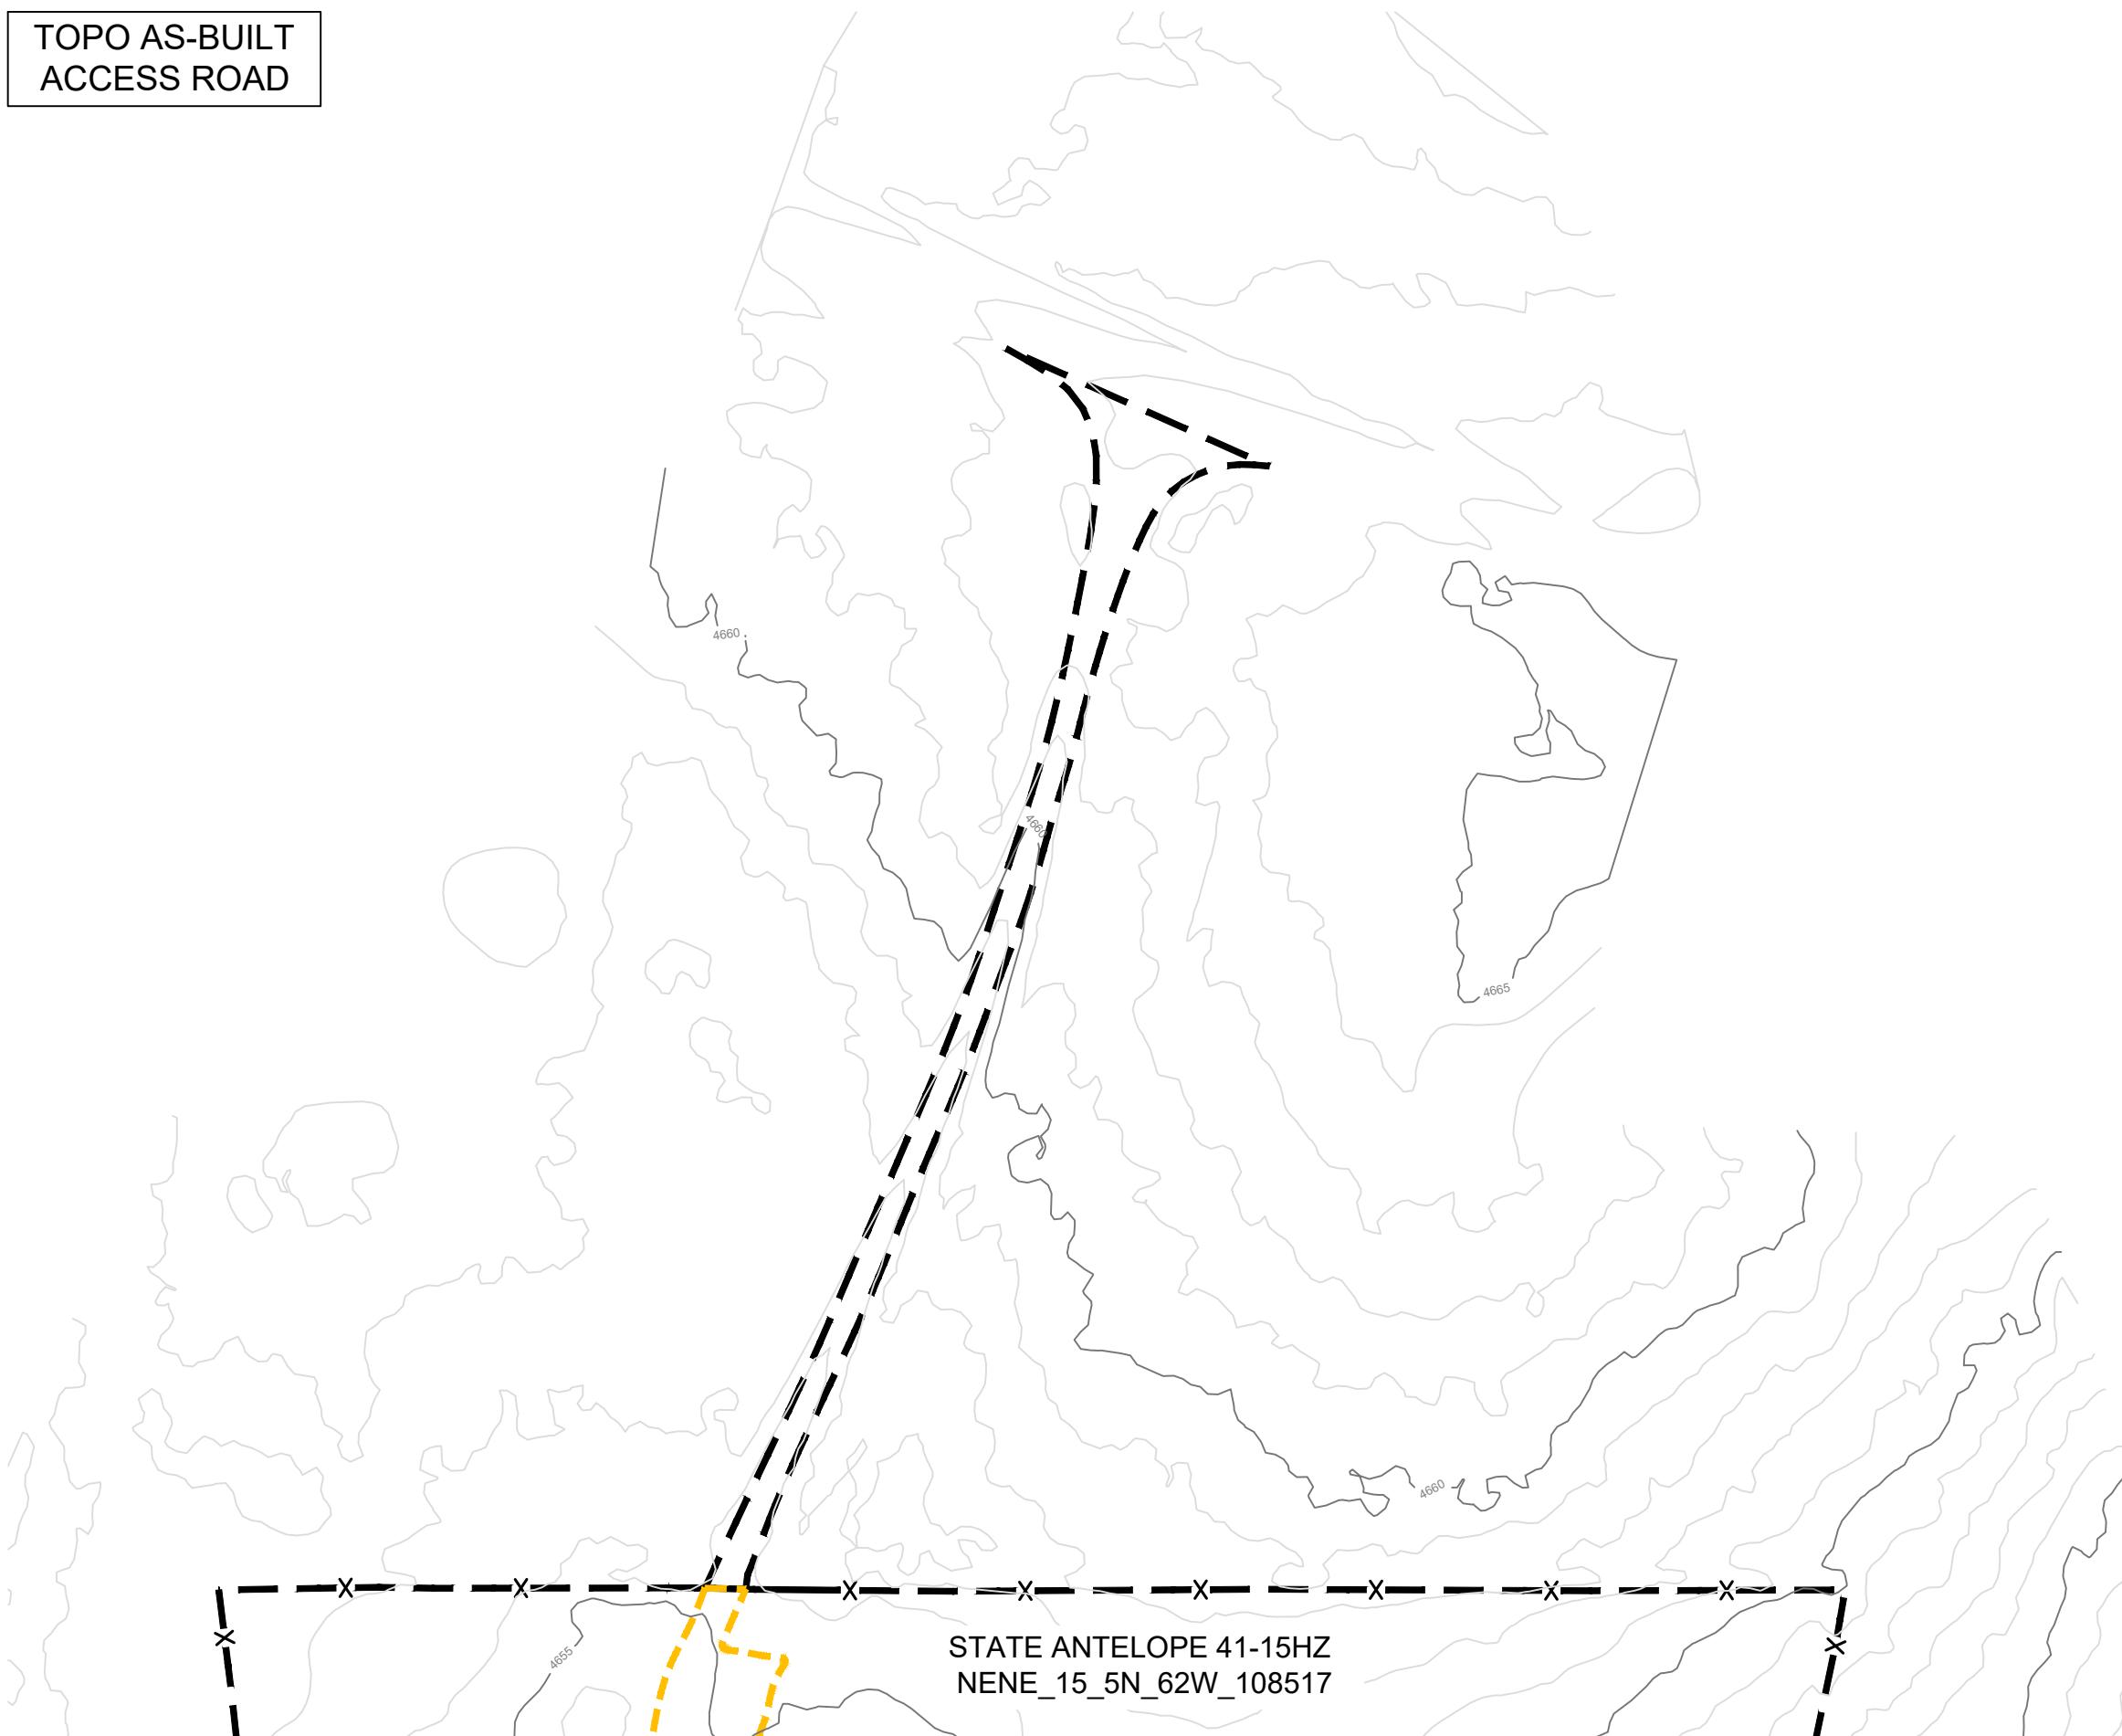


NOTES

**UPDATED AERIAL ORTHOIMAGERY & TOPO DATA
COLLECTED BY RPG RESOURCES BY USE OF UAV IN
AUGUST, 2021**

AREA INSIDE FENCE: 5.19 ACRES

PAD AREA: 1.07 ACRES

ACCESS ROAD AREA: 0.12 ACRES

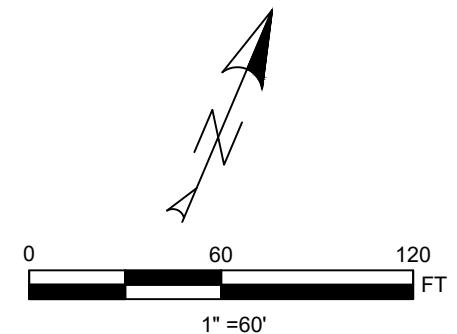

LEGEND

- 4600 — MAJOR CONTOUR
- 4660 — MINOR CONTOUR
- x -x -x -x -x - FENCE LINE
- - - - - PAD EDGE
- - - - - ACCESS ROAD



**STATE ANTELOPE 41-15HZ
AS-BUILT EXHIBITS**

SECTION 15, TOWNSHIP 5N, RANGE 62W,
WELD COUNTY, COLORADO

SHEET NAME:	SHEET NO.
ACCESS ROAD TOPO	3 OF 4