

AERIAL AS-BUILT  
PAD LAYOUT




NOTES

\*\*UPDATED AERIAL ORTHOIMAGERY COLLECTED BY  
RPG RESOURCES BY USE OF UAV IN SEPTEMBER,  
2021\*\*

AREA INSIDE FENCE: 9.10 ACRES

INT. RECLAMATION PAD FOOTPRINT AREA: 5.85 ACRES

ACCESS ROAD SURFACE AREA: 1.00 ACRES

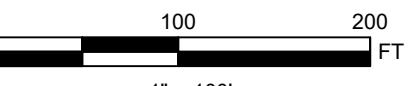

LEGEND

- — — — — ACCESS ROAD
- x-x-x-x- FENCE LINE
- - - - - PAD EDGE
- WELL HEAD




STATE ANTELOPE 14-2  
AS-BUILT EXHIBITS

SECTION 1, TOWNSHIP 5N, RANGE 62W,  
WELD COUNTY, COLORADO

SHEET NAME:	SHEET NO.
AERIAL IMAGERY	1 OF 6

**TOPO AS-BUILT  
PAD LAYOUT**

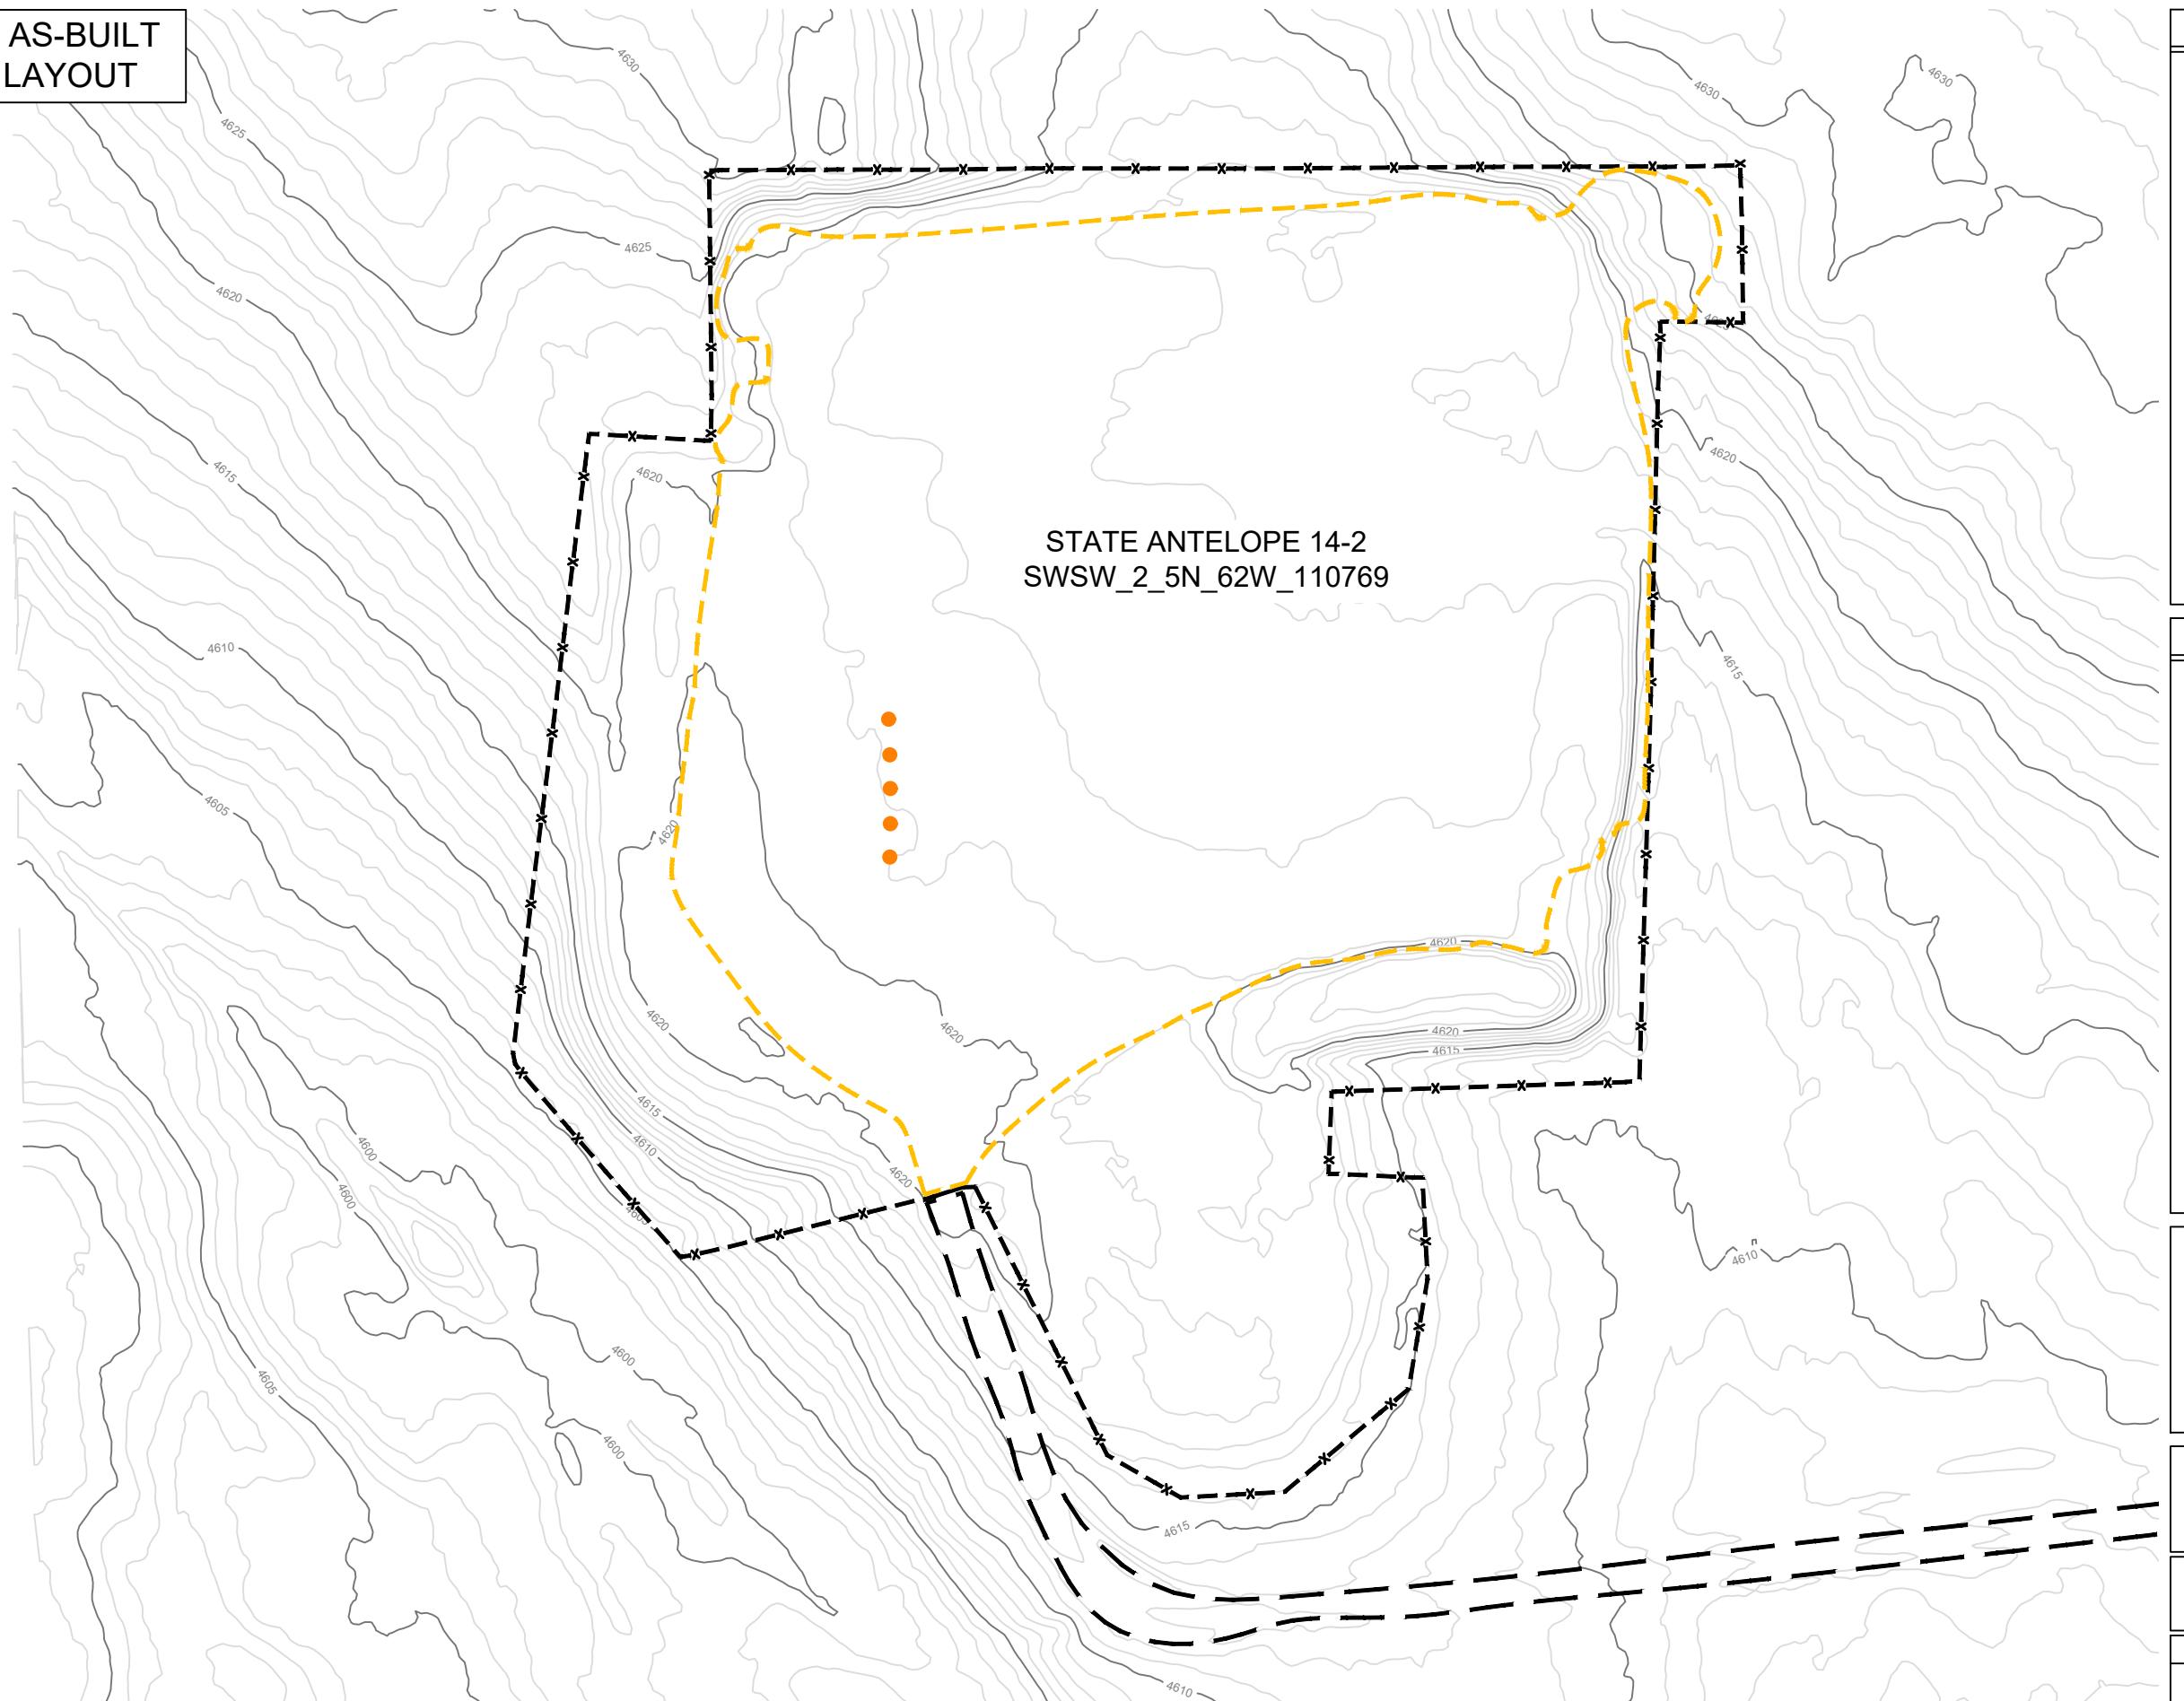

**NOTES**

\*\*UPDATED TOPO DATA COLLECTED BY RPG RESOURCES BY USE OF UAV IN SEPTEMBER, 2021\*\*

AREA INSIDE FENCE: 9.10 ACRES  
INT. RECLAMATION PAD FOOTPRINT AREA: 5.85 ACRES  
ACCESS ROAD SURFACE AREA: 1.00 ACRES



0 100 200 FT  
1" = 100'

**LEGEND**

- 4500 — MAJOR CONTOUR
- 4600 — MINOR CONTOUR
- - - - - ACCESS ROAD
- x-x-x- FENCE LINE
- - - - - PAD EDGE
- WELL HEAD



**STATE ANTELOPE 14-2  
AS-BUILT EXHIBITS**

SECTION 1, TOWNSHIP 5N, RANGE 62W,  
WELD COUNTY, COLORADO

SHEET NAME:	SHEET NO.
TOPO OVERVIEW	2 OF 6

AERIAL AS-BUILT  
ACCESS ROAD




NOTES

\*\*UPDATED AERIAL ORTHOIMAGERY COLLECTED BY  
RPG RESOURCES BY USE OF UAV IN SEPTEMBER,  
2021\*\*

AREA INSIDE FENCE: 9.10 ACRES

INT. RECLAMATION PAD FOOTPRINT AREA: 5.85 ACRES

ACCESS ROAD SURFACE AREA: 1.00 ACRES

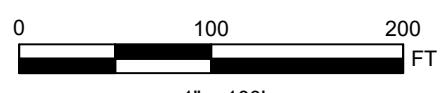

LEGEND

- — — — — ACCESS ROAD
- x-x-x-x- FENCE LINE
- - - - - PAD EDGE
- WELL HEAD




STATE ANTELOPE 14-2  
AS-BUILT EXHIBITS

SECTION 1, TOWNSHIP 5N, RANGE 62W,  
WELD COUNTY, COLORADO

SHEET NAME:	SHEET NO.
ACCESS ROAD IMAGERY 1	3 OF 6


**TOPO AS-BUILT  
ACCESS ROAD**

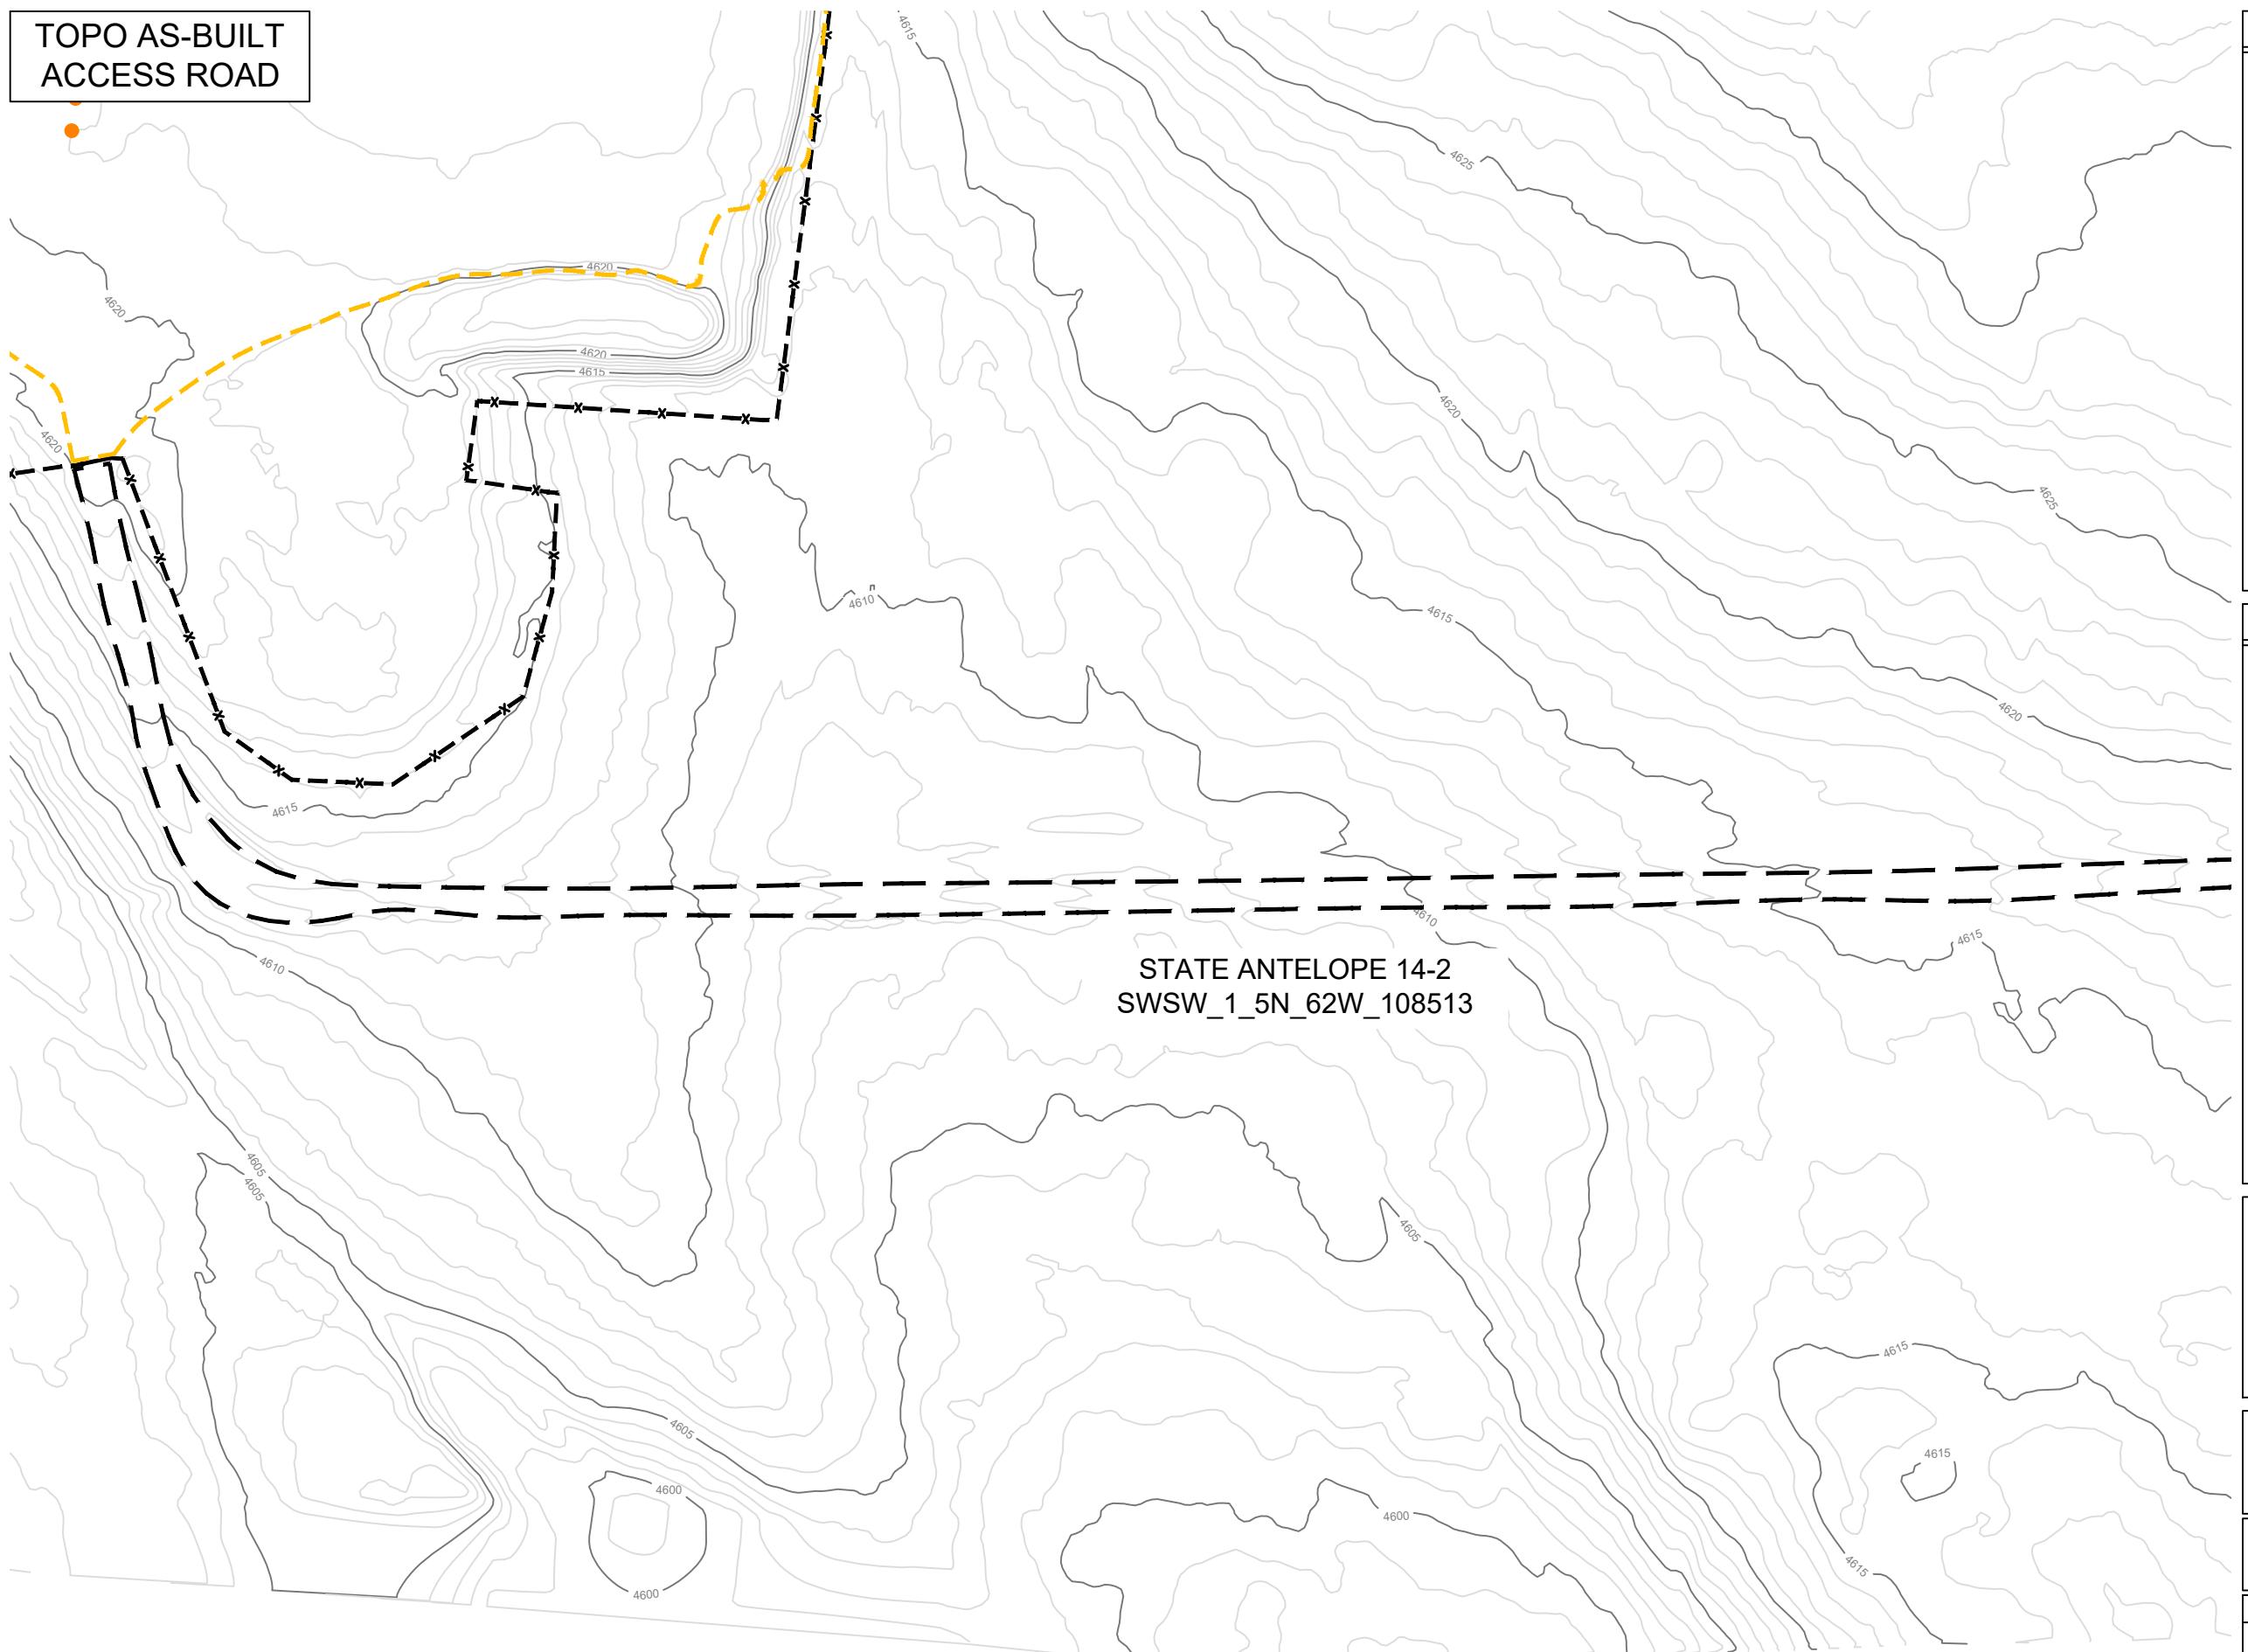

**NOTES**

\*\*UPDATED TOPO DATA COLLECTED BY RPG  
RESOURCES BY USE OF UAV IN SEPTEMBER, 2021\*\*

AREA INSIDE FENCE: 9.10 ACRES  
INT. RECLAMATION PAD FOOTPRINT AREA: 5.85 ACRES  
ACCESS ROAD SURFACE AREA: 1.00 ACRES

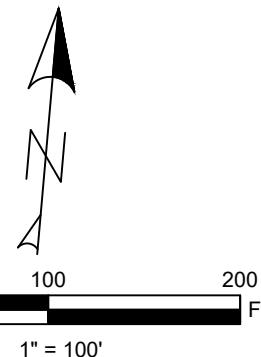

**LEGEND**

- 4500 — MAJOR CONTOUR
- 4600 — MINOR CONTOUR
- - - - - ACCESS ROAD
- x-x- - FENCE LINE
- - - - - PAD EDGE
- WELL HEAD



**STATE ANTELOPE 14-2  
AS-BUILT EXHIBITS**

SECTION 1, TOWNSHIP 5N, RANGE 62W,  
WELD COUNTY, COLORADO

SHEET NAME: ACCESS ROAD TOPO 1	SHEET NO. 4 OF 6
-----------------------------------	---------------------

AERIAL AS-BUILT  
ACCESS ROAD



NOTES

\*\*UPDATED AERIAL ORTHOIMAGERY COLLECTED BY  
RPG RESOURCES BY USE OF UAV IN SEPTEMBER,  
2021\*\*

PERMITTED DISTURBED AREA: 10.70 ACRES

AREA INSIDE FENCE: 9.10 ACRES

INT. RECLAMATION PAD FOOTPRINT AREA: 5.85 ACRES

ACCESS ROAD SURFACE AREA: 1.00 ACRES



LEGEND

— — — — ACCESS ROAD




STATE ANTELOPE 14-2  
AS-BUILT EXHIBITS

SECTION 1, TOWNSHIP 5N, RANGE 62W,  
WELD COUNTY, COLORADO

SHEET NAME:	SHEET NO.
ACCESS ROAD IMAGERY 2	5 OF 6

# TOPO AS-BUILT ACCESS ROAD

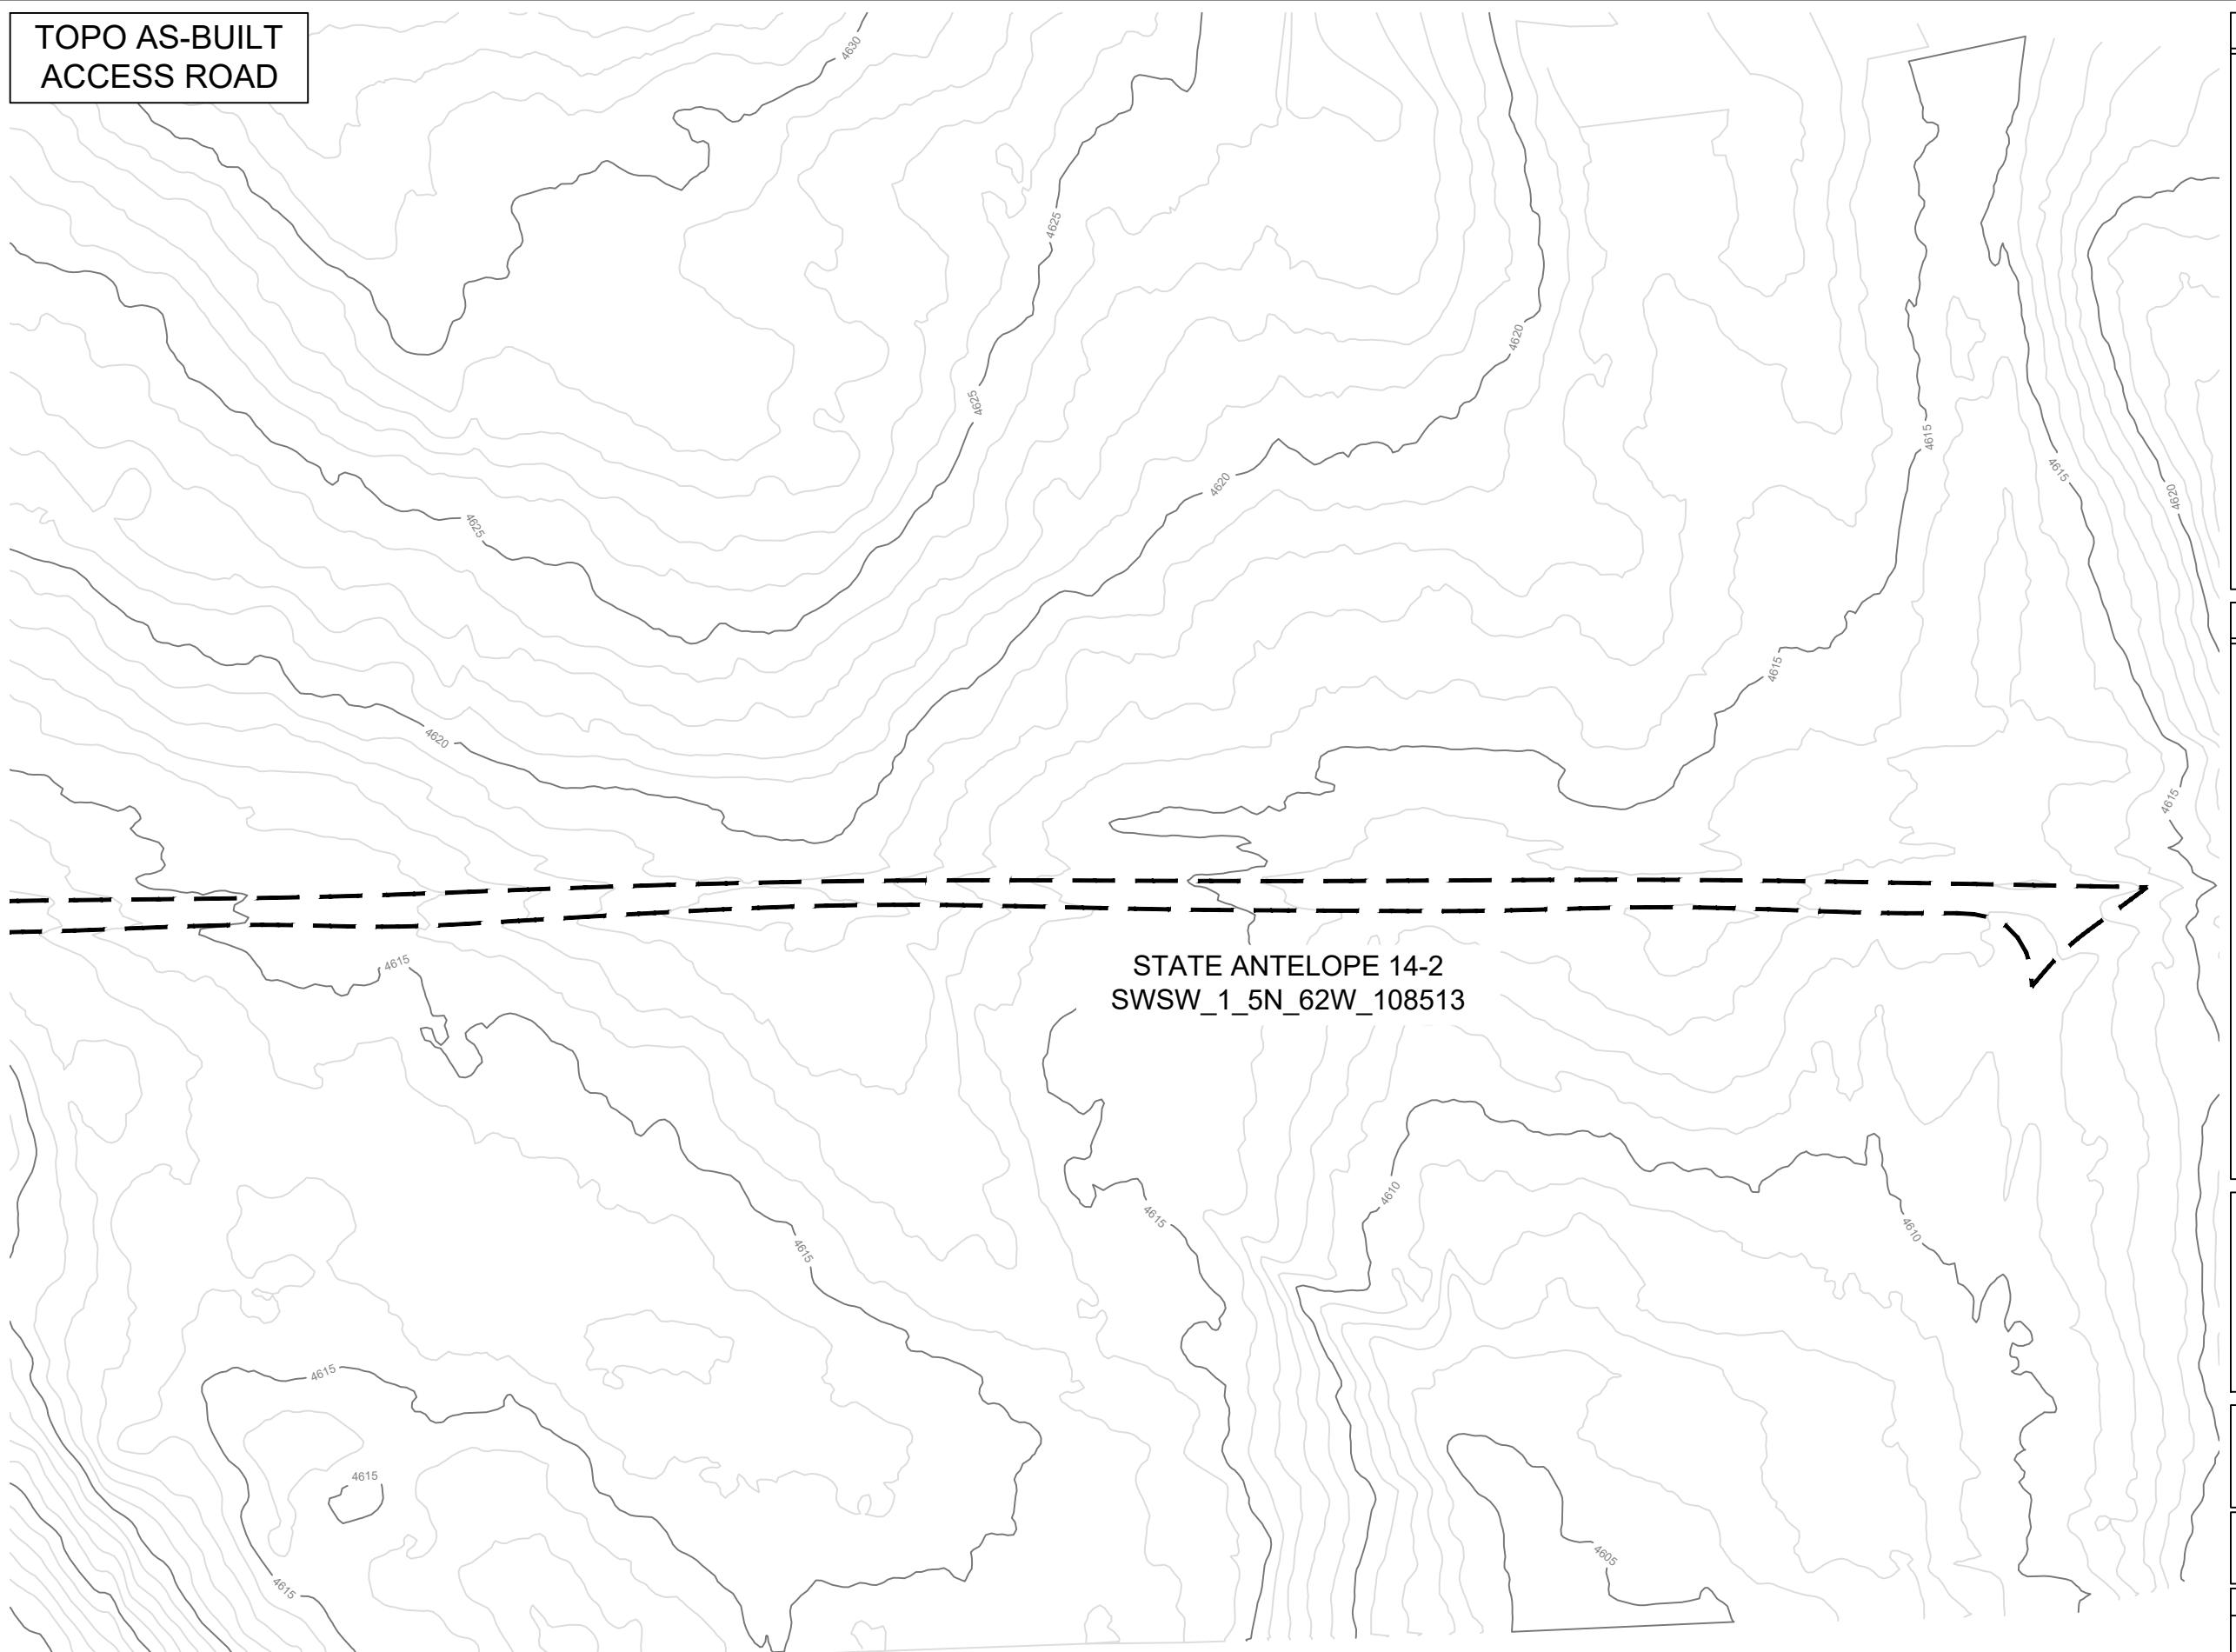

## **NOTES**

\*\*UPDATED TOPO DATA COLLECTED BY RPG  
RESOURCES BY USE OF UAV IN SEPTEMBER, 2021\*\*

**PERMITTED DISTURBED AREA: 10.70 ACRES**

**AREA INSIDE FENCE: 9.10 ACRES**

**INT. RECLAMATION PAD FOOTPRINT AREA: 5.85 ACRES**

**ACCESS ROAD SURFACE AREA: 1.00 ACRES**



A scale bar diagram for architectural drawings. It features three horizontal bars. The top bar has numerical markings at 0, 100, and 200. The middle bar is black and spans from the 0 mark to the 100 mark. The bottom bar is also black and spans from the 0 mark to the 200 mark. Below the bars, the text "1" = 100'" is centered.

---

## *LEGEND*

---

4500 MAJOR CONTOUR

MINOR CONTOUR

— — — — ACCESS ROAD



**STATE ANTELOPE 14-2  
AS-BUILT EXHIBITS**

SECTION 1, TOWNSHIP 5N, RANGE 62W,  
WELD COUNTY, COLORADO

SHEET NAME:	SHEET NO.
ACCESS ROAD TOPO 2	6 OF 6