

AERIAL AS-BUILT PAD LAYOUT




NOTES

**UPDATED AERIAL ORTHOIMAGERY COLLECTED BY
RPG RESOURCES BY USE OF UAV IN SEPTEMBER,
2021**

AREA INSIDE FENCE: 6.42 ACRES

INT. RECLAMATION PAD FOOTPRINT AREA: 3.72 ACRES

ACCESS ROAD SURFACE AREA: 0.19 ACRES

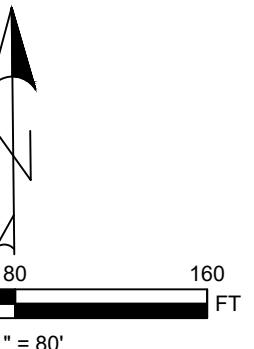

LEGEND

- — — ACCESS ROAD
- x-x-x- FENCE LINE
- — PAD EDGE
- WELL HEAD




STATE NORTH PLATTE F-26 AS-BUILT EXHIBITS

SECTION 26, TOWNSHIP 5N, RANGE 63W,
WELD COUNTY, COLORADO

SHEET NAME:	SHEET NO.
AERIAL IMAGERY	1 OF 2


**TOPO AS-BUILT
PAD LAYOUT**

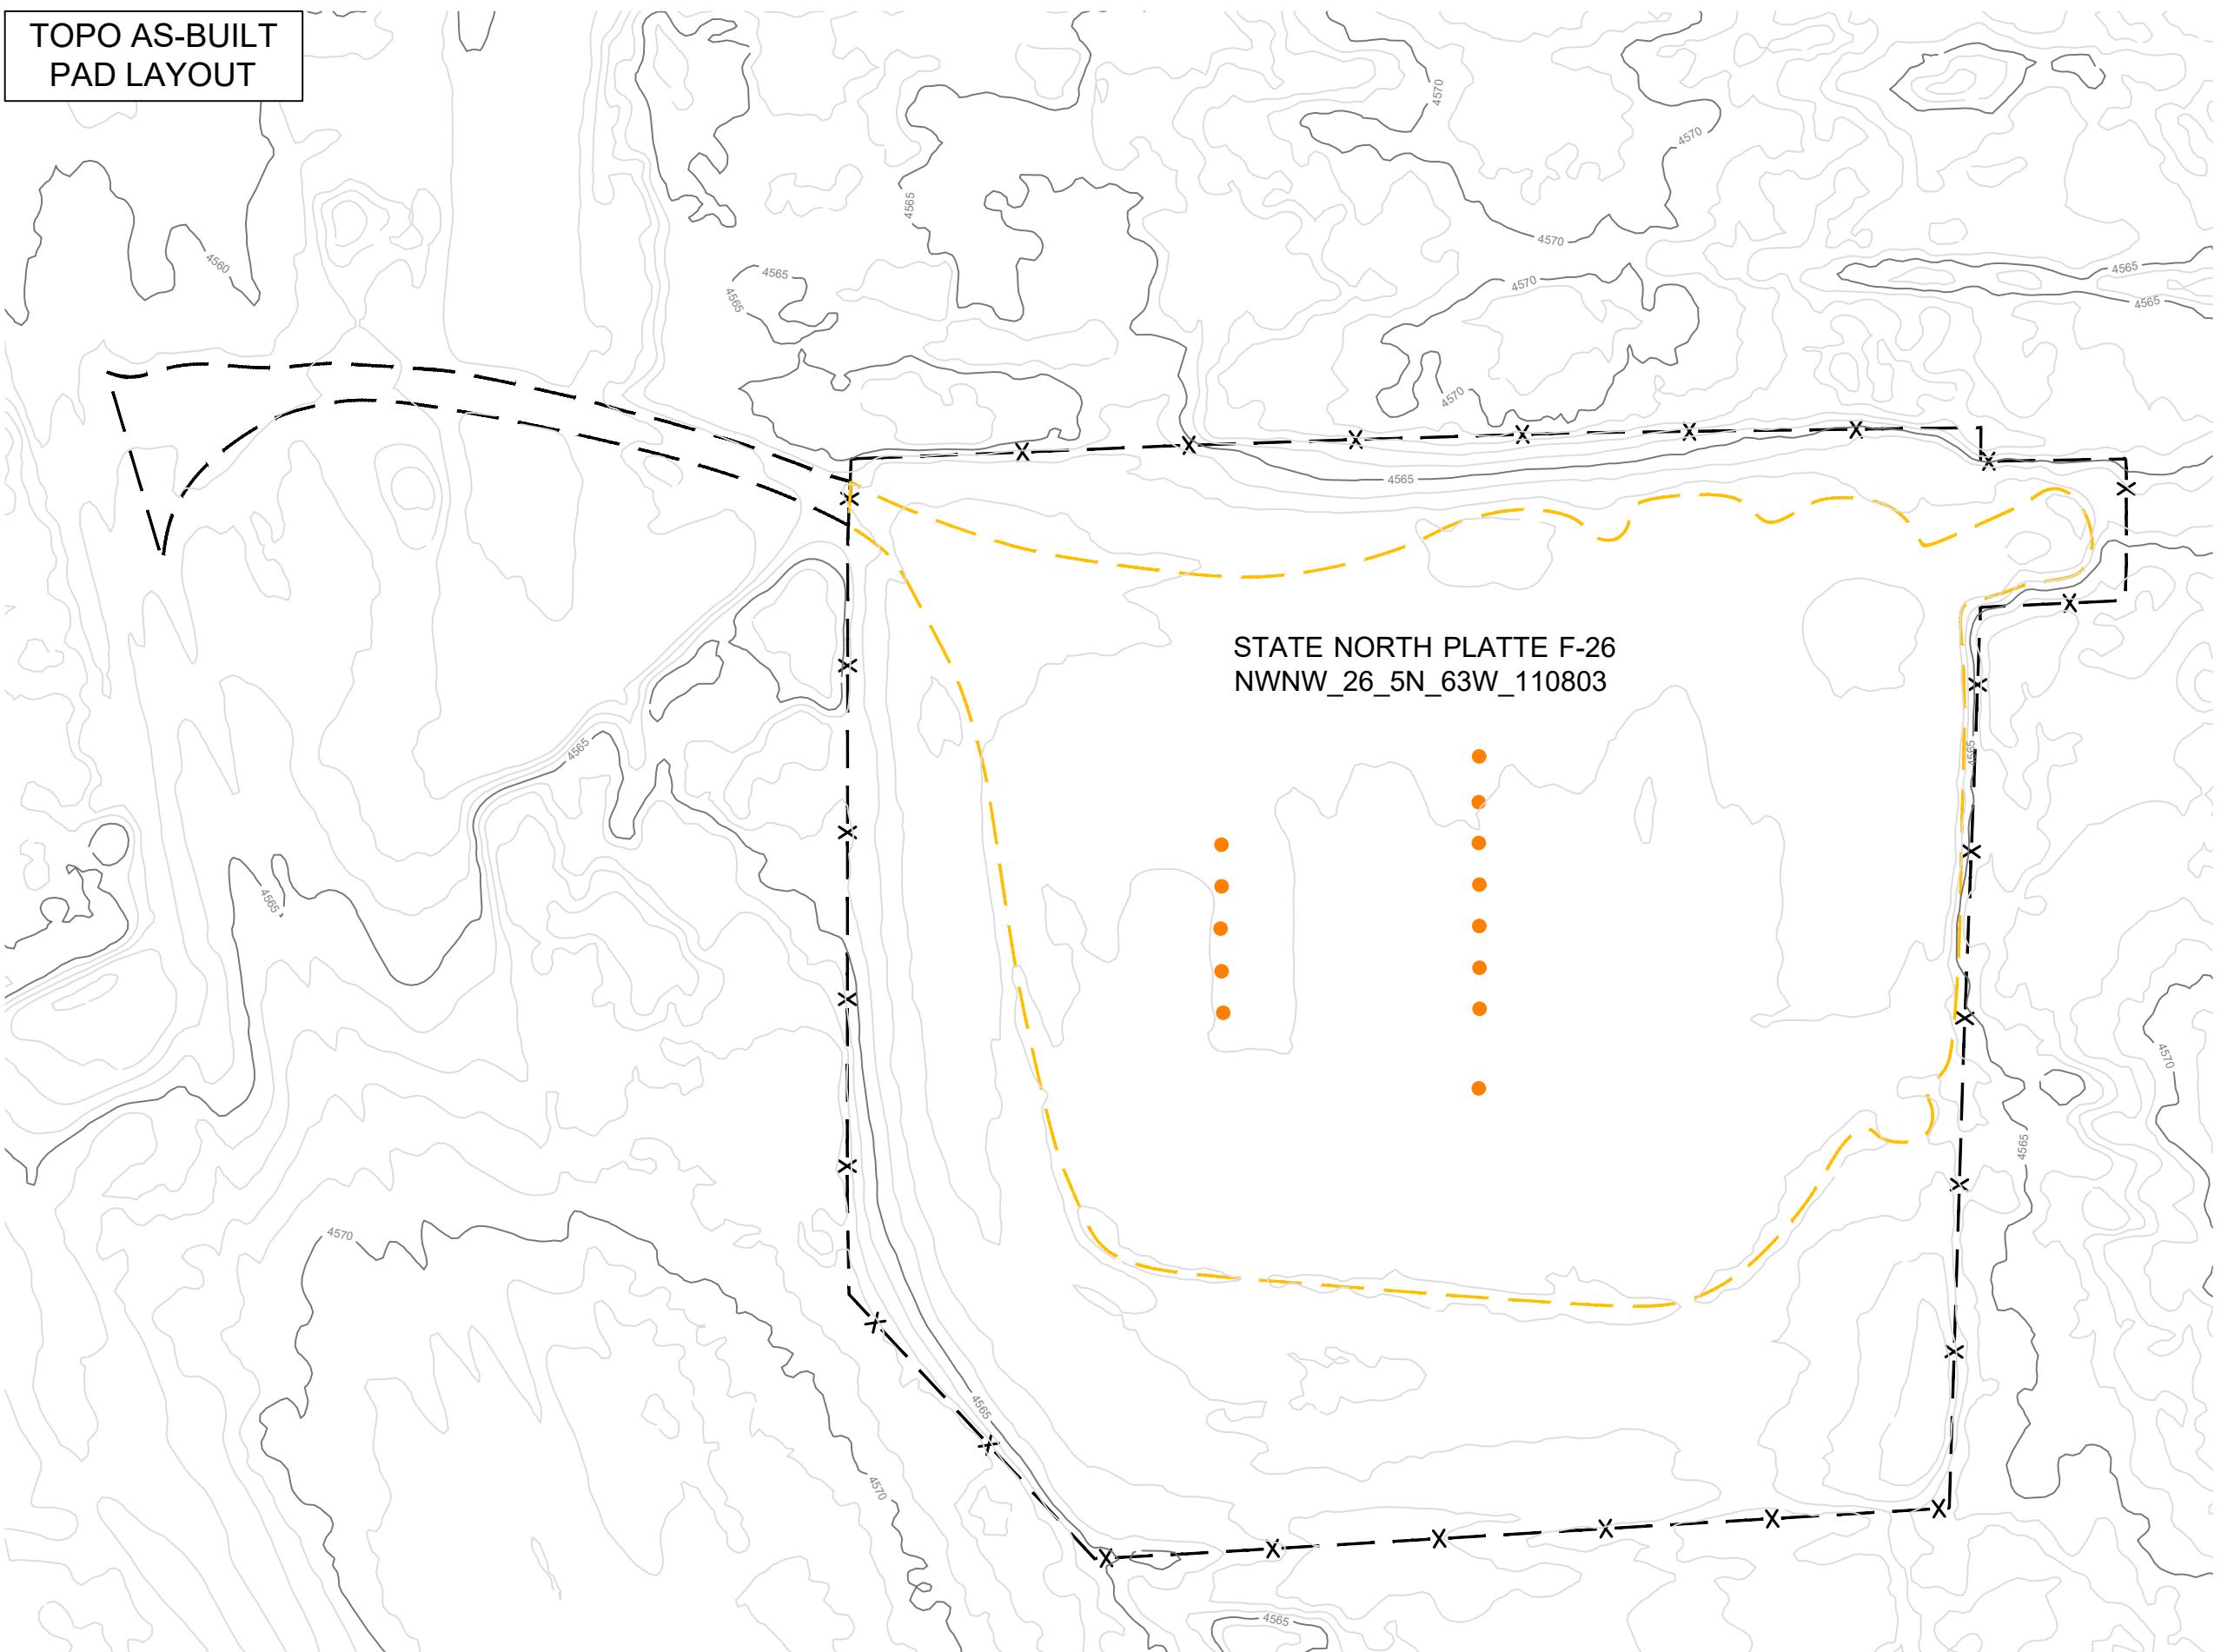

NOTES

**UPDATED TOPO DATA COLLECTED BY RPG
RESOURCES BY USE OF UAV IN SEPTEMBER, 2021**

AREA INSIDE FENCE: 6.42 ACRES
INT. RECLAMATION PAD FOOTPRINT AREA: 3.72 ACRES
ACCESS ROAD SURFACE AREA: 0.19 ACRES

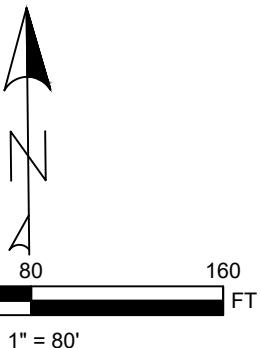

LEGEND

- 4505 — MAJOR CONTOUR
- 4565 — MINOR CONTOUR
- 4570 —
- 4585 —
- - - - - ACCESS ROAD
- x-x- - FENCE LINE
- - - - - PAD EDGE
- WELL HEAD



**STATE NORTH PLATTE F-26
AS-BUILT EXHIBITS**

SECTION 26, TOWNSHIP 5N, RANGE 63W,
WELD COUNTY, COLORADO

SHEET NAME:	SHEET NO.
TOPO OVERVIEW	2 OF 2