

AERIAL AS-BUILT PAD LAYOUT





NOTES

UPDATED AERIAL ORTHOIMAGERY COLLECTED BY RPG RESOURCES BY USE OF UAV IN AUGUST, 2021

AREA INSIDE FENCE: 4.71 ACRES

INT. RECLAMATION PAD FOOTPRINT AREA: 1.92 ACRES

ACCESS ROAD AREA: 0.06 ACRES

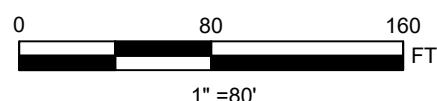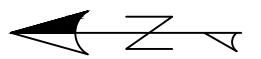

LEGEND

- FENCE LINE
- PAD EDGE
- ACCESS ROAD
- WELL HEAD




STATE PRONGHORN P-16 AS-BUILT EXHIBITS

SECTION 16, TOWNSHIP 5N, RANGE 61W,
WELD COUNTY, COLORADO

SHEET NAME:	SHEET NO.
AERIAL IMAGERY	1 OF 2



TOPO AS-BUILT PAD LAYOUT

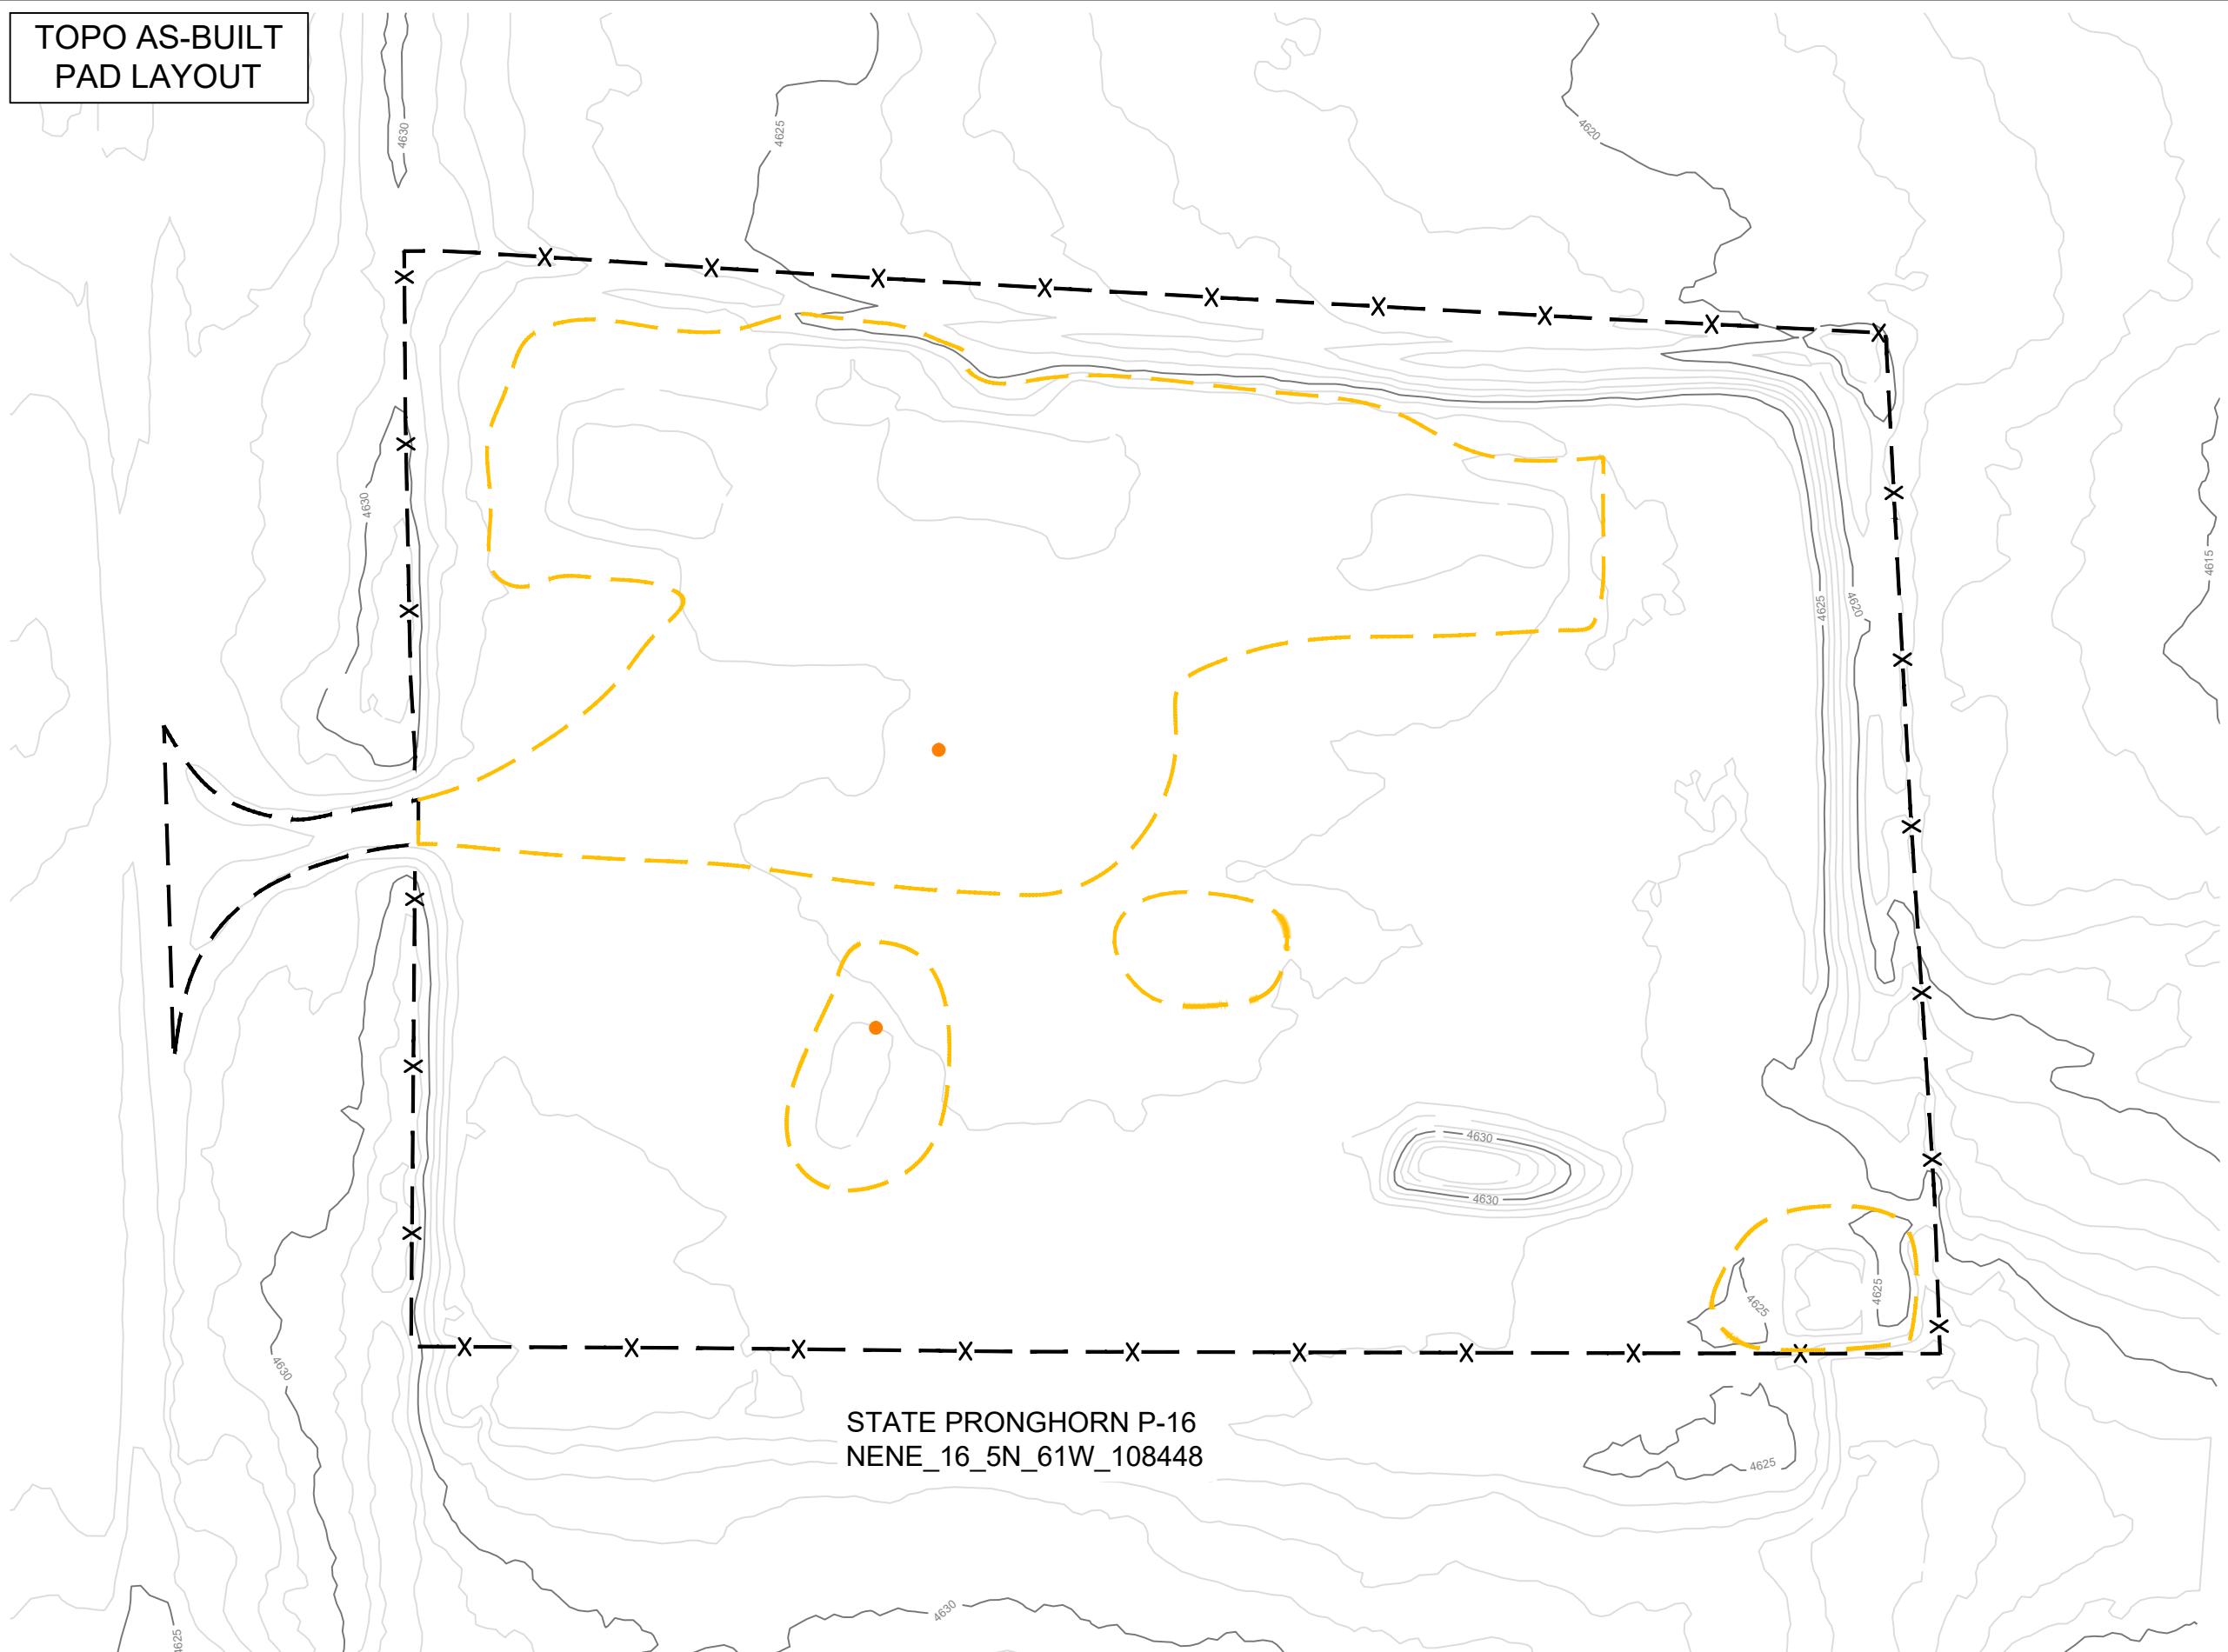

NOTES

UPDATED AERIAL ORTHOIMAGERY COLLECTED BY RPG RESOURCES BY USE OF UAV IN AUGUST, 2021

AREA INSIDE FENCE: 4.71 ACRES
INT. RECLAMATION PAD FOOTPRINT AREA: 1.92 ACRES
ACCESS ROAD AREA: 0.06 ACRES

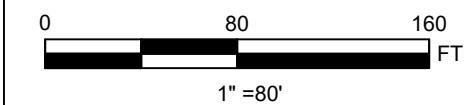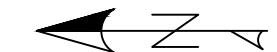

LEGEND

- 4600 — MAJOR CONTOUR
- 4625 — MINOR CONTOUR
- x-x- FENCE LINE
- - - PAD EDGE
- - - ACCESS ROAD
- WELL HEAD



STATE PRONGHORN P-16 AS-BUILT EXHIBITS

SECTION 16, TOWNSHIP 5N, RANGE 61W,
WELD COUNTY, COLORADO

SHEET NAME:	SHEET NO.
TOPO OVERVIEW	2 OF 2