

## AERIAL AS-BUILT PAD LAYOUT



## NOTES

\*\*UPDATED AERIAL ORTHOIMAGERY COLLECTED BY RPG RESOURCES BY USE OF UAV IN SEPTEMBER, 2021\*\*

AREA INSIDE FENCE: 6.98 ACRES

INT. RECLAMATION PAD FOOTPRINT AREA: 2.05 ACRES

ACCESS ROAD SURFACE AREA: 0.90 ACRES



## LEGEND

- — — ACCESS ROAD
- X — FENCE LINE
- — — PAD EDGE
- WELL HEAD



## STATE ANTELOPE T-24 AS-BUILT EXHIBITS

SECTION 24, TOWNSHIP 5N, RANGE 62W,  
WELD COUNTY, COLORADO

SHEET NAME:	SHEET NO.
AERIAL IMAGERY	1 OF 8


**TOPO AS-BUILT  
PAD LAYOUT**



**NOTES**

\*\*UPDATED TOPO DATA COLLECTED BY RPG  
RESOURCES BY USE OF UAV IN SEPTEMBER, 2021\*\*

AREA INSIDE FENCE: 6.98 ACRES  
INT. RECLAMATION PAD FOOTPRINT AREA: 2.05 ACRES  
ACCESS ROAD SURFACE AREA: 0.90 ACRES

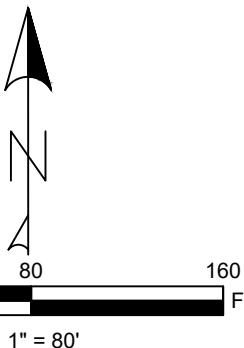

**LEGEND**

- 4505 — MAJOR CONTOUR
- 4520 — MINOR CONTOUR
- 4520 — ACCESS ROAD
- X — FENCE LINE
- 4520 — PAD EDGE
- WELL HEAD



**STATE ANTELOPE T-24  
AS-BUILT EXHIBITS**

SECTION 24, TOWNSHIP 5N, RANGE 62W,  
WELD COUNTY, COLORADO

SHEET NAME:	SHEET NO.
TOPO OVERVIEW	2 OF 8

AERIAL AS-BUILT  
ACCESS ROAD




NOTES

\*\*UPDATED AERIAL ORTHOIMAGERY COLLECTED BY  
RPG RESOURCES BY USE OF UAV IN SEPTEMBER,  
2021\*\*

AREA INSIDE FENCE: 6.98 ACRES

INT. RECLAMATION PAD FOOTPRINT AREA: 2.05 ACRES

ACCESS ROAD SURFACE AREA: 0.90 ACRES

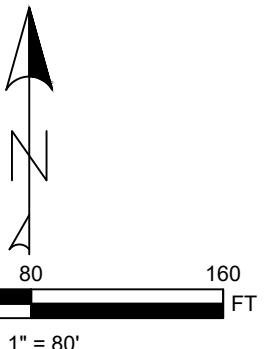

LEGEND

- — — — — ACCESS ROAD
- x-x-x-x- FENCE LINE
- - - - - PAD EDGE



STATE ANTELOPE T-24  
AS-BUILT EXHIBITS

SECTION 24, TOWNSHIP 5N, RANGE 62W,  
WELD COUNTY, COLORADO

SHEET NAME:	SHEET NO.
ACCESS ROAD IMAGERY	3 OF 8

**TOPO AS-BUILT  
ACCESS ROAD**



**NOTES**

\*\*UPDATED TOPO DATA COLLECTED BY RPG RESOURCES BY USE OF UAV IN SEPTEMBER, 2021\*\*

AREA INSIDE FENCE: 6.98 ACRES  
INT. RECLAMATION PAD FOOTPRINT AREA: 2.05 ACRES  
ACCESS ROAD SURFACE AREA: 0.90 ACRES



**LEGEND**

- 4505 — MAJOR CONTOUR
- 4520 — MINOR CONTOUR
- - - - - ACCESS ROAD
- x-x- - FENCE LINE
- - - - - PAD EDGE



**STATE ANTELOPE T-24  
AS-BUILT EXHIBITS**

SECTION 24, TOWNSHIP 5N, RANGE 62W,  
WELD COUNTY, COLORADO

SHEET NAME:	SHEET NO.
ACCESS ROAD TOPO	4 OF 8

AERIAL AS-BUILT  
ACCESS ROAD




NOTES

\*\*UPDATED AERIAL ORTHOIMAGERY COLLECTED BY  
RPG RESOURCES BY USE OF UAV IN SEPTEMBER,  
2021\*\*

AREA INSIDE FENCE: 6.98 ACRES

INT. RECLAMATION PAD FOOTPRINT AREA: 2.05 ACRES

ACCESS ROAD SURFACE AREA: 0.90 ACRES

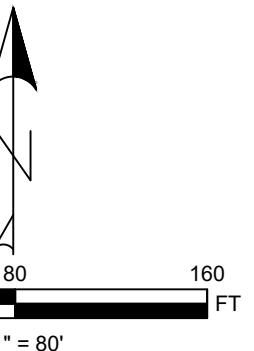

LEGEND

— — — — ACCESS ROAD




STATE ANTELOPE T-24  
AS-BUILT EXHIBITS

SECTION 24, TOWNSHIP 5N, RANGE 62W,  
WELD COUNTY, COLORADO

SHEET NAME:	SHEET NO.
ACCESS ROAD IMAGERY 2	5 OF 8


**TOPO AS-BUILT  
ACCESS ROAD**

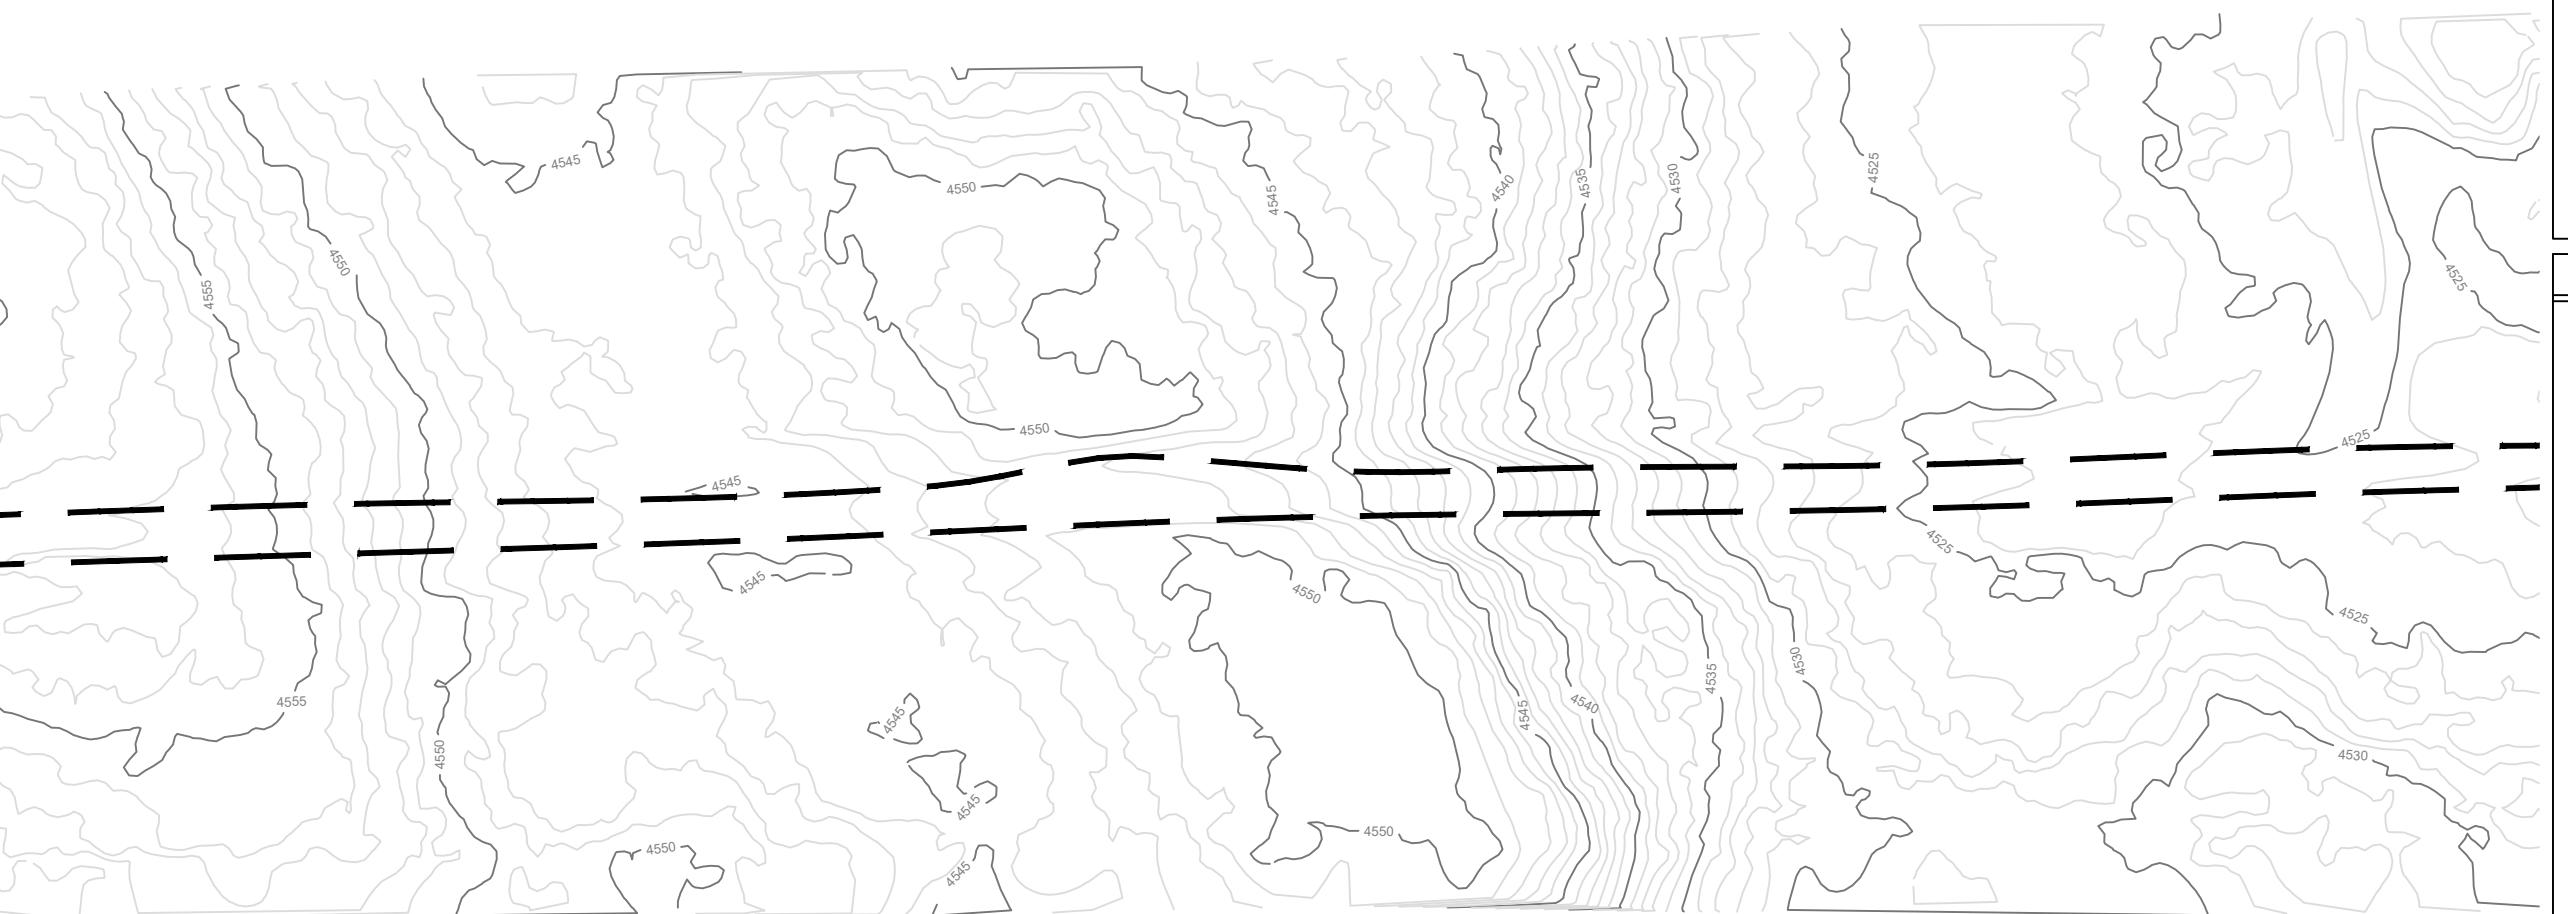

**NOTES**

\*\*UPDATED TOPO DATA COLLECTED BY RPG  
RESOURCES BY USE OF UAV IN SEPTEMBER, 2021\*\*

AREA INSIDE FENCE: 6.98 ACRES  
INT. RECLAMATION PAD FOOTPRINT AREA: 2.05 ACRES  
ACCESS ROAD SURFACE AREA: 0.90 ACRES

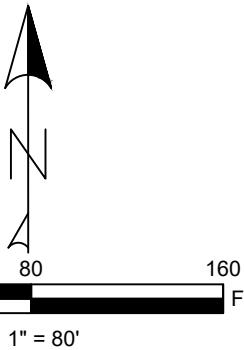

**LEGEND**

- MAJOR CONTOUR
- MINOR CONTOUR
- ACCESS ROAD



**STATE ANTELOPE T-24  
AS-BUILT EXHIBITS**

SECTION 24, TOWNSHIP 5N, RANGE 62W,  
WELD COUNTY, COLORADO

SHEET NAME:	SHEET NO.
ACCESS ROAD TOPO 2	6 OF 8

AERIAL AS-BUILT  
ACCESS ROAD




NOTES

\*\*UPDATED AERIAL ORTHOIMAGERY COLLECTED BY  
RPG RESOURCES BY USE OF UAV IN SEPTEMBER,  
2021\*\*

AREA INSIDE FENCE: 6.98 ACRES

INT. RECLAMATION PAD FOOTPRINT AREA: 2.05 ACRES

ACCESS ROAD SURFACE AREA: 0.90 ACRES

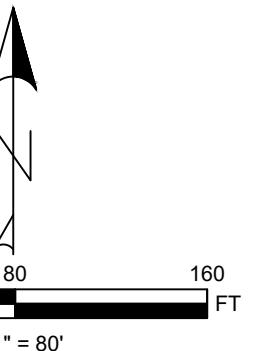

LEGEND

— — — — ACCESS ROAD




STATE ANTELOPE T-24  
AS-BUILT EXHIBITS

SECTION 24, TOWNSHIP 5N, RANGE 62W,  
WELD COUNTY, COLORADO

SHEET NAME:	SHEET NO.
ACCESS ROAD IMAGERY 3	7 OF 8


**TOPO AS-BUILT  
ACCESS ROAD**

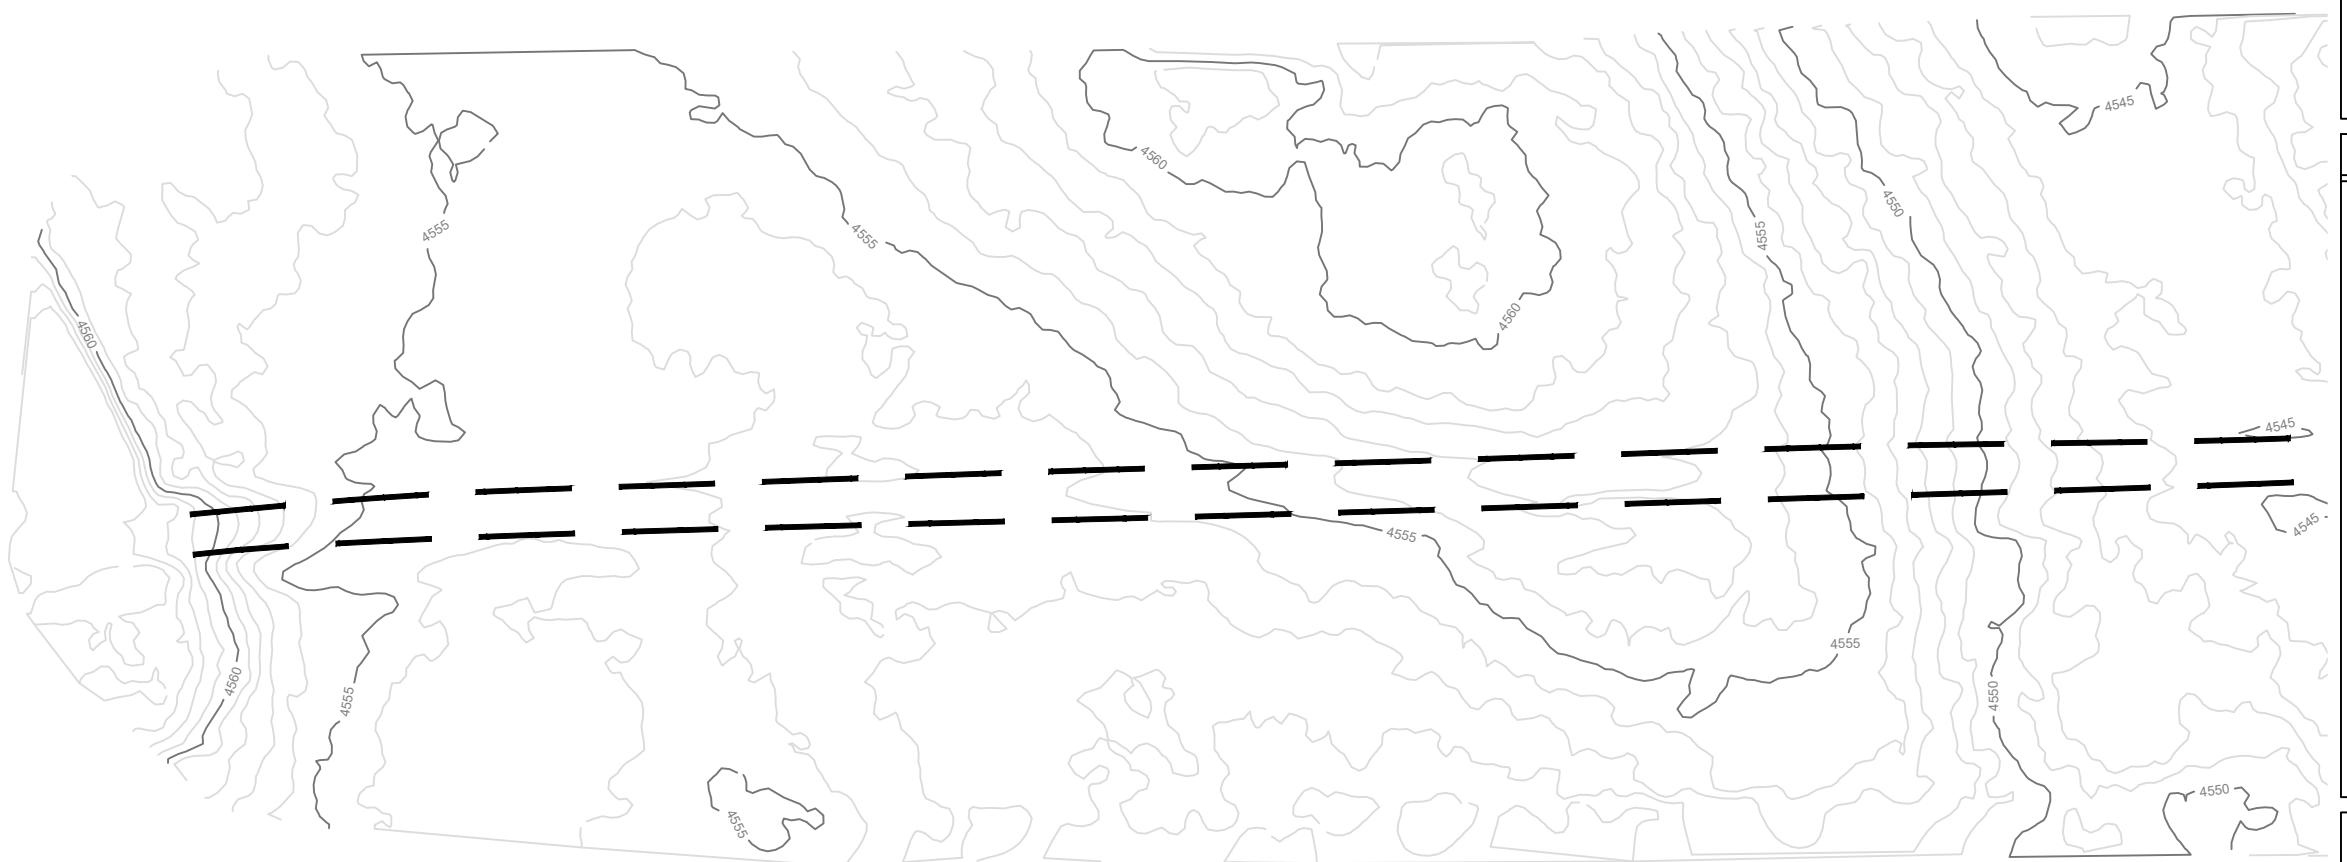

**NOTES**

\*\*UPDATED TOPO DATA COLLECTED BY RPG  
RESOURCES BY USE OF UAV IN SEPTEMBER, 2021\*\*

AREA INSIDE FENCE: 6.98 ACRES  
INT. RECLAMATION PAD FOOTPRINT AREA: 2.05 ACRES  
ACCESS ROAD SURFACE AREA: 0.90 ACRES

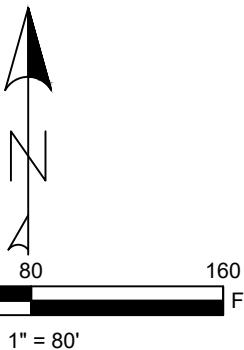

**LEGEND**

- MAJOR CONTOUR
- MINOR CONTOUR
- ACCESS ROAD



**STATE ANTELOPE T-24  
AS-BUILT EXHIBITS**

SECTION 24, TOWNSHIP 5N, RANGE 62W,  
WELD COUNTY, COLORADO

SHEET NAME:	SHEET NO.
ACCESS ROAD TOPO 3	8 OF 8