

AERIAL AS-BUILT
PAD LAYOUT




STATE PRONGHORN 41-32
NENE_32_5N_61W_109736

NOTES

**UPDATED AERIAL ORTHOIMAGERY COLLECTED BY
RPG RESOURCES BY USE OF UAV IN JUNE, 2021**

AREA INSIDE FENCE: 13.4 ACRES

PAD SURFACE AREA: 10.4 ACRES

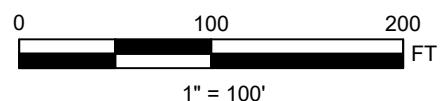

LEGEND

- ACCESS ROAD
- PAD EDGE
- FENCELINE
- WELLHEAD



DRAFT SET
FOR REVIEW
ONLY
6/30/2021

SIGNATURE


DATE

STATE PRONGHORN 41-32
AS-BUILT EXHIBITS

SECTION 32, TOWNSHIP 5N, RANGE 61W,
WELD COUNTY, COLORADO

SHEET NAME:	SHEET NO.
AERIAL IMAGERY	1 OF 2

**TOPO AS-BUILT
PAD LAYOUT**

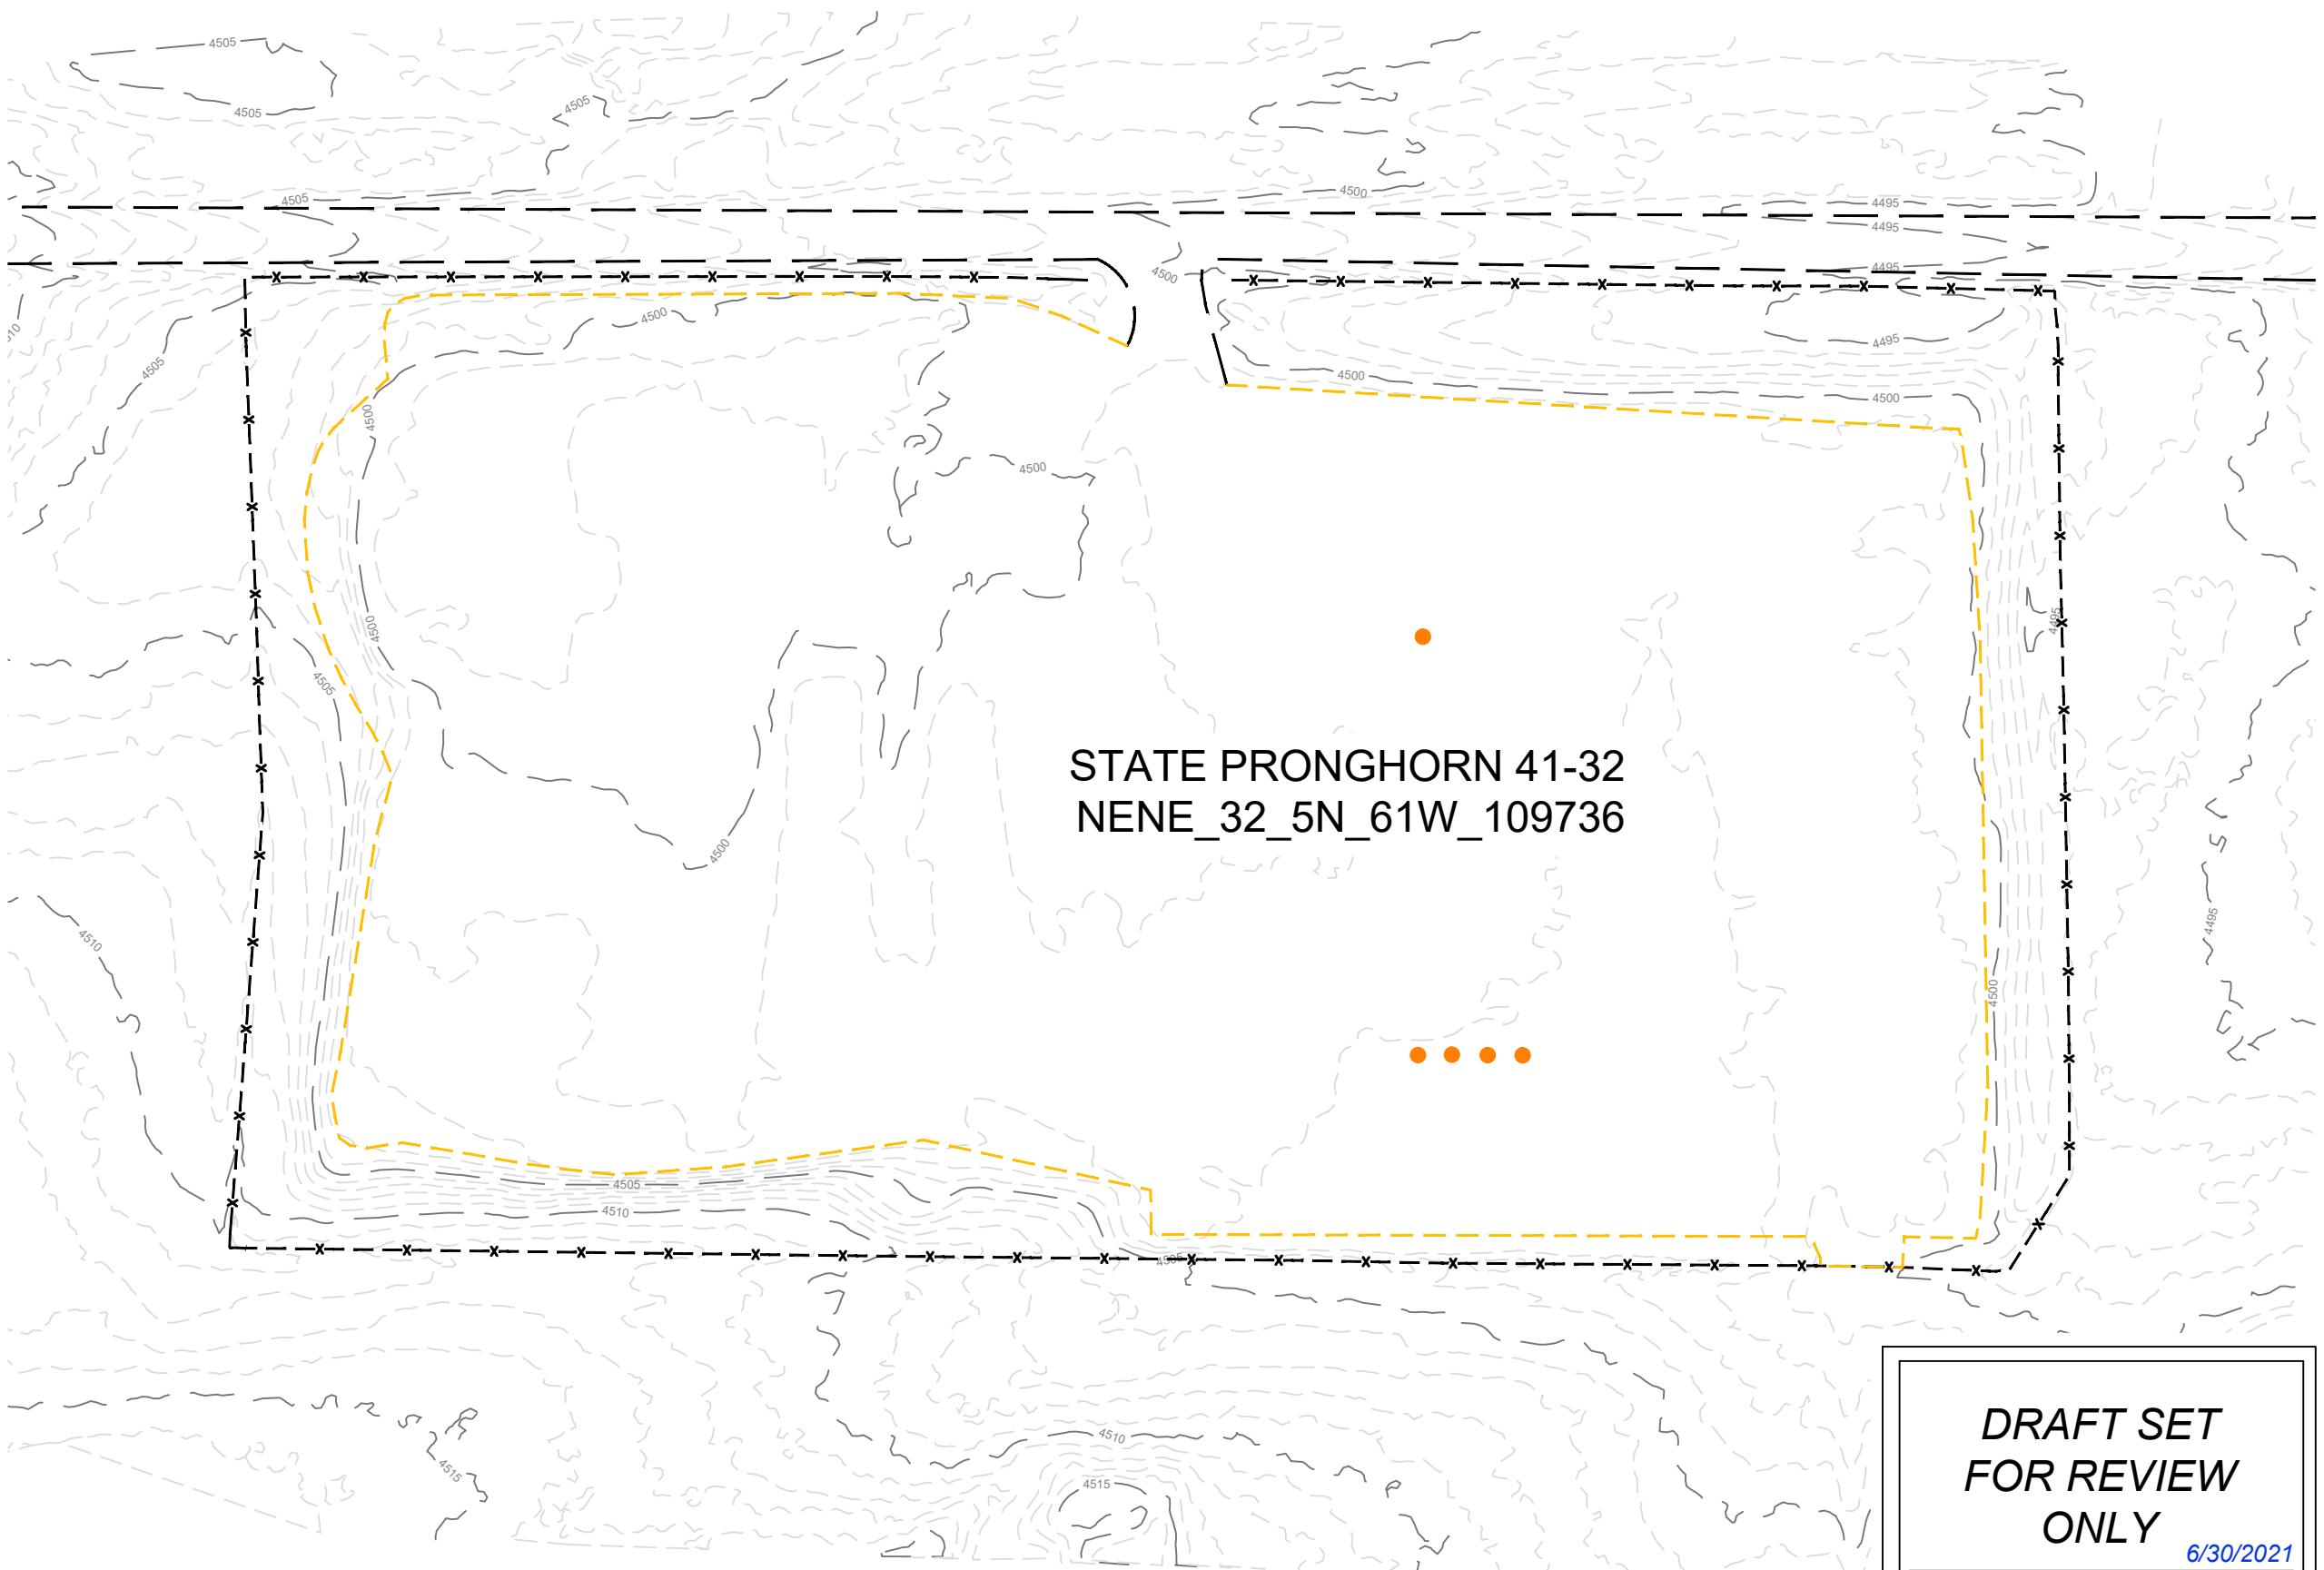

LEGEND

- 4505 — MAJOR CONTOUR
- 4500 — MINOR CONTOUR
- 4500 — ACCESS ROAD
- 4500 — PAD EDGE
- x — FENCELINE
- WELLHEAD



**STATE PRONGHORN 41-32
AS-BUILT EXHIBITS**

SHEET NAME:	SHEET NO.
TOPO OVERVIEW	2 OF 2