

AERIAL AS-BUILT PAD LAYOUT



NOTES

**UPDATED AERIAL ORTHOIMAGERY COLLECTED BY
RPG RESOURCES BY USE OF UAV IN SEPTEMBER,
2021**

FIELD OBSERVED DISTURBED AREA: 5.46 ACRES

INT. RECLAMATION PAD FOOTPRINT AREA: 2.25 ACRES

ACCESS ROAD SURFACE AREA: 0.18 ACRES



0 80 160
FT
1" = 80'

LEGEND

- — — — ACCESS ROAD
- FIELD OBSERVED DISTURBED AREA
- - - PAD EDGE
- WELL HEAD




STATE NORTH PLATTE 41-26 AS-BUILT EXHIBITS

SECTION 26, TOWNSHIP 5N, RANGE 63W,
WELD COUNTY, COLORADO

SHEET NAME:	SHEET NO.
AERIAL IMAGERY	1 OF 2

**TOPO AS-BUILT
PAD LAYOUT**

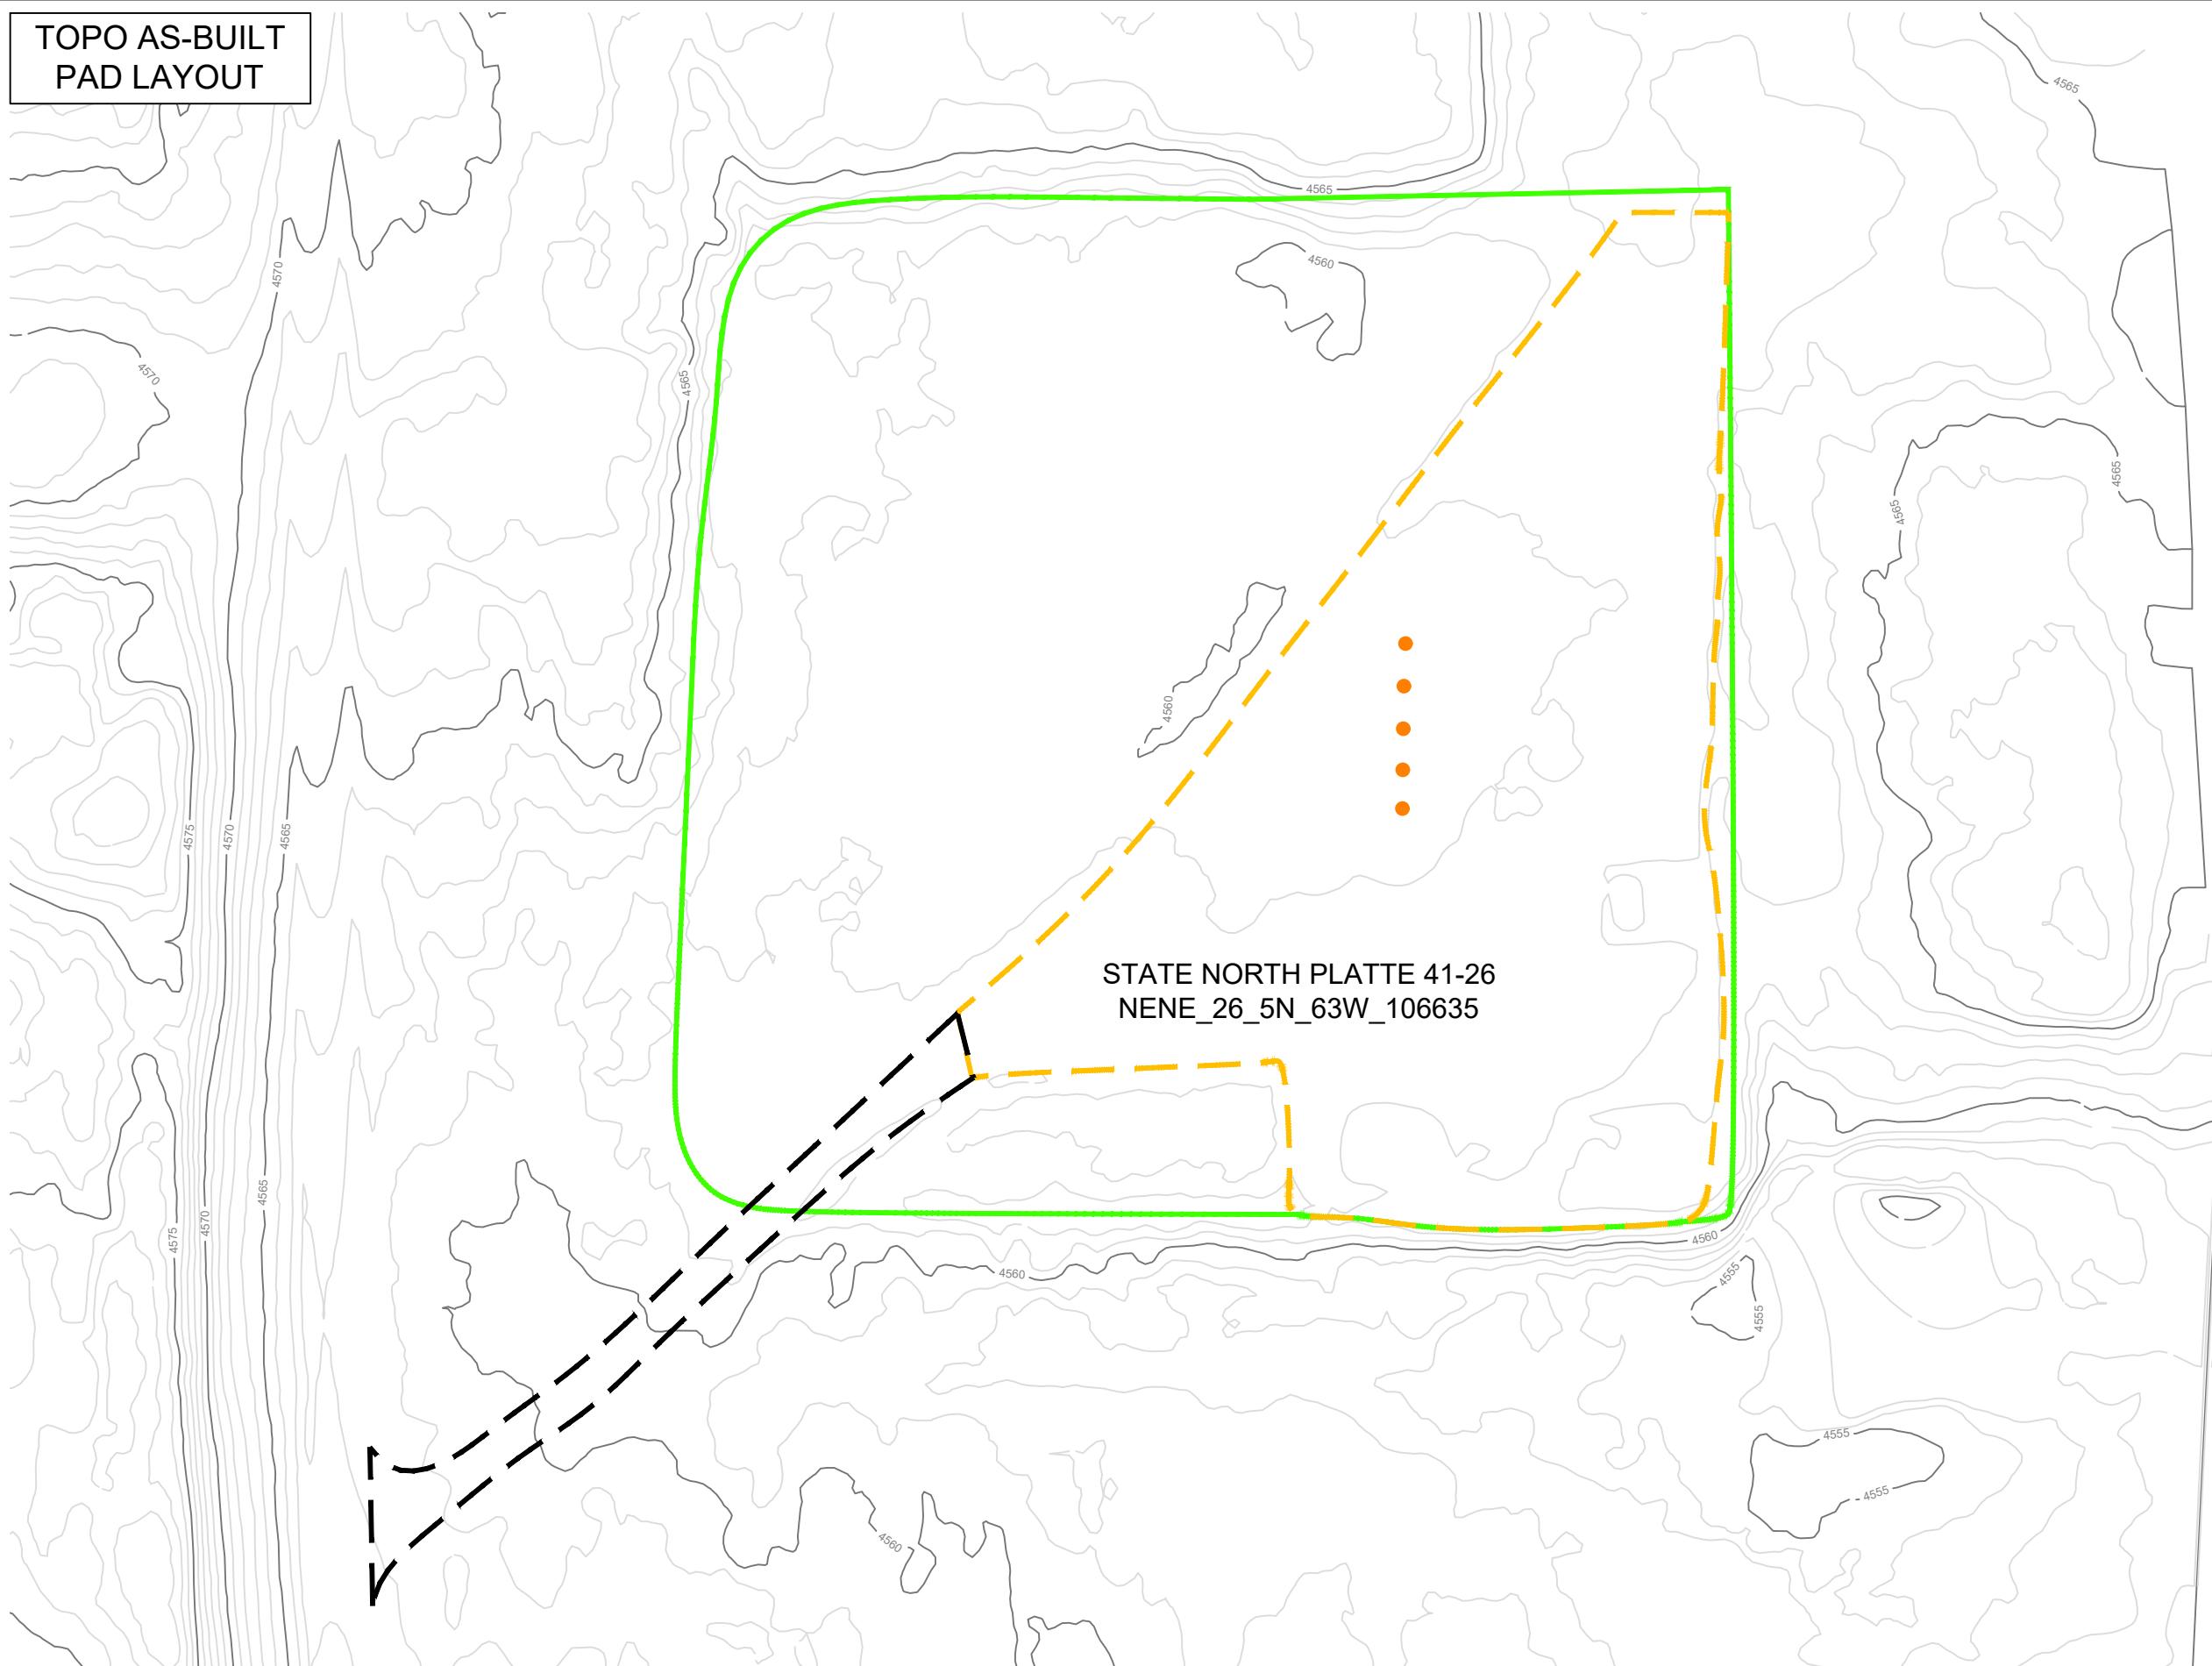

NOTES

**UPDATED TOPO DATA COLLECTED BY RPG
RESOURCES BY USE OF UAV IN SEPTEMBER, 2021**

FIELD OBSERVED DISTURBED AREA: 5.46 ACRES
INT. RECLAMATION PAD FOOTPRINT AREA: 2.25 ACRES
ACCESS ROAD SURFACE AREA: 0.18 ACRES



0 80 160 FT
1" = 80'

LEGEND

- 4500 — MAJOR CONTOUR
- 4550 — MINOR CONTOUR
- - - - - ACCESS ROAD
- - - - - FIELD OBSERVED DISTURBED AREA
- - - - - PAD EDGE
- WELL HEAD



**STATE NORTH PLATTE 41-26
AS-BUILT EXHIBITS**

SECTION 26, TOWNSHIP 5N, RANGE 63W,
WELD COUNTY, COLORADO

SHEET NAME:	SHEET NO.
TOPO OVERVIEW	2 OF 2