


- NOTES:
- PDOP VALUE EQUALS 1.3
 - GPS OPERATOR: RON REINKKE
 - SURVEY DATE (09-08-15)

ACTS ID: 581

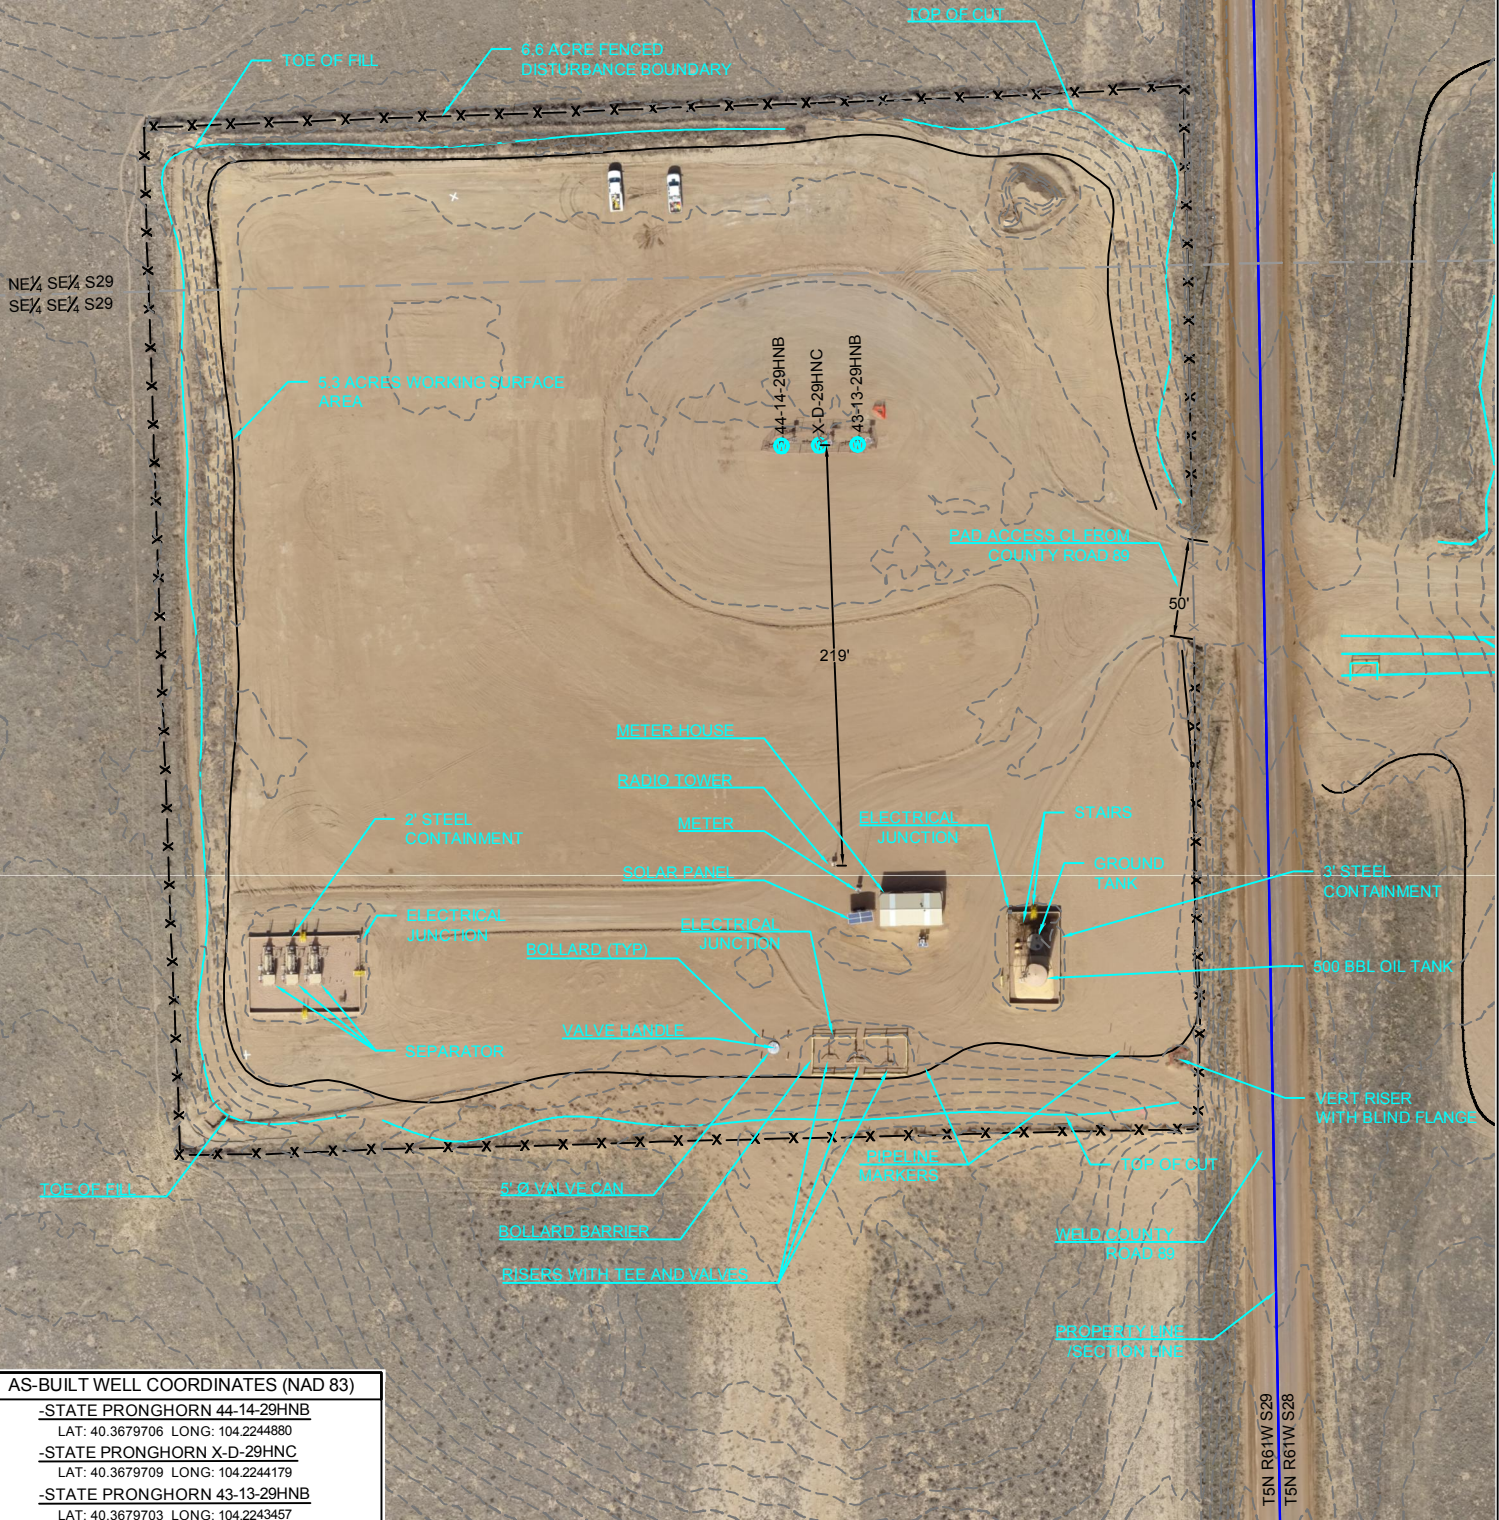

AS-BUILT WELL COORDINATES (NAD 83)

-STATE PRONGHORN 44-14-29HNB
LAT: 40.3679706 LONG: 104.2244880

-STATE PRONGHORN X-D-29HNC
LAT: 40.3679709 LONG: 104.2244179


-STATE PRONGHORN 43-13-29HNB
LAT: 40.3679703 LONG: 104.2243457



WILLIAM H. SMITH & ASSOCIATES, Inc.
155 N. 1st Street
Lander, WY 82520
Phone: 307-335-5646

Drawn By: MAM
Job No.: 2015043
Revision:

Checked By: DAF
Date: 02/10/16

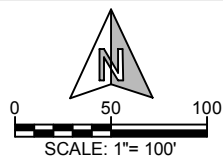

IF BAR LENGTH DOES NOT EQUAL 1" (ONE INCH), THIS PAGE WAS NOT PLOTTED TO THE INTENDED SCALE.

AS-BUILT EXHIBIT

STATE PRONGHORN
X-29 PAD
SE 1/4 SE 1/4, SECTION 29,
T.5N., R.61W., 6th PM
WELD COUNTY, COLORADO



410 17th Street
Denver, CO 80202
(720) 440-6100

SHEET
1
OF
1