

AERIAL AS-BUILT
PAD LAYOUT



NOTES


UPDATED AERIAL ORTHOIMAGERY COLLECTED BY RPG RESOURCES BY USE OF UAV IN AUGUST, 2021

FIELD OBSERVED DISTURBANCE AREA: 5.83 ACRES

AREA INSIDE FENCE: 4.85 ACRES

INT. RECLAMATION PAD FOOTPRINT AREA: 2.67 ACRES

ACCESS RD SURFACE AREA: 0.08 ACRES

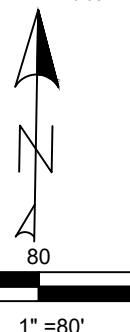

LEGEND

- X— X— FENCE LINE
- FIELD OBSERVED DISTURBANCE AREA
- X— X— ACCESS ROAD
- PAD EDGE
- WELL HEAD




STATE ANTELOPE K-1
AS-BUILT EXHIBITS

SECTION 1, TOWNSHIP 5N, RANGE 62W,
WELD COUNTY, COLORADO

SHEET NAME:	SHEET NO.
AERIAL IMAGERY	1 OF 2

TOPO AS-BUILT PAD LAYOUT

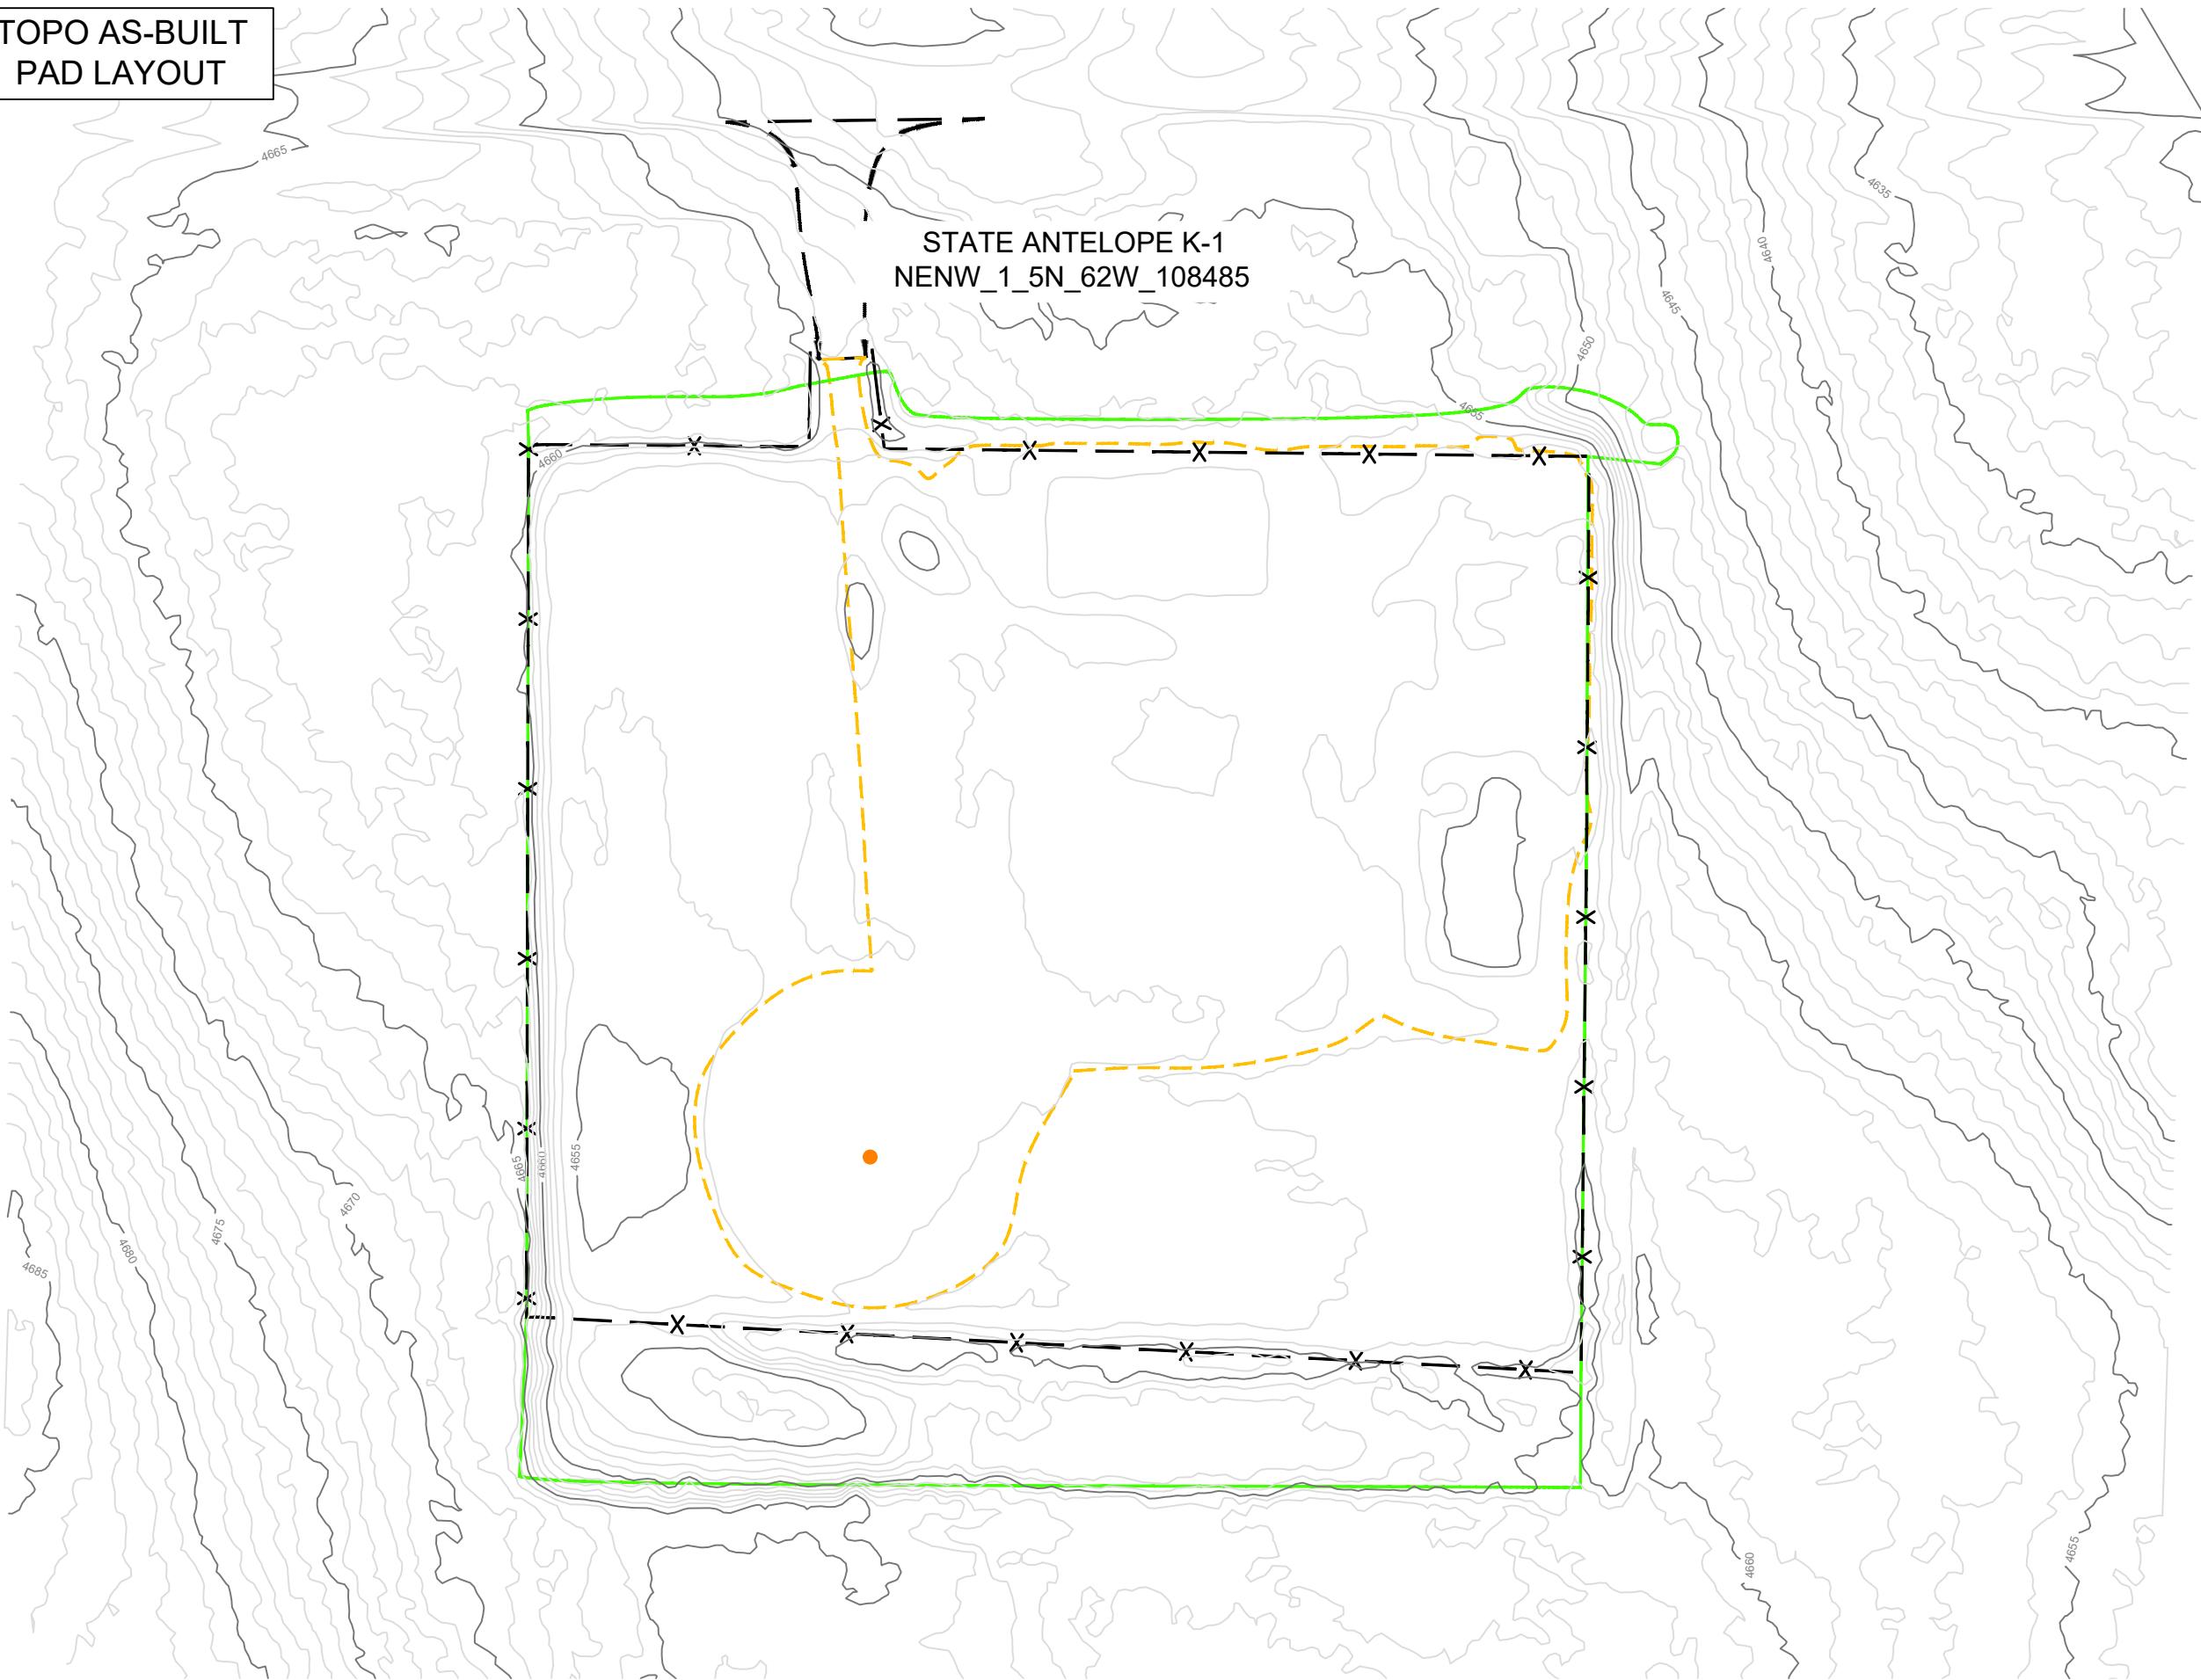

NOTES


****UPDATED AERIAL ORTHOIMAGERY COLLECTED BY
RPG RESOURCES BY USE OF UAV IN AUGUST, 2021****

FIELD OBSERVED DISTURBANCE AREA: 5.83 ACRES

AREA INSIDE FENCE: 4.85 ACRES

INT. RECLAMATION PAD FOOTPRINT AREA: 2.67 ACRES

ACCESS RD SURFACE AREA: 0.08 ACRES

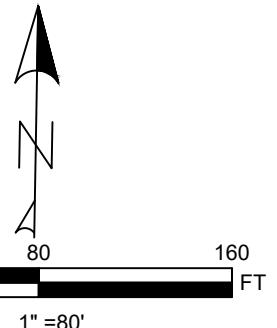

LEGEND

- A legend containing seven entries, each consisting of a short horizontal line segment followed by a descriptive label. The symbols are: a black line for 'MAJOR CONTOUR', a grey line for 'MINOR CONTOUR', a black dashed line with 'X' marks for 'FENCE LINE', a green line for 'APPARENT MAX DISTURBANCE', a black dashed line for 'ACCESS ROAD', a yellow dashed line for 'PAD EDGE', and an orange circle for 'WELL HEAD'.



RPG
RESOURCES

**STATE ANTELOPE K-1
AS-BUILT EXHIBITS**

SECTION 1, TOWNSHIP 5N, RANGE 62W,
WELD COUNTY, COLORADO

SHEET NAME:	SHEET NO.
TOPO OVERVIEW	2 OF 2