


AERIAL AS-BUILT PAD LAYOUT

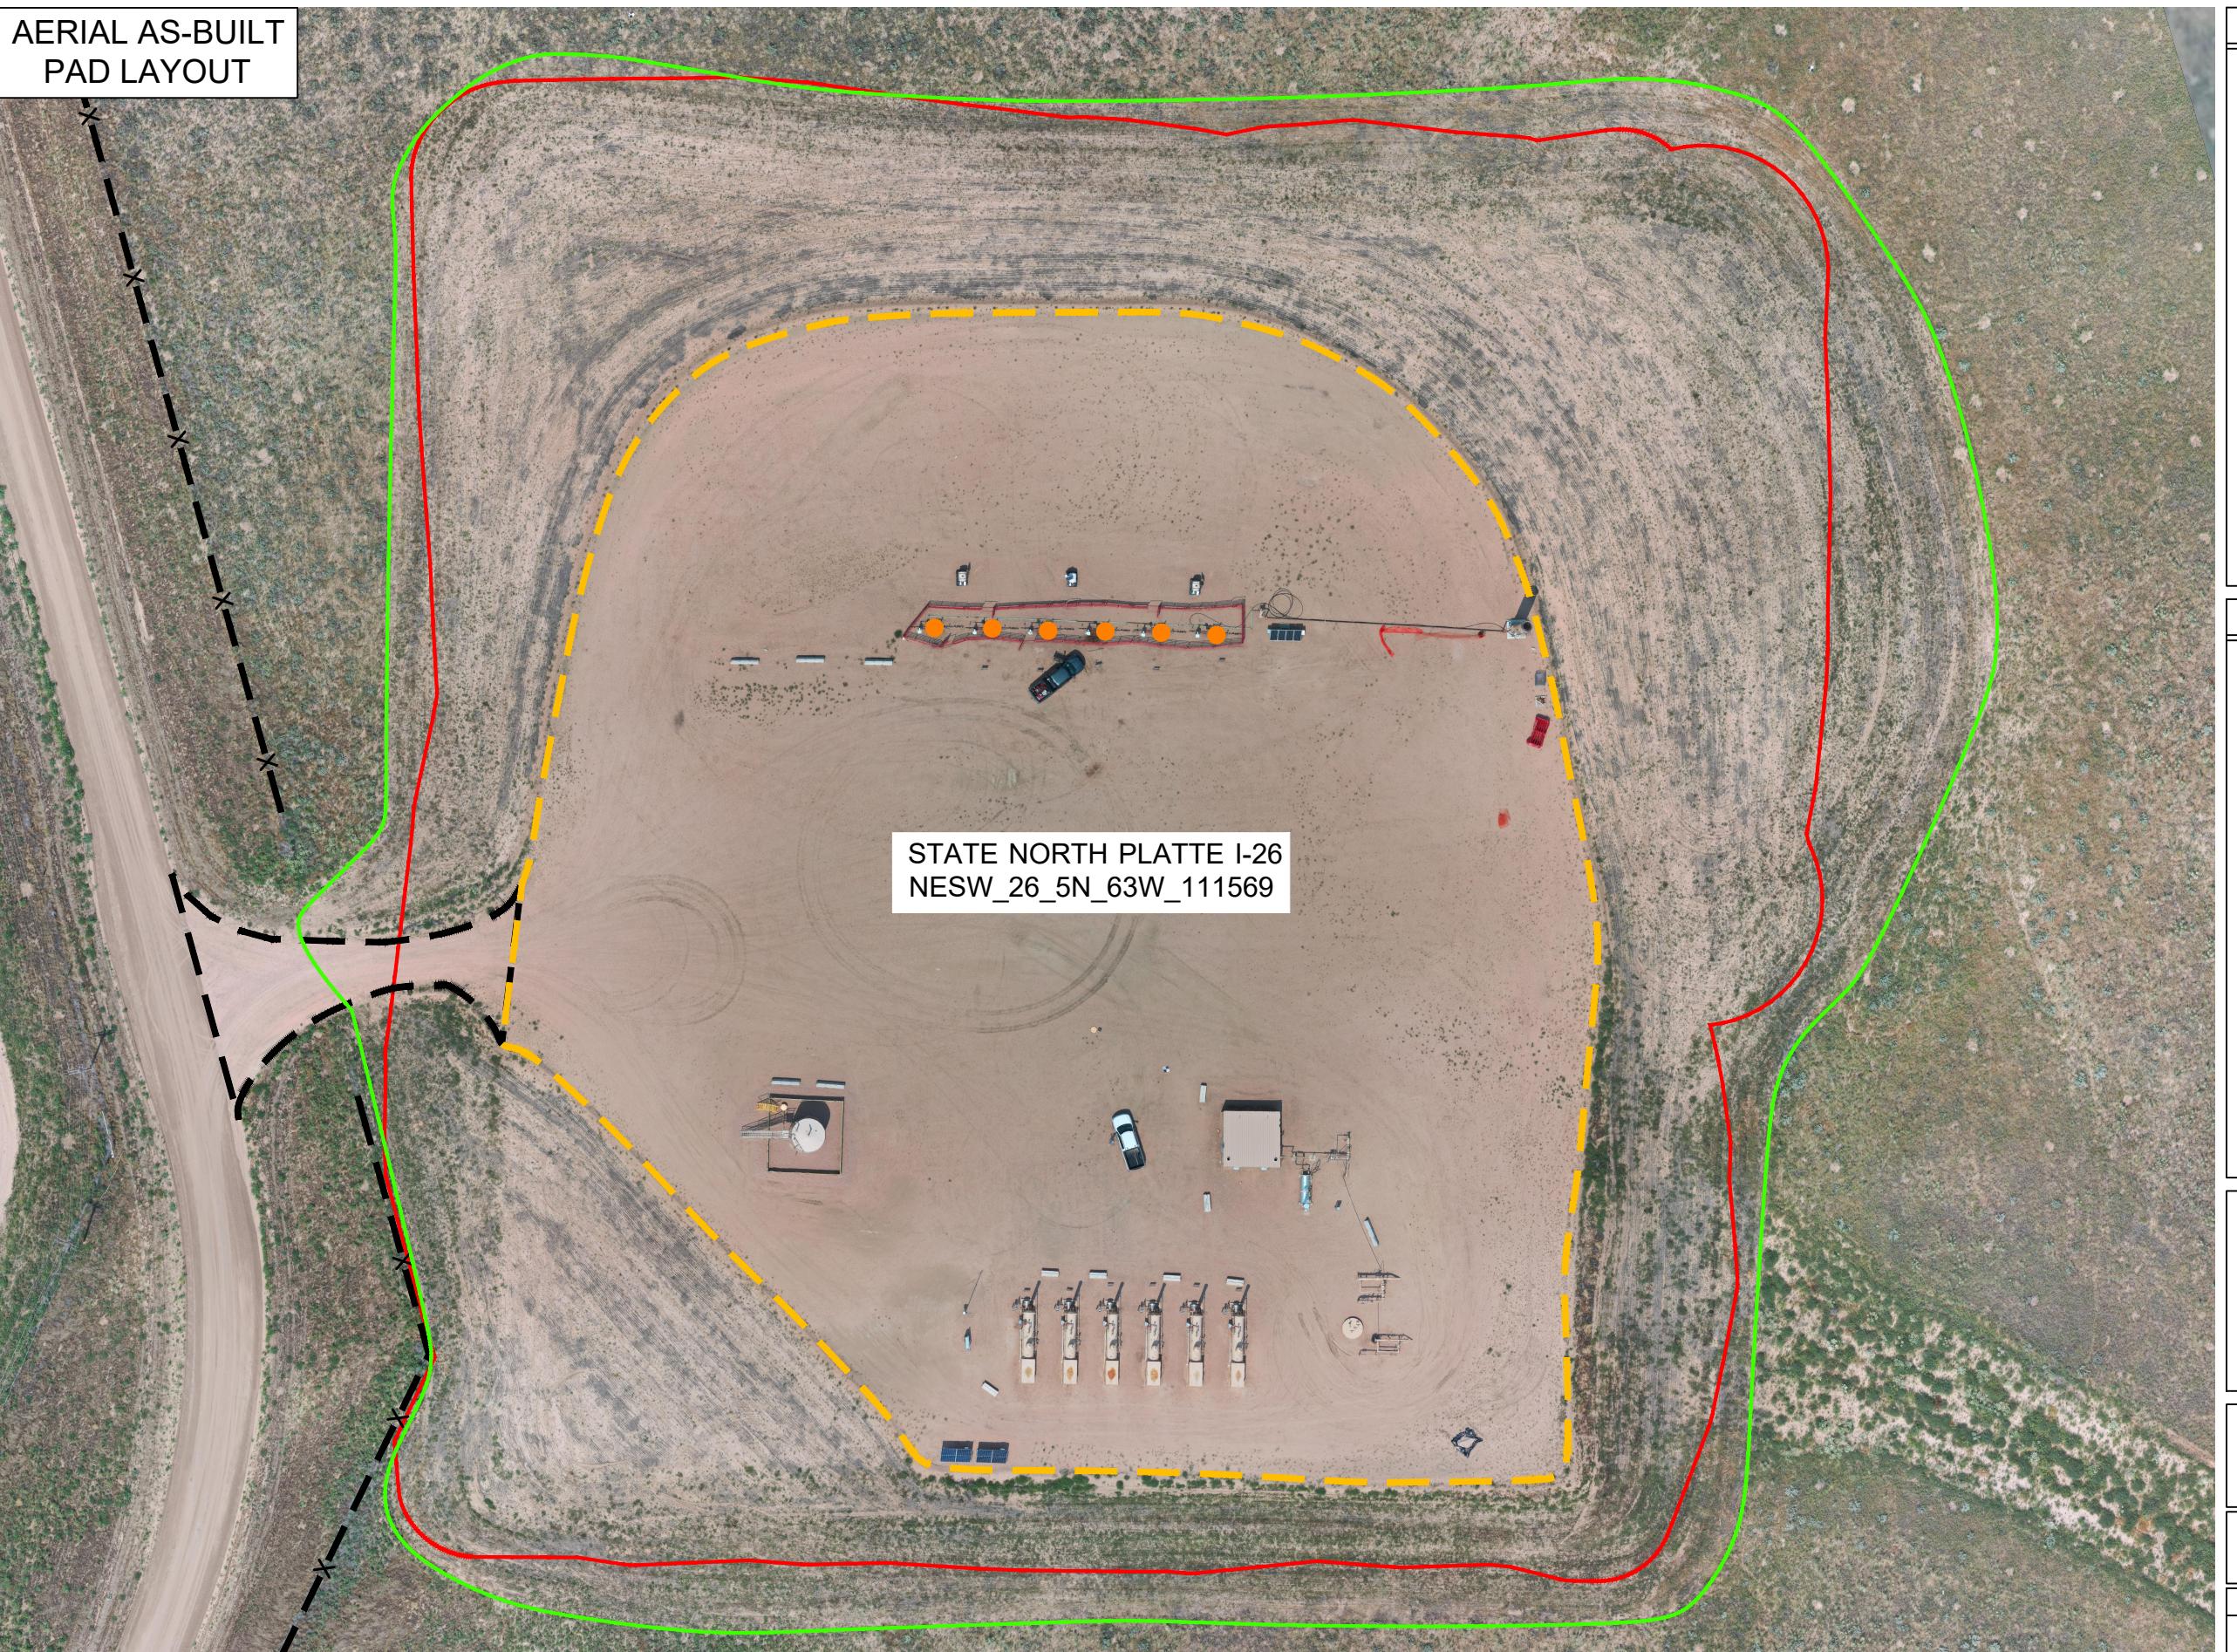


NOTES

UPDATED AERIAL ORTHOIMAGERY COLLECTED BY RPG RESOURCES BY USE OF UAV IN AUGUST, 2021

FIELD OBSERVED DISTURBED AREA : 6.64 ACRES

INT. RECLAMATION PAD FOOTPRINT AREA: 3.08 ACRES

ACCESS ROAD SURFACE AREA: 0.08 ACRES

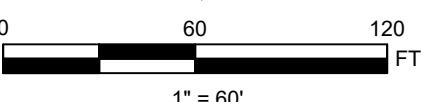

LEGEND

- ACCESS ROAD
- FENCE LINE
- PERMITTED MAX DISTURBANCE
- FIELD OBSERVED DISTURBED AREA
- PAD EDGE
- WELL HEAD




STATE NORTH PLATTE I-26 AS-BUILT EXHIBITS

SECTION 26, TOWNSHIP 5N, RANGE 63W,
WELD COUNTY, COLORADO

SHEET NAME:	SHEET NO.
AERIAL IMAGERY	1 OF 2

**TOPO AS-BUILT
PAD LAYOUT**

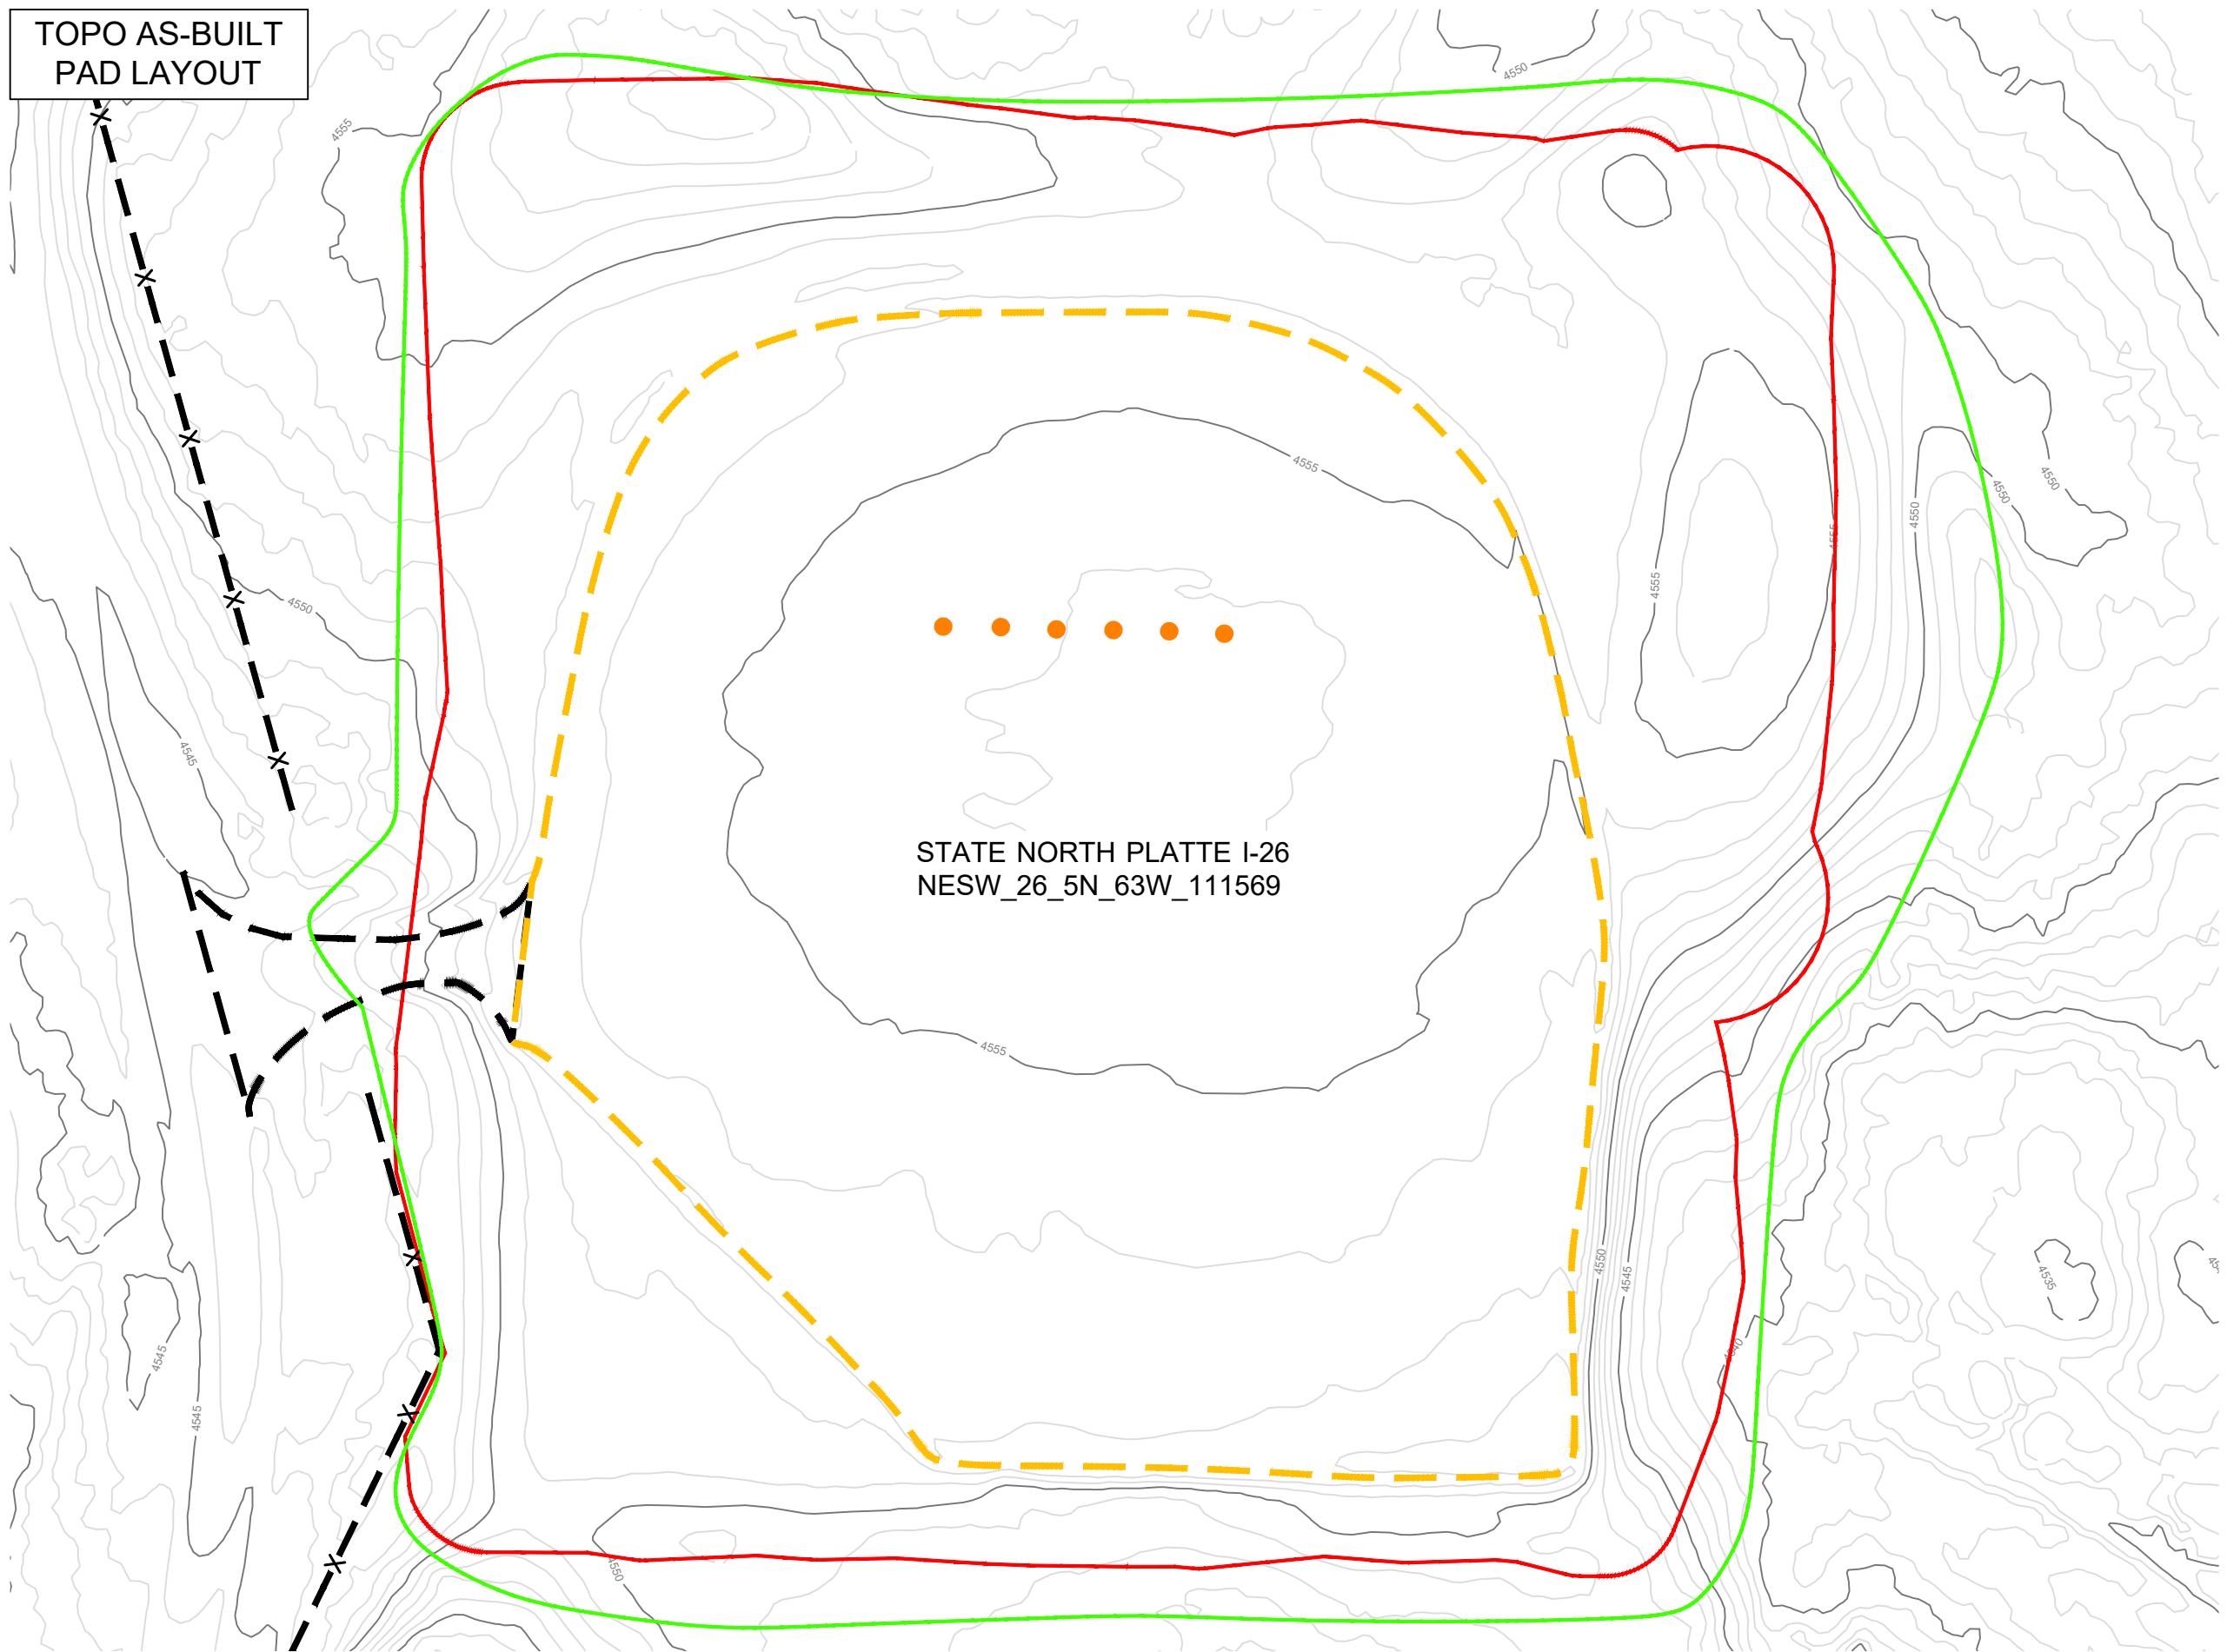

NOTES

**UPDATED TOPO DATA COLLECTED BY RPG
RESOURCES BY USE OF UAV IN AUGUST, 2021**

FIELD OBSERVED DISTURBED AREA : 6.64 ACRES
INT. RECLAMATION PAD FOOTPRINT AREA: 3.08 ACRES
ACCESS ROAD SURFACE AREA: 0.08 ACRES



0 60 120
1" = 60'
FT

LEGEND

- 4505 — MAJOR CONTOUR
- 4550 — MINOR CONTOUR
- - - - - ACCESS ROAD
- - - X - - FENCE LINE
- PERMITTED MAX DISTURBANCE
- FIELD OBSERVED DISTURBED AREA
- - - - - PAD EDGE
- WELL HEAD



**STATE NORTH PLATTE I-26
AS-BUILT EXHIBITS**

SECTION 26, TOWNSHIP 5N, RANGE 63W,
WELD COUNTY, COLORADO

SHEET NAME:	SHEET NO.
TOPO OVERVIEW	2 OF 2