

AERIAL AS-BUILT PAD LAYOUT




NOTES

UPDATED AERIAL ORTHOIMAGERY COLLECTED BY RPG RESOURCES BY USE OF UAV IN AUGUST, 2021

AREA INSIDE FENCE: 5.31 ACRES

INT. RECLAMATION PAD FOOTPRINT AREA: 1.10 ACRES

ACCESS ROAD SURFACE AREA: 0.03 ACRES

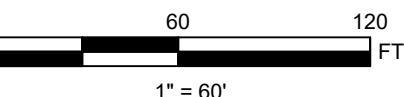

LEGEND

- Access Road
- Fence Line
- Pad Edge
- Well Head




STATE ANTELOPE 11-2HZ AS-BUILT EXHIBITS

SECTION 2, TOWNSHIP 5N, RANGE 62W,
WELD COUNTY, COLORADO

SHEET NAME:	SHEET NO.
AERIAL IMAGERY	1 OF 2

**TOPO AS-BUILT
PAD LAYOUT**

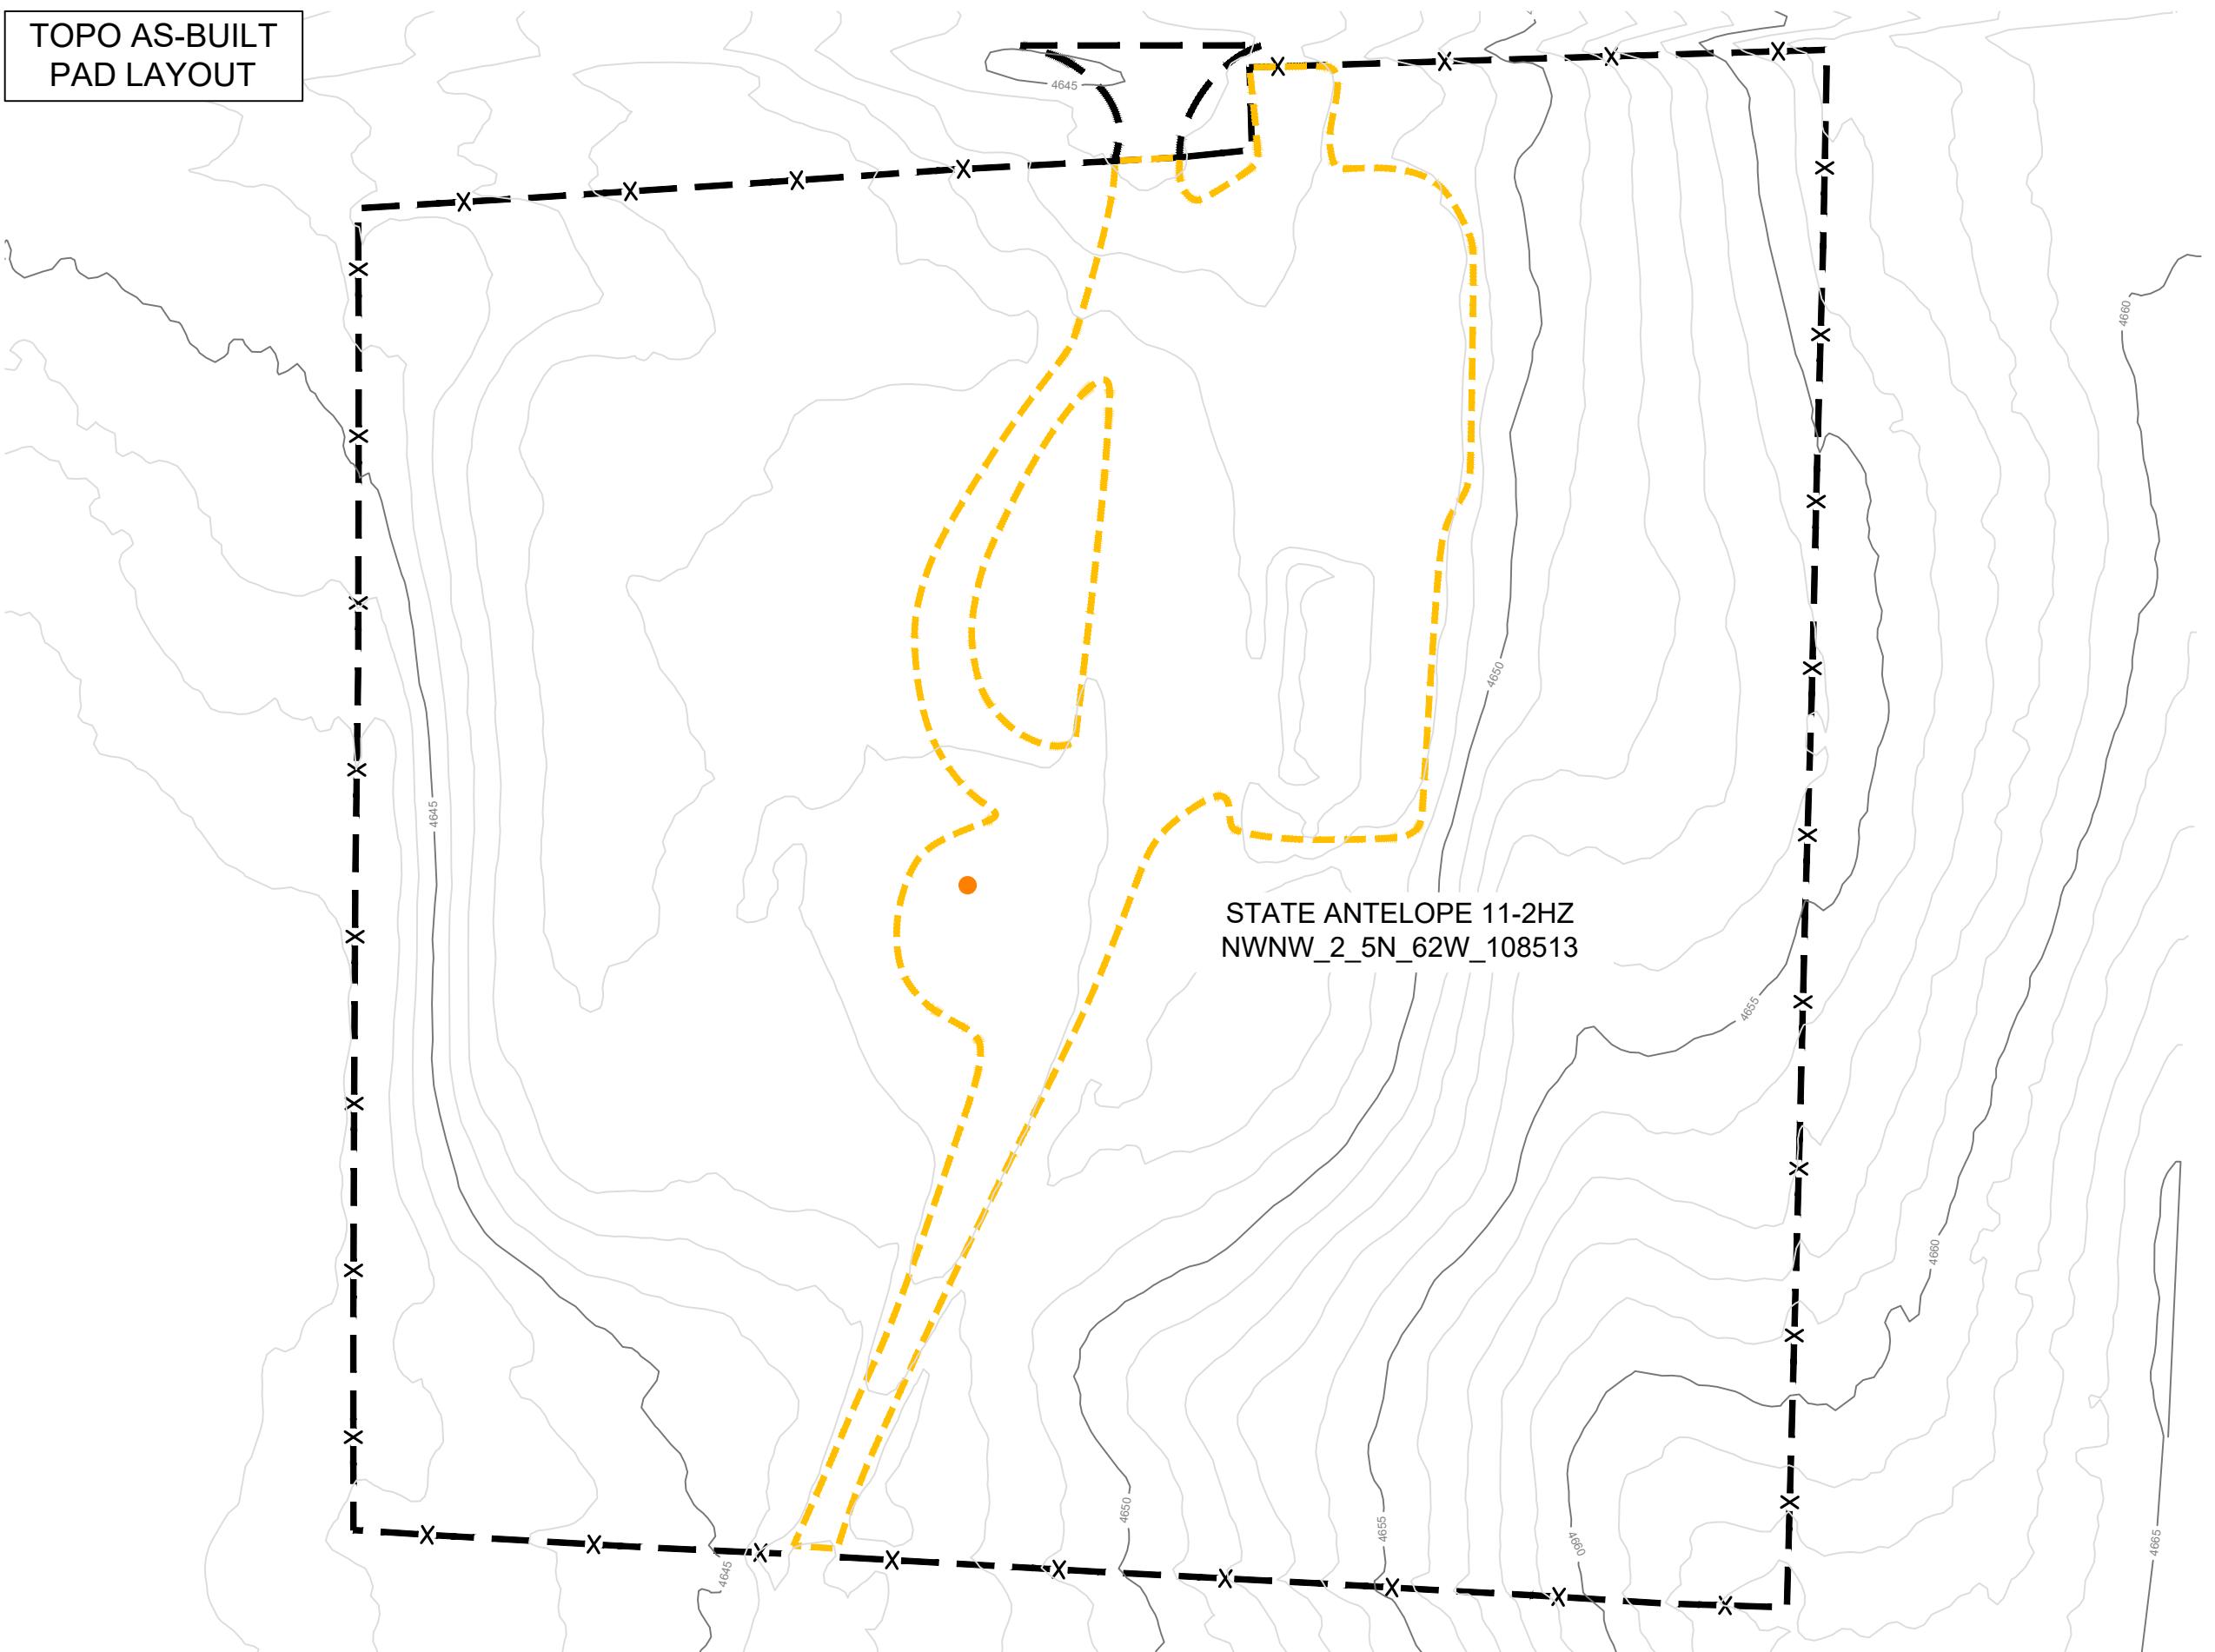

NOTES

UPDATED TOPO DATA COLLECTED BY RPG RESOURCES BY USE OF UAV IN AUGUST, 2021

AREA INSIDE FENCE: 5.31 ACRES
INT. RECLAMATION PAD FOOTPRINT AREA: 0.26 ACRES
ACCESS ROAD SURFACE AREA: 0.03 ACRES



0 60 120 FT
1" = 60'

LEGEND

- 4680 — MAJOR CONTOUR
- 4645 — MINOR CONTOUR
- - - - - ACCESS ROAD
- x-x- FENCE LINE
- - - - - PAD EDGE
- WELL HEAD



**STATE ANTELOPE 11-2HZ
AS-BUILT EXHIBITS**

SECTION 2, TOWNSHIP 5N, RANGE 62W,
WELD COUNTY, COLORADO

SHEET NAME:	SHEET NO.
TOPO OVERVIEW	2 OF 2