


- NOTES:
- PDOP VALUE EQUALS 1.3
  - GPS OPERATOR: RON REINKKE.
  - SURVEY DATE (09-08-15)

ACTS ID: 581

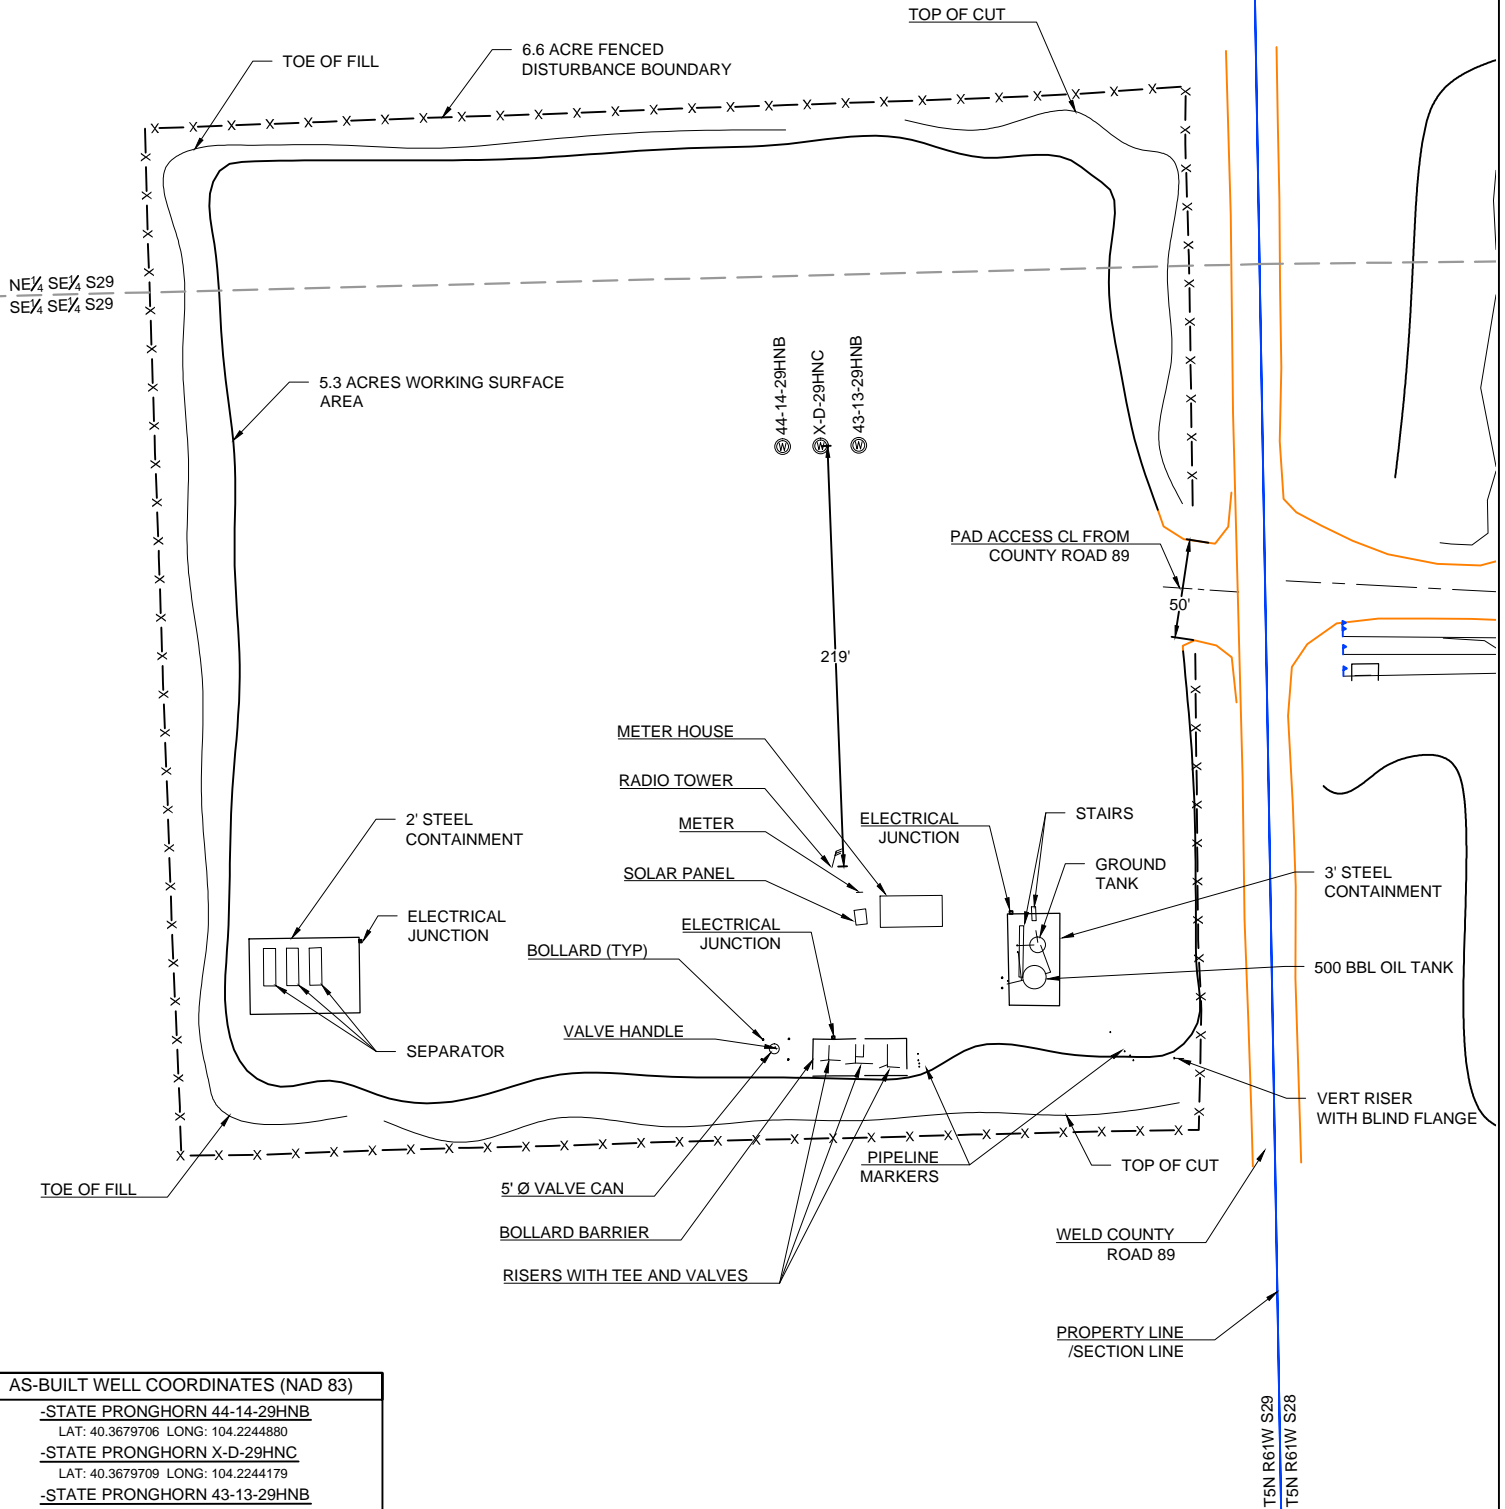

AS-BUILT WELL COORDINATES (NAD 83)

STATE PRONGHORN 44-14-29HNB  
LAT: 40.3679706 LONG: 104.2244880

STATE PRONGHORN X-D-29HNC  
LAT: 40.3679709 LONG: 104.2244179


STATE PRONGHORN 43-13-29HNB  
LAT: 40.3679703 LONG: 104.2243457



**WILLIAM H. SMITH & ASSOCIATES, Inc.**  
155 N. 1st Street  
Lander, WY 82520  
Phone: 307-335-5646

Drawn By: MAM  
Job No.: 2015043  
Revision:

Checked By: DAF  
Date: 02/10/16

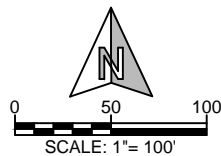

IF BAR LENGTH DOES NOT EQUAL 1"(ONE INCH), THIS PAGE WAS NOT PLOTTED TO THE INTENDED SCALE.

AS-BUILT EXHIBIT

STATE PRONGHORN  
X-29 PAD  
SE¼ SE¼, SECTION 29,  
T.5N., R.61W., 6th PM  
WELD COUNTY, COLORADO



410 17th Street  
Denver, CO 80202  
(720) 440-6100

SHEET  
1  
OF  
1