

## AERIAL AS-BUILT PAD LAYOUT




## NOTES

\*\*UPDATED AERIAL ORTHOIMAGERY & TOPO DATA  
COLLECTED BY RPG RESOURCES BY USE OF UAV IN  
AUGUST, 2021\*\*

AREA INSIDE FENCE: 8.18 ACRES

INT. RECLAMATION PAD FOOTPRINT AREA: 1.48 ACRES

ACCESS RD SURFACE AREA: 0.26 ACRES

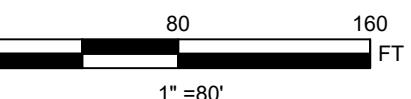

## LEGEND

- FENCE LINE
- ACCESS ROAD
- PAD EDGE
- WELL HEAD



## STATE ANTELOPE P-32 AS-BUILT EXHIBITS

SECTION 32, TOWNSHIP 5N, RANGE 62W,  
WELD COUNTY, COLORADO

SHEET NAME:	SHEET NO.
AERIAL IMAGERY	1 OF 4

**TOPO AS-BUILT  
PAD LAYOUT**



**NOTES**

\*\*UPDATED AERIAL ORTHOIMAGERY & TOPO DATA  
COLLECTED BY RPG RESOURCES BY USE OF UAV IN  
AUGUST, 2021\*\*

AREA INSIDE FENCE: 8.18 ACRES

INT. RECLAMATION PAD FOOTPRINT AREA: 1.48 ACRES

ACCESS RD SURFACE AREA: 0.26 ACRES



0 80 160  
1" = 80' FT

**LEGEND**

- 4600 — MAJOR CONTOUR
- 4585 — MINOR CONTOUR
- x-x- FENCE LINE
- - - ACCESS ROAD
- - - PAD EDGE
- WELL HEAD



**STATE ANTELOPE P-32  
AS-BUILT EXHIBITS**

SECTION 32, TOWNSHIP 5N, RANGE 62W,  
WELD COUNTY, COLORADO

SHEET NAME:	SHEET NO.
TOPO OVERVIEW	2 OF 4

AERIAL AS-BUILT  
ACCESS ROAD




NOTES

\*\*UPDATED AERIAL ORTHOIMAGERY & TOPO DATA  
COLLECTED BY RPG RESOURCES BY USE OF UAV IN  
AUGUST, 2021\*\*

AREA INSIDE FENCE: 8.18 ACRES

INT. RECLAMATION PAD FOOTPRINT AREA: 1.48 ACRES

ACCESS RD SURFACE AREA: 0.26 ACRES

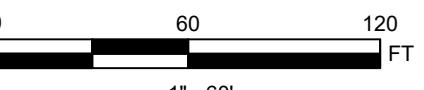

LEGEND

- x-x-x- FENCE LINE
- - - - - ACCESS ROAD




STATE ANTELOPE P-32  
AS-BUILT EXHIBITS

SECTION 32, TOWNSHIP 5N, RANGE 62W,  
WELD COUNTY, COLORADO

SHEET NAME:	SHEET NO.
ACCESS ROAD AERIAL	3 OF 4

**TOPO AS-BUILT  
ACCESS ROAD**

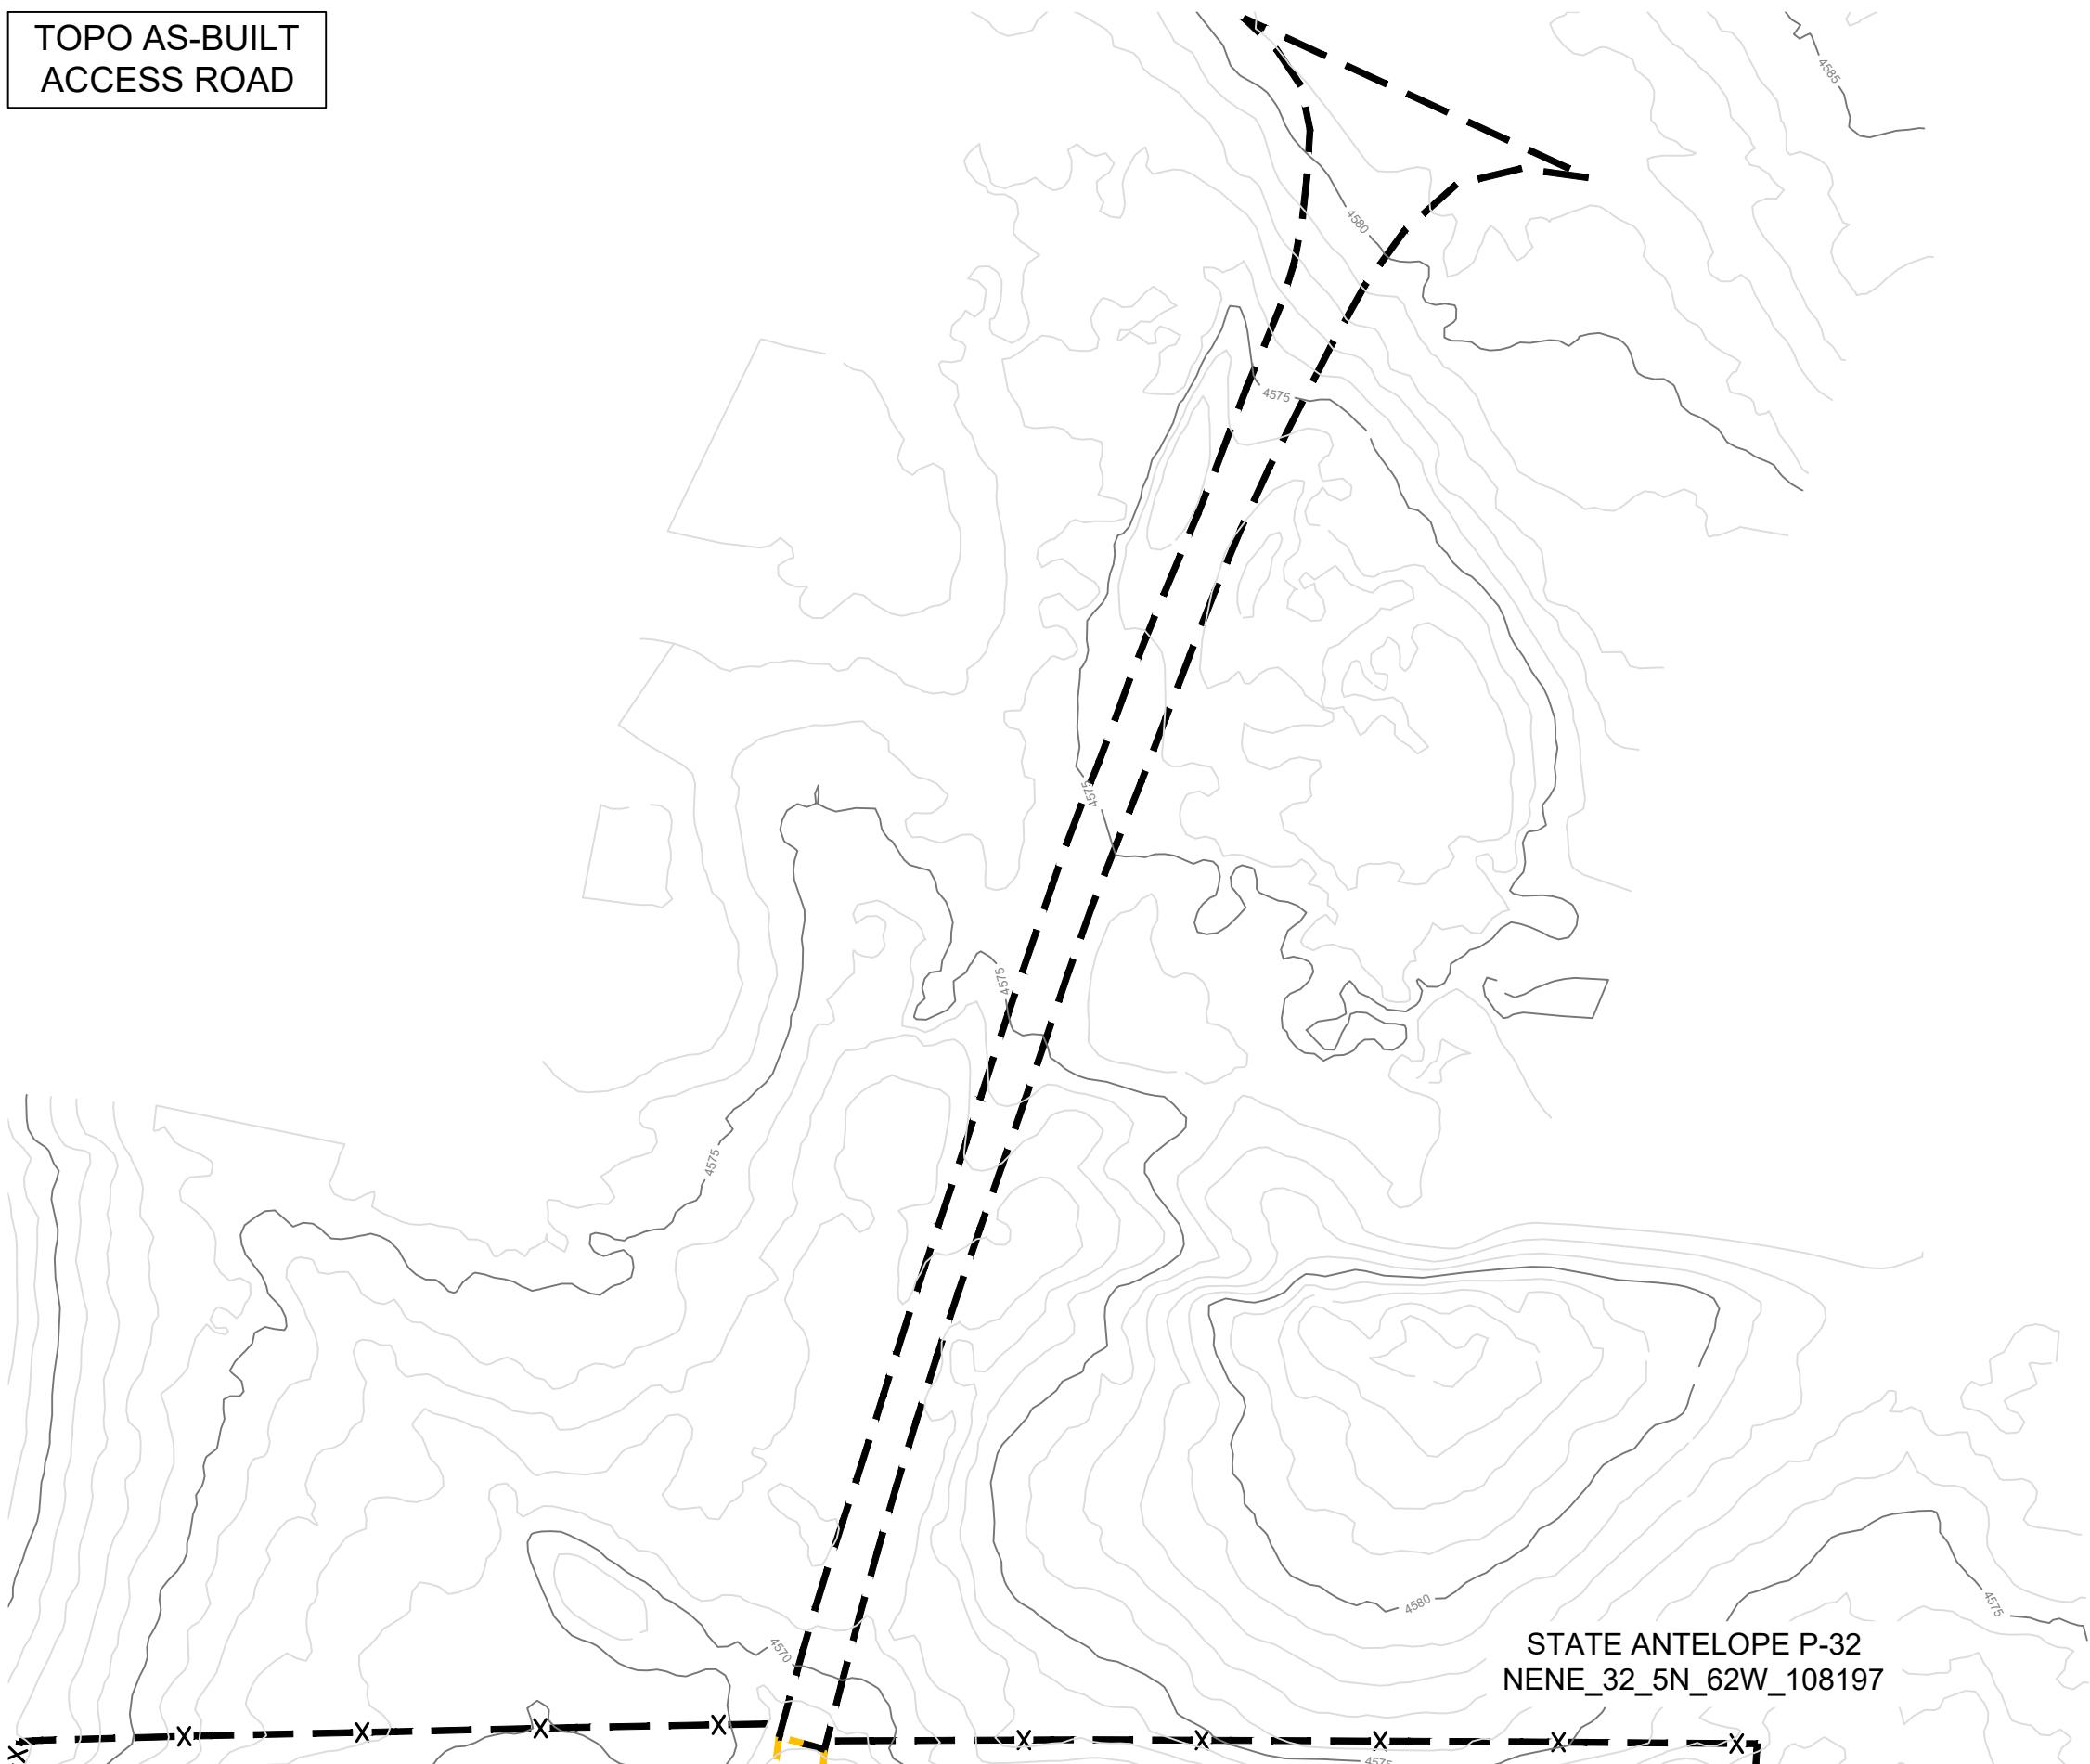


**NOTES**

\*\*UPDATED AERIAL ORTHOIMAGERY & TOPO DATA  
COLLECTED BY RPG RESOURCES BY USE OF UAV IN  
AUGUST, 2021\*\*

AREA INSIDE FENCE: 8.18 ACRES

INT. RECLAMATION PAD FOOTPRINT AREA: 1.48 ACRES

ACCESS RD SURFACE AREA: 0.26 ACRES

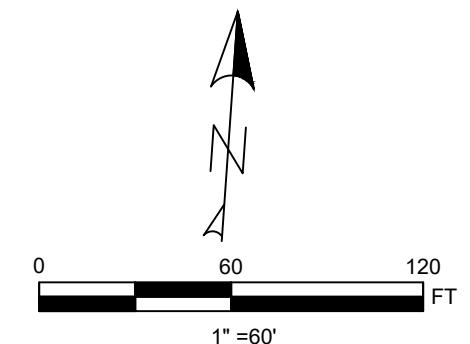

**LEGEND**

- 4600 — MAJOR CONTOUR
- 4575 — MINOR CONTOUR
- x-x- FENCE LINE
- - - - ACCESS ROAD



**STATE ANTELOPE P-32  
AS-BUILT EXHIBITS**

SECTION 32, TOWNSHIP 5N, RANGE 62W,  
WELD COUNTY, COLORADO

SHEET NAME:	SHEET NO.
ACCESS ROAD TOPO	4 OF 4