




1. EXISTING UTILITIES DISPLAYED ON THE GRADING PLAN ARE FOR REFERENCE PURPOSES ONLY. PRIOR TO CONSTRUCTION OR EARTHWORK, CONTRACTOR WILL BE RESPONSIBLE TO CALL FOR LOCATES: (800) 922-1987

TOTAL DISTURBANCE (WELL PAD & ACCESS ROADS) = ±5.26 ACRES

	EXISTING WELL LOCATION
	PROPOSED WELL LOCATION
	EXISTING CONTOURS (2' INTERVAL)
	PROPOSED CONTOURS (2' INTERVAL)
	EXISTING PIPELINE
	PROPOSED PIPELINE
	EXISTING FENCE

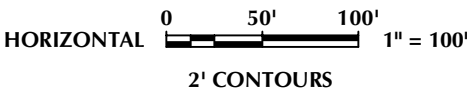

REVISED: 1 OF 2

**WELL PAD - STATE ANTELOPE B-2
AS-BUILT
ACTS ID 676
LOCATED IN SECTION 2
T5N, R62W, 6TH P.M.
WELD COUNTY, COLORADO**

LOVELAND OFFICE
1635 Foxtrail Drive, Suite 204
Loveland, Colorado 80538
Phone 970-776-4331

SHERIDAN OFFICE
1095 Saberton Avenue
Sheridan, Wyoming 82801
Phone 307-674-0609

CONSULTING, LLC