

AERIAL AS-BUILT PAD LAYOUT




NOTES

UPDATED AERIAL ORTHOIMAGERY COLLECTED BY RPG RESOURCES BY USE OF UAV IN AUGUST, 2021

AREA INSIDE FENCE: 6.95 ACRES

INT. RECLAMATION PAD FOOTPRINT AREA: 0.79 ACRES

ACCESS ROAD SURFACE AREA: 0.09 ACRES

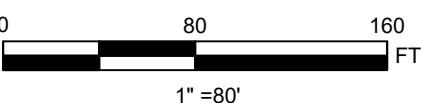

LEGEND

- ACCESS ROAD
- FENCE LINE
- PAD EDGE
- WELL HEAD




STATE WHITETAIL O-36 AS-BUILT EXHIBITS

SECTION 36, TOWNSHIP 6N, RANGE 62W,
WELD COUNTY, COLORADO

SHEET NAME:	SHEET NO.
AERIAL IMAGERY	1 OF 2

**TOPO AS-BUILT
PAD LAYOUT**

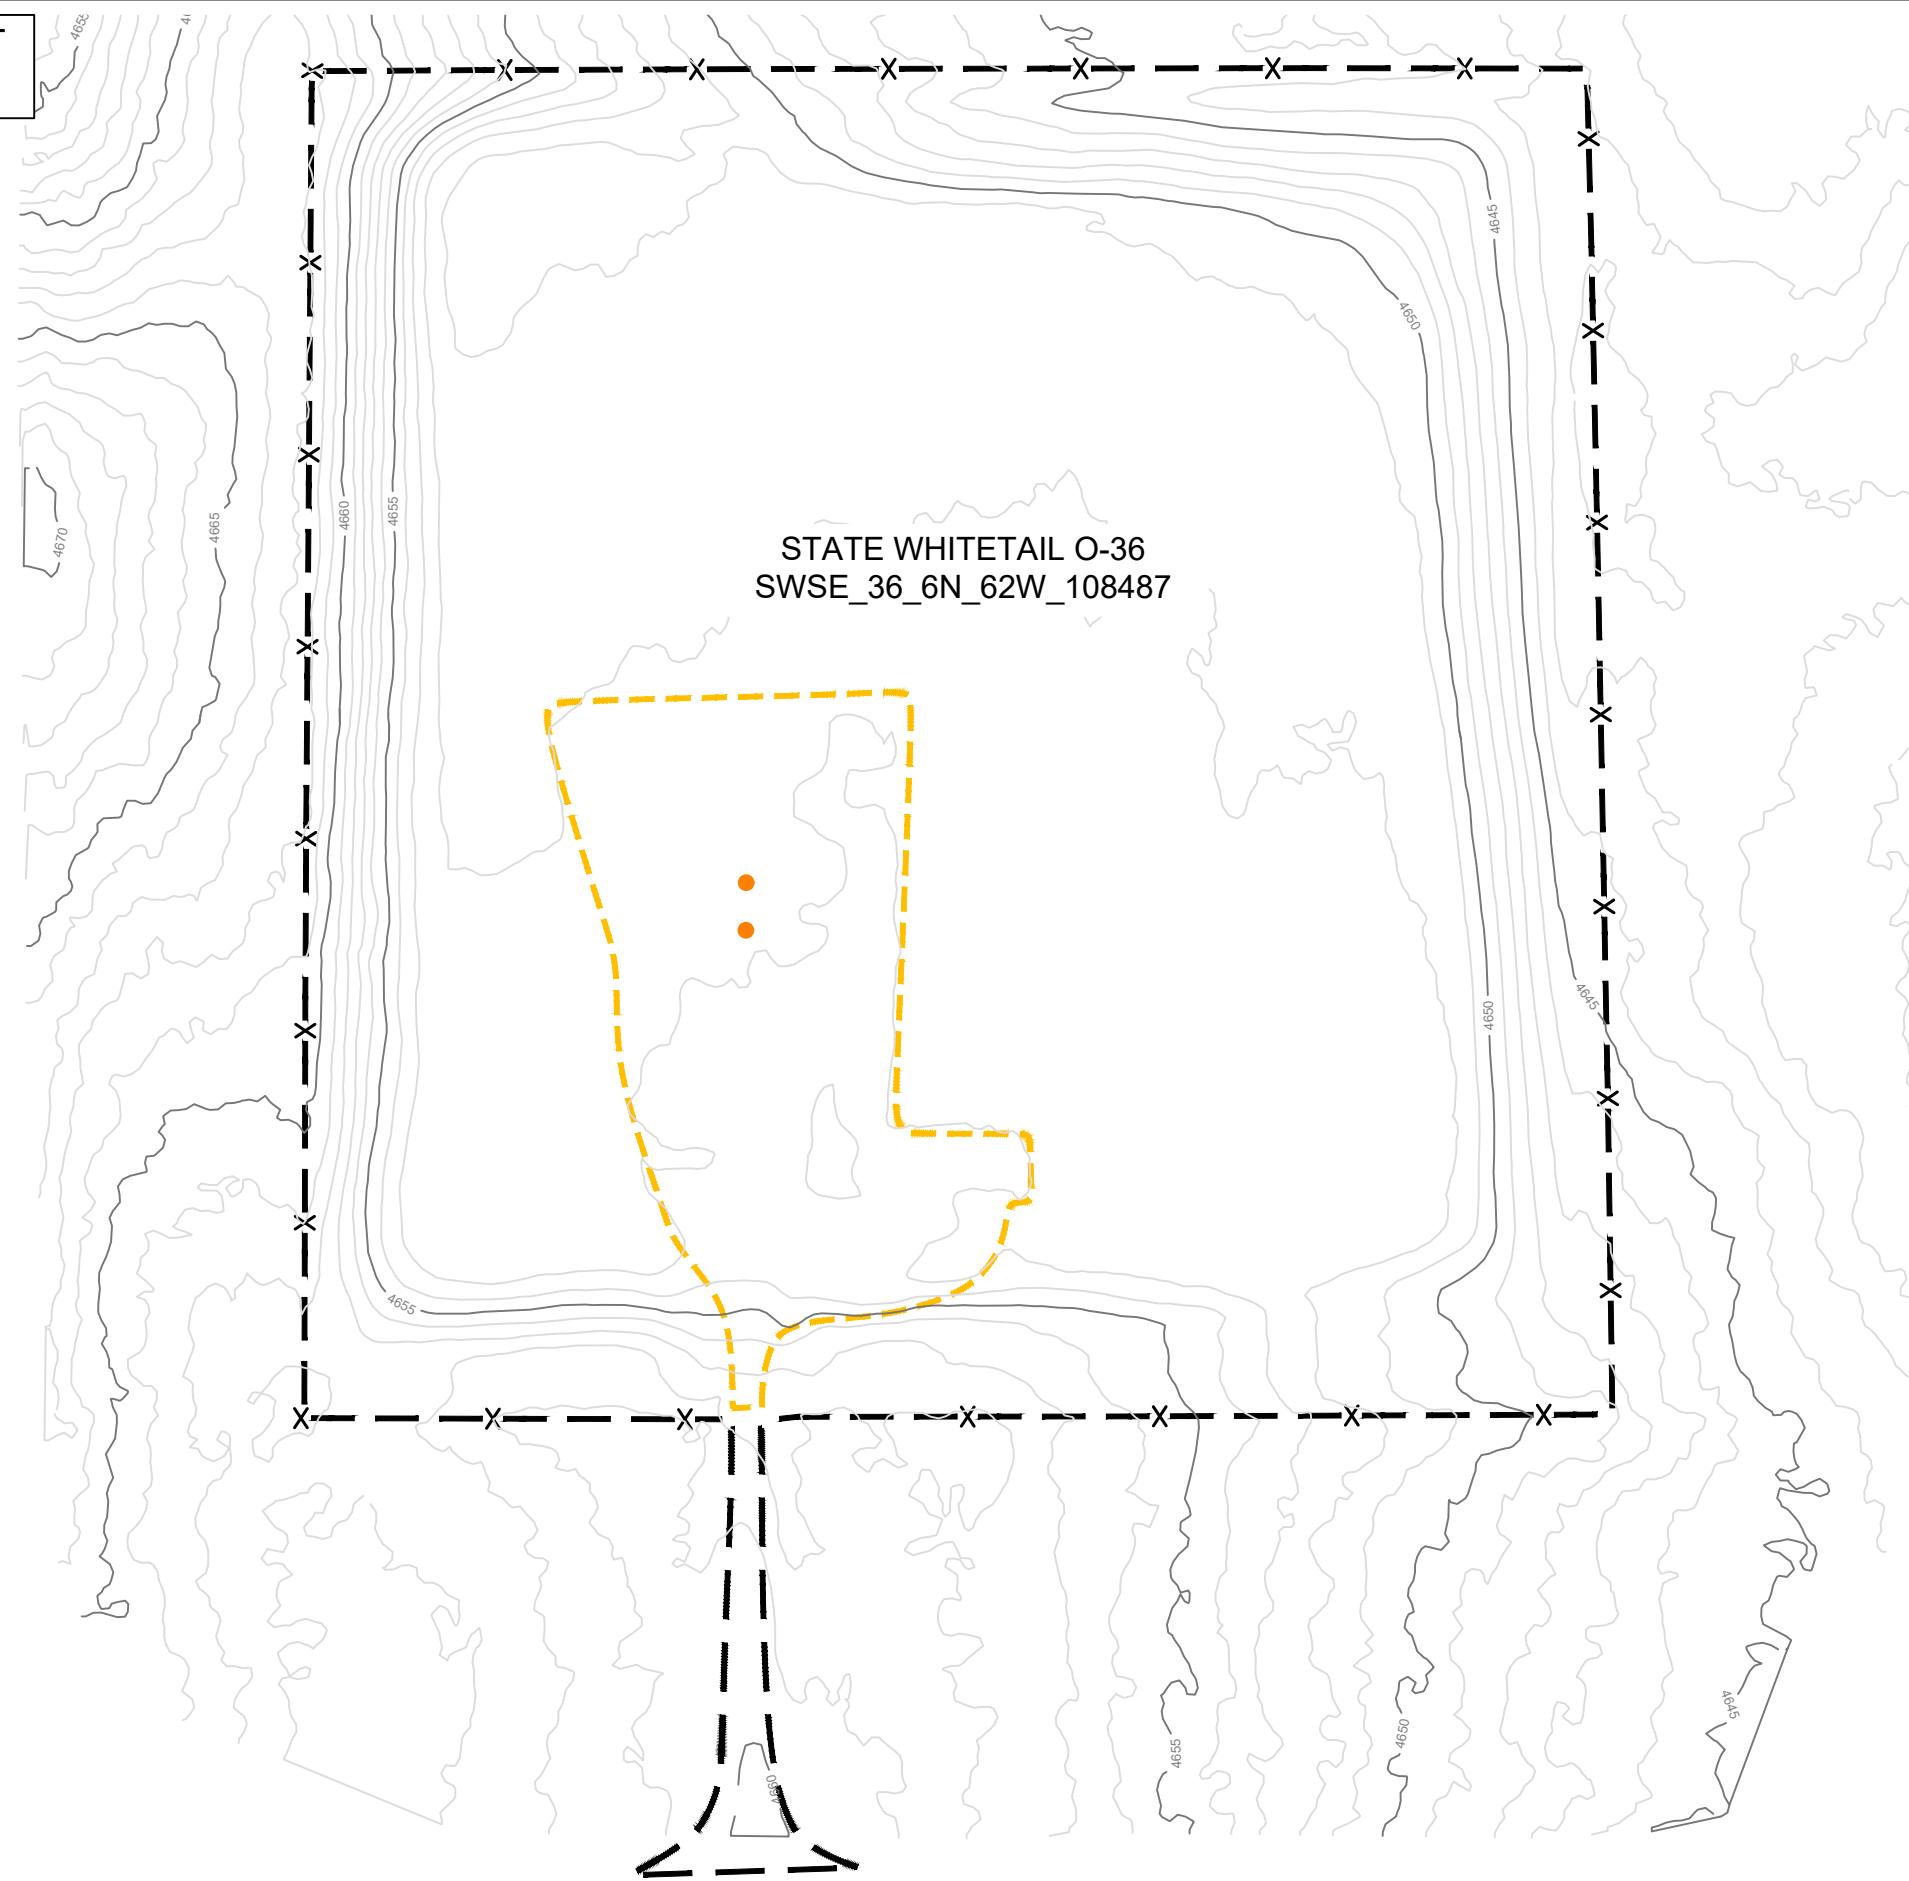

NOTES

UPDATED TOPO DATA COLLECTED BY RPG RESOURCES BY USE OF UAV IN AUGUST, 2021

AREA INSIDE FENCE: 6.95 ACRES
INT. RECLAMATION PAD FOOTPRINT AREA: 0.79 ACRES
ACCESS ROAD SURFACE AREA: 0.09 ACRES



0 80 160 FT
1" = 80'

LEGEND

- 4600 — MAJOR CONTOUR
- 4605 — MINOR CONTOUR
- - - - - ACCESS ROAD
- - - - - FENCE LINE
- - - - - PAD EDGE
- WELL HEAD



**STATE WHITETAIL O-36
AS-BUILT EXHIBITS**

SECTION 36, TOWNSHIP 6N, RANGE 62W,
WELD COUNTY, COLORADO

SHEET NAME:	SHEET NO.
TOPO OVERVIEW	2 OF 2