

**STATE ANTELOPE 43-13
AS BUILT EXHIBIT**

5N, 62W, SECTION 13, WELD COUNTY,
COLORADO

SHEET NAME: ACCESS ROAD	SHEET NO.: 1 OF 3
----------------------------	----------------------

AERIAL AS-BUILT PAD LAYOUT



NOTES


UPDATED AERIAL ORTHOIMAGERY COLLECTED BY RPG RESOURCES BY USE OF UAV IN AUGUST, 2020

ACCESS ROAD LENGTH: ~ 2458 LINEAR FEET

ACCESS ROAD AREA ~ 1.3 ACRES

AREA INSIDE FENCE: 8.4 ACRES

PAD SURFACE AREA: 4.9 ACRES

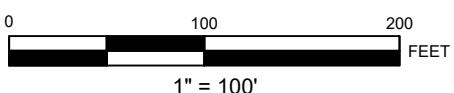

LEGEND

- X— —X— EXISTING FENCE
- EXISTING EDGE OF PAD
- —— EXISTING ACCESS ROAD
- EXISTING WELL HEAD



STATE ANTELOPE 43-13 AS BUILT EXHIBIT

5N, 62W, SECTION 13, WELD COUNTY,
COLORADO

SHEET NAME: AERIAL IMAGERY	SHEET NO.: 2 OF 3
-------------------------------	----------------------

TOPO AS-BUILT PAD LAYOUT



NOTES


UPDATED AERIAL ORTHOIMAGERY COLLECTED BY RPG RESOURCES BY USE OF UAV IN AUGUST, 2020

ACCESS ROAD LENGTH: ~ 2458 LINEAR FEET

ACCESS ROAD AREA ~ 1.3 ACRES

AREA INSIDE FENCE: 8.4 ACRES

PAD SURFACE AREA: 4.9 ACRES

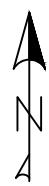

0 100 200 FEET
1" = 100'

LEGEND

- 4605 — EXISTING MAJOR CONTOUR
- 4605 — EXISTING MINOR CONTOUR
- X-X- EXISTING FENCE
- - - - EXISTING EDGE OF PAD
- - - - EXISTING ACCESS ROAD
- EXISTING WELL HEAD



STATE ANTELOPE 43-13 AS BUILT EXHIBIT

5N, 62W, SECTION 13, WELD COUNTY,
COLORADO

SHEET NAME:	SHEET NO.:
TOPO OVERVIEW	3 OF 3