


AERIAL AS-BUILT  
PAD LAYOUT



NOTES

\*\*UPDATED AERIAL ORTHOIMAGERY COLLECTED BY  
RPG RESOURCES BY USE OF UAV IN AUGUST, 2020\*\*

ACCESS ROAD: ~1,251 LINEAR FEET  
AREA INSIDE FENCE: 11.0 ACRES  
SURFACE AREA OF PAD: 7.7 ACRES

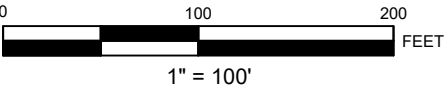

LEGEND

- EXISTING FENCE
- EXISTING EDGE OF PAD
- EXISTING ACCESS ROAD
- EXISTING WELL HEAD





STATE ANTELOPE 34-12  
AS BUILT EXHIBIT

5N, 62W, SECTION 12, WELD COUNTY,  
COLORADO

SHEET NAME: AERIAL IMAGERY	SHEET NO.: 1 OF 2
-------------------------------	----------------------



TOPO AS-BUILT  
PAD LAYOUT

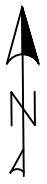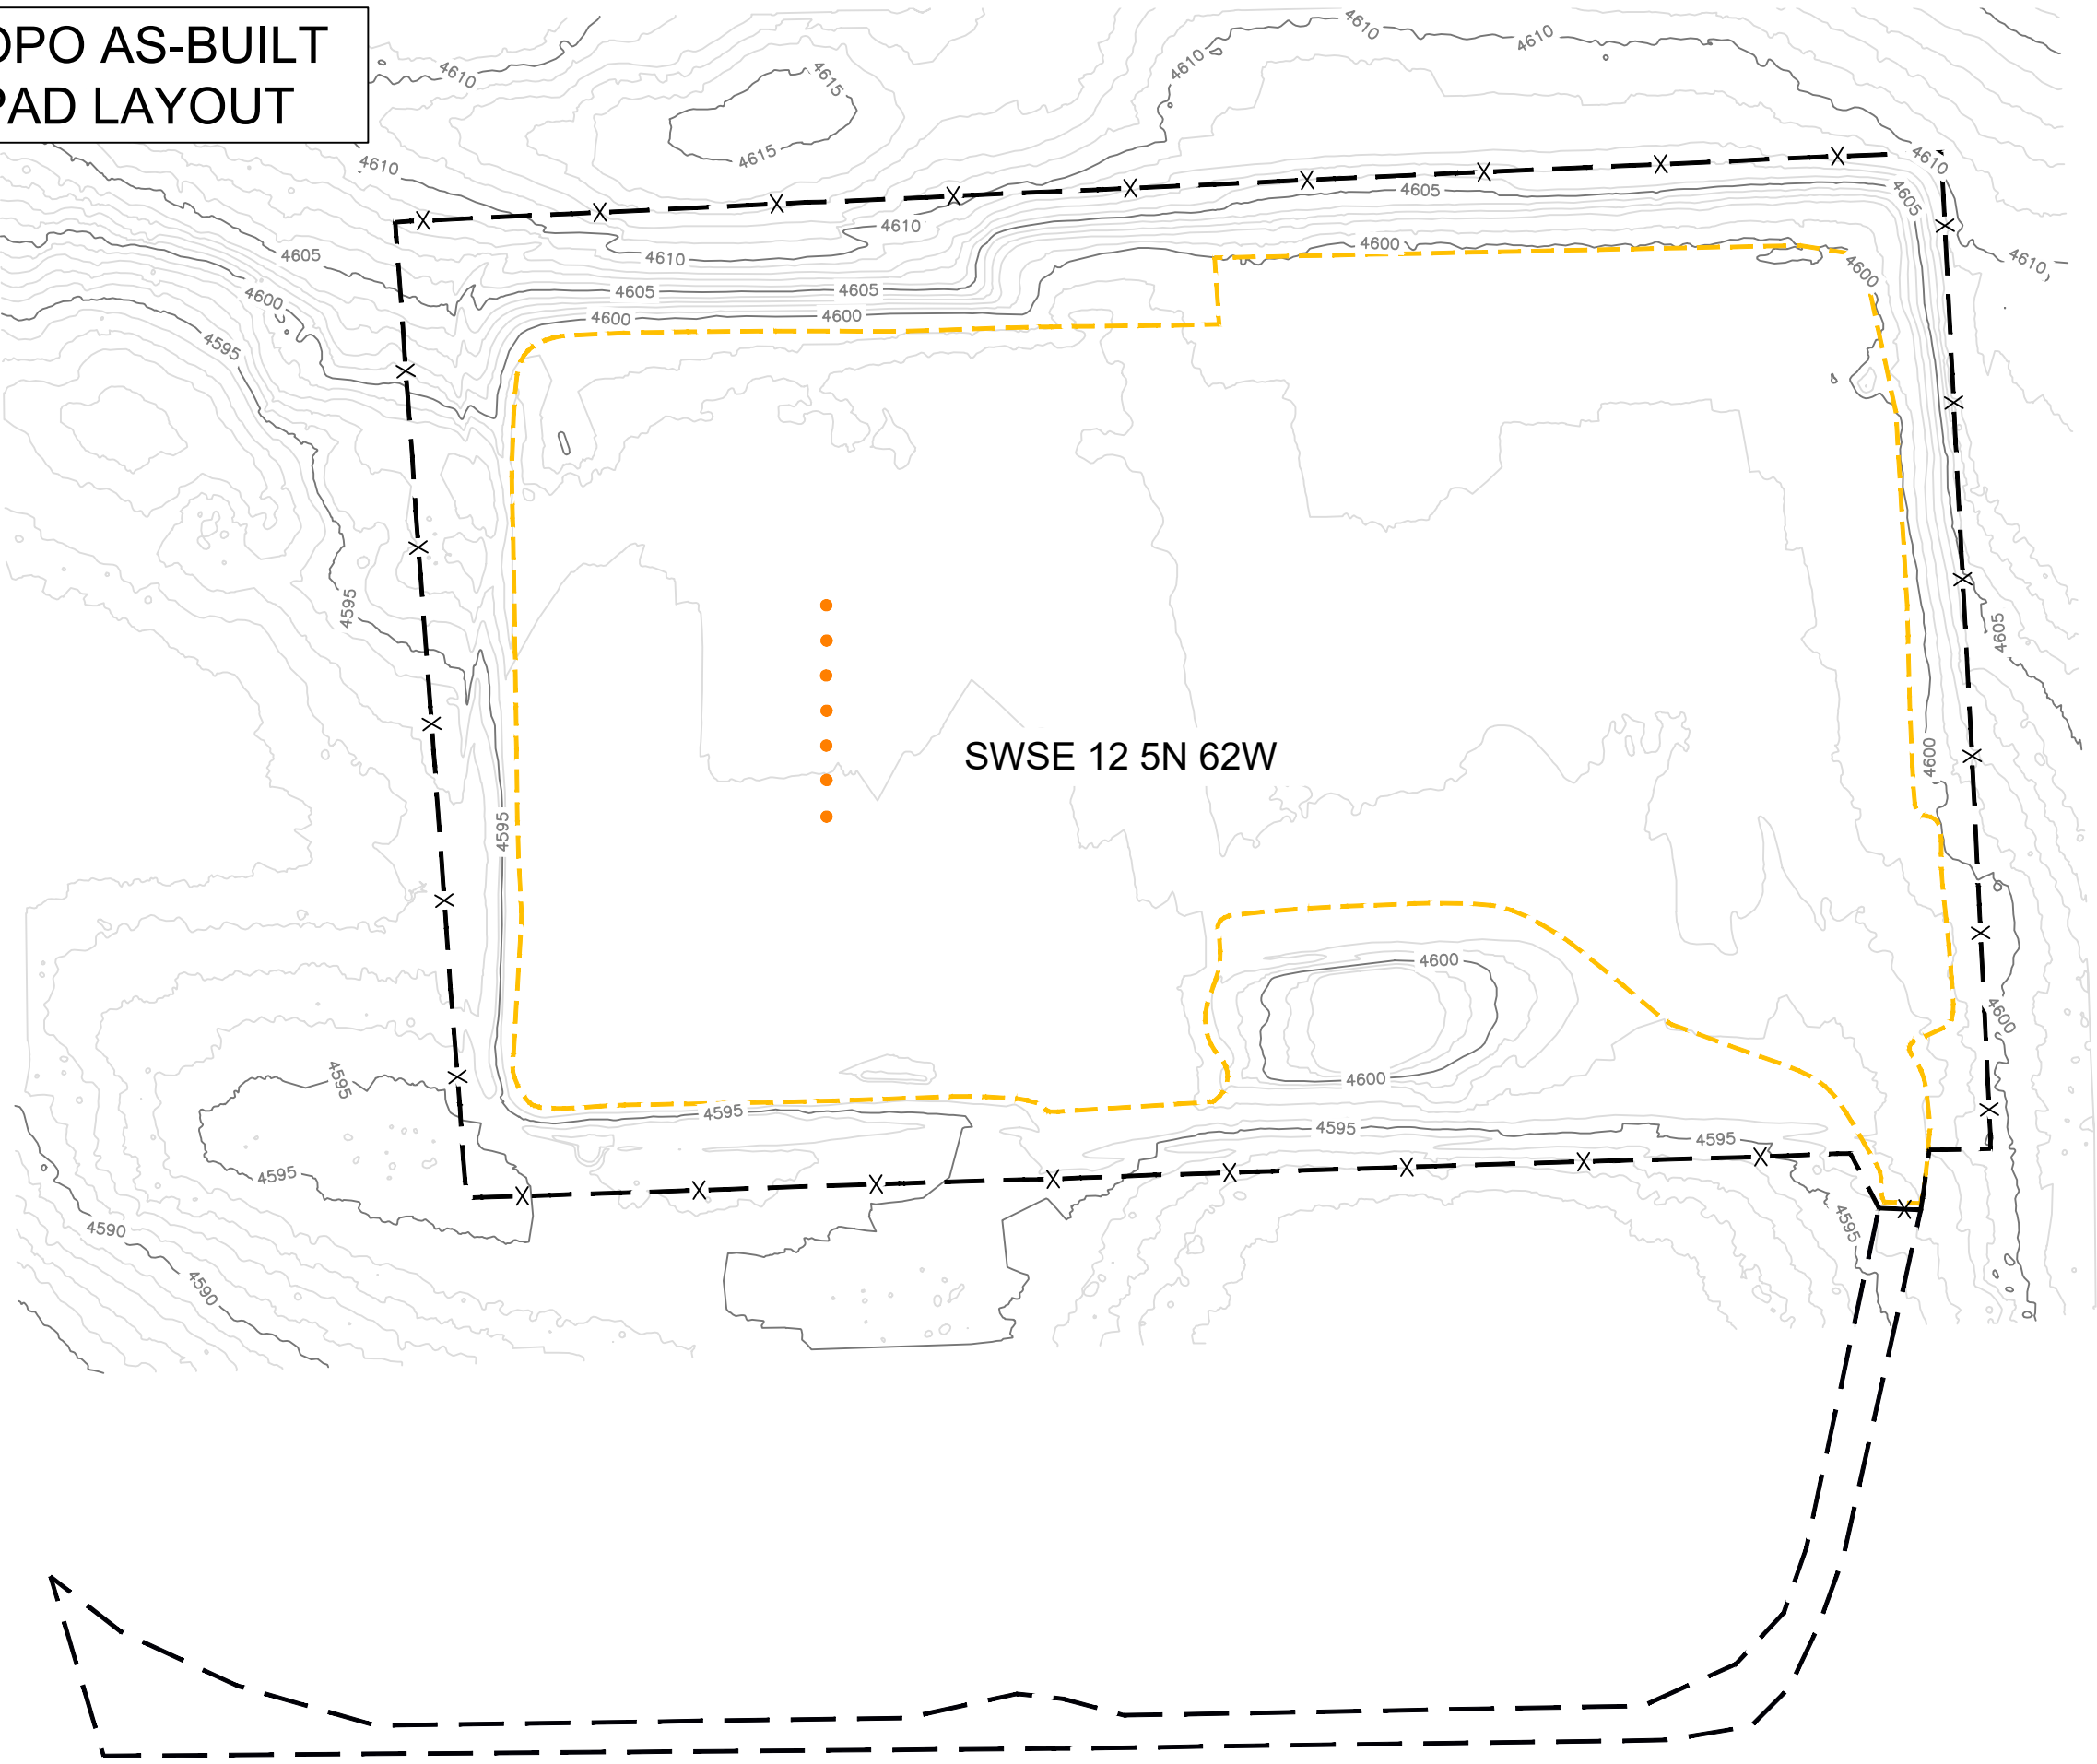


NOTES

\*\*UPDATED AERIAL ORTHOIMAGERY COLLECTED BY  
RPG RESOURCES BY USE OF UAV IN AUGUST, 2020\*\*

ACCESS ROAD: ~1,251 LINEAR FEET

AREA INSIDE FENCE: 11.0 ACRES

SURFACE AREA OF PAD: 7.7 ACRES

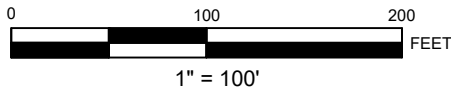

LEGEND

- EXISTING MAJOR CONTOUR
- EXISTING MINOR CONTOUR
- EXISTING FENCE
- EXISTING EDGE OF PAD
- EXISTING ACCESS ROAD
- EXISTING WELL HEAD



STATE ANTELOPE 34-12  
AS BUILT EXHIBIT

5N, 62W, SECTION 12, WELD COUNTY,  
COLORADO

SHEET NAME: TOPO OVERVIEW	SHEET NO.: 2 OF 2
------------------------------	----------------------