

## AERIAL AS-BUILT PAD LAYOUT

STATE SEVENTY HOLES I-6  
NWSW\_6\_4N\_62W\_106634


## NOTES

\*\*UPDATED AERIAL ORTHOIMAGERY COLLECTED BY  
RPG RESOURCES BY USE OF UAV IN AUGUST, 2021\*\*

AREA INSIDE FENCE: 7.48 ACRES

INT. RECLAMATION PAD FOOTPRINT AREA: 1.97 ACRES

ACCESS RD SURFACE AREA: 0.05 ACRES

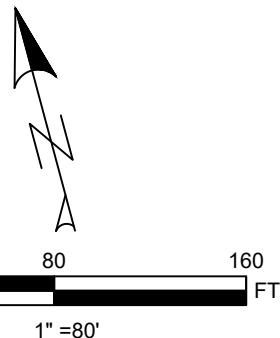

## LEGEND

- X — X — FENCE LINE
- X — X — ACCESS ROAD
- Y — Y — PAD EDGE
- WELL HEAD




## STATE SEVENTY HOLES I-6 AS-BUILT EXHIBITS

SECTION 6, TOWNSHIP 4N, RANGE 62W,  
WELD COUNTY, COLORADO

SHEET NAME:	SHEET NO.
AERIAL IMAGERY	1 OF 2


**TOPO AS-BUILT  
PAD LAYOUT**

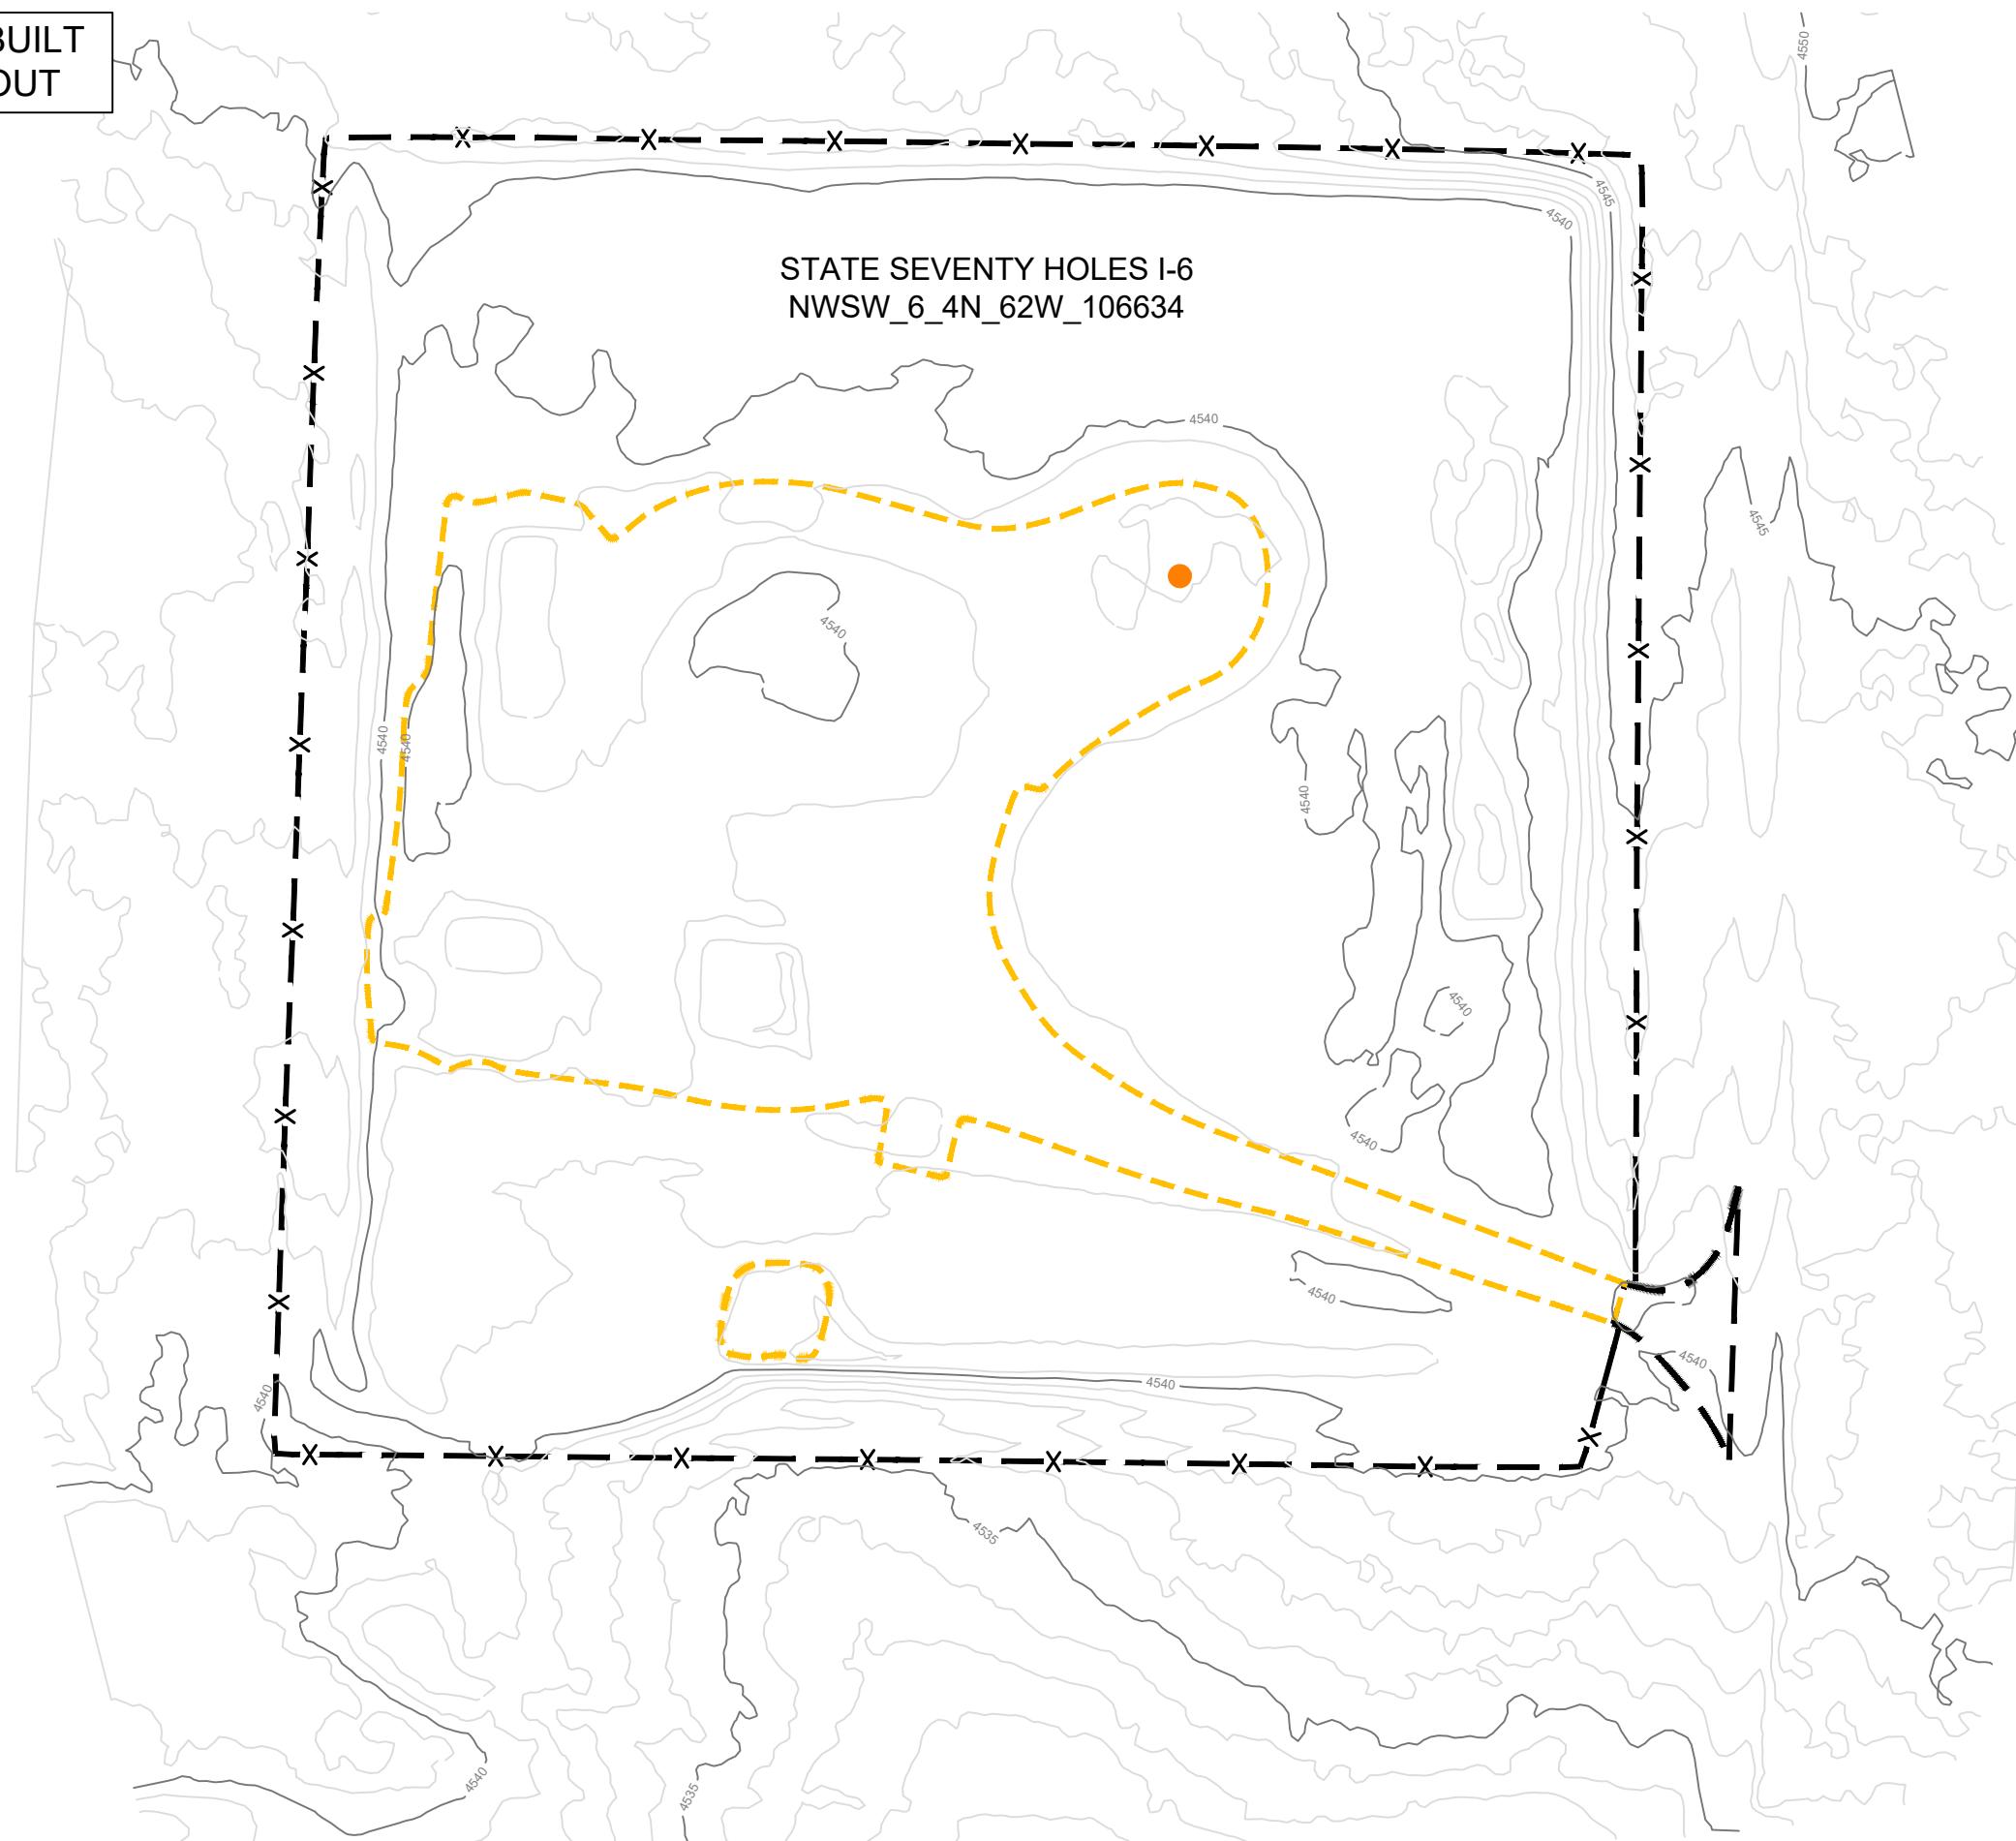

**NOTES**

\*\*UPDATED AERIAL ORTHOIMAGERY COLLECTED BY RPG RESOURCES BY USE OF UAV IN AUGUST, 2021\*\*

AREA INSIDE FENCE: 7.48 ACRES  
INT. RECLAMATION PAD FOOTPRINT AREA: 1.97 ACRES  
ACCESS RD SURFACE AREA: 0.05 ACRES

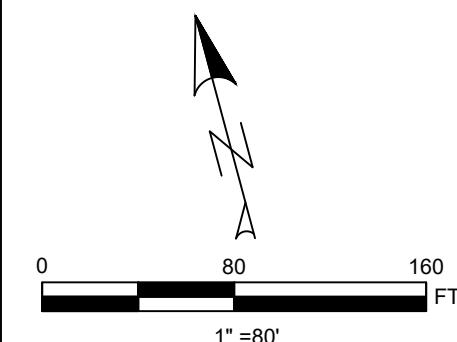

**LEGEND**

- 4600 — MAJOR CONTOUR
- 4540 — MINOR CONTOUR
- x-x- FENCE LINE
- - - - ACCESS ROAD
- - - - PAD EDGE
- WELL HEAD



**STATE SEVENTY HOLES I-6  
AS-BUILT EXHIBITS**

SECTION 6, TOWNSHIP 4N, RANGE 62W,  
WELD COUNTY, COLORADO

SHEET NAME:	SHEET NO.
TOPO OVERVIEW	2 OF 2