

AERIAL AS-BUILT
PAD LAYOUT




NOTES

**UPDATED AERIAL ORTHOIMAGERY COLLECTED BY
RPG RESOURCES BY USE OF UAV IN JUNE, 2021**

AREA INSIDE FENCE: ~8.5 ACRES

PAD SURFACE AREA: ~ 6.00 ACRES

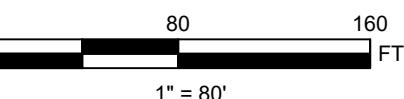

LEGEND

- X— —X— EXISTING FENCE
- Y— —Y— EXISTING EDGE OF PAD
- Z— —Z— EXISTING ACCESS ROAD



DRAFT SET
FOR REVIEW
ONLY

6/30/2021

SIGNATURE


DATE

STATE ANTELOPE 0-1
AS-BUILT EXHIBITS

SECTION 01, TOWNSHIP 5N, RANGE 62W,
WELD COUNTY, COLORADO

SHEET NAME:	SHEET NO.
AERIAL IMAGERY	1 OF 2

**TOPO AS-BUILT
PAD LAYOUT**

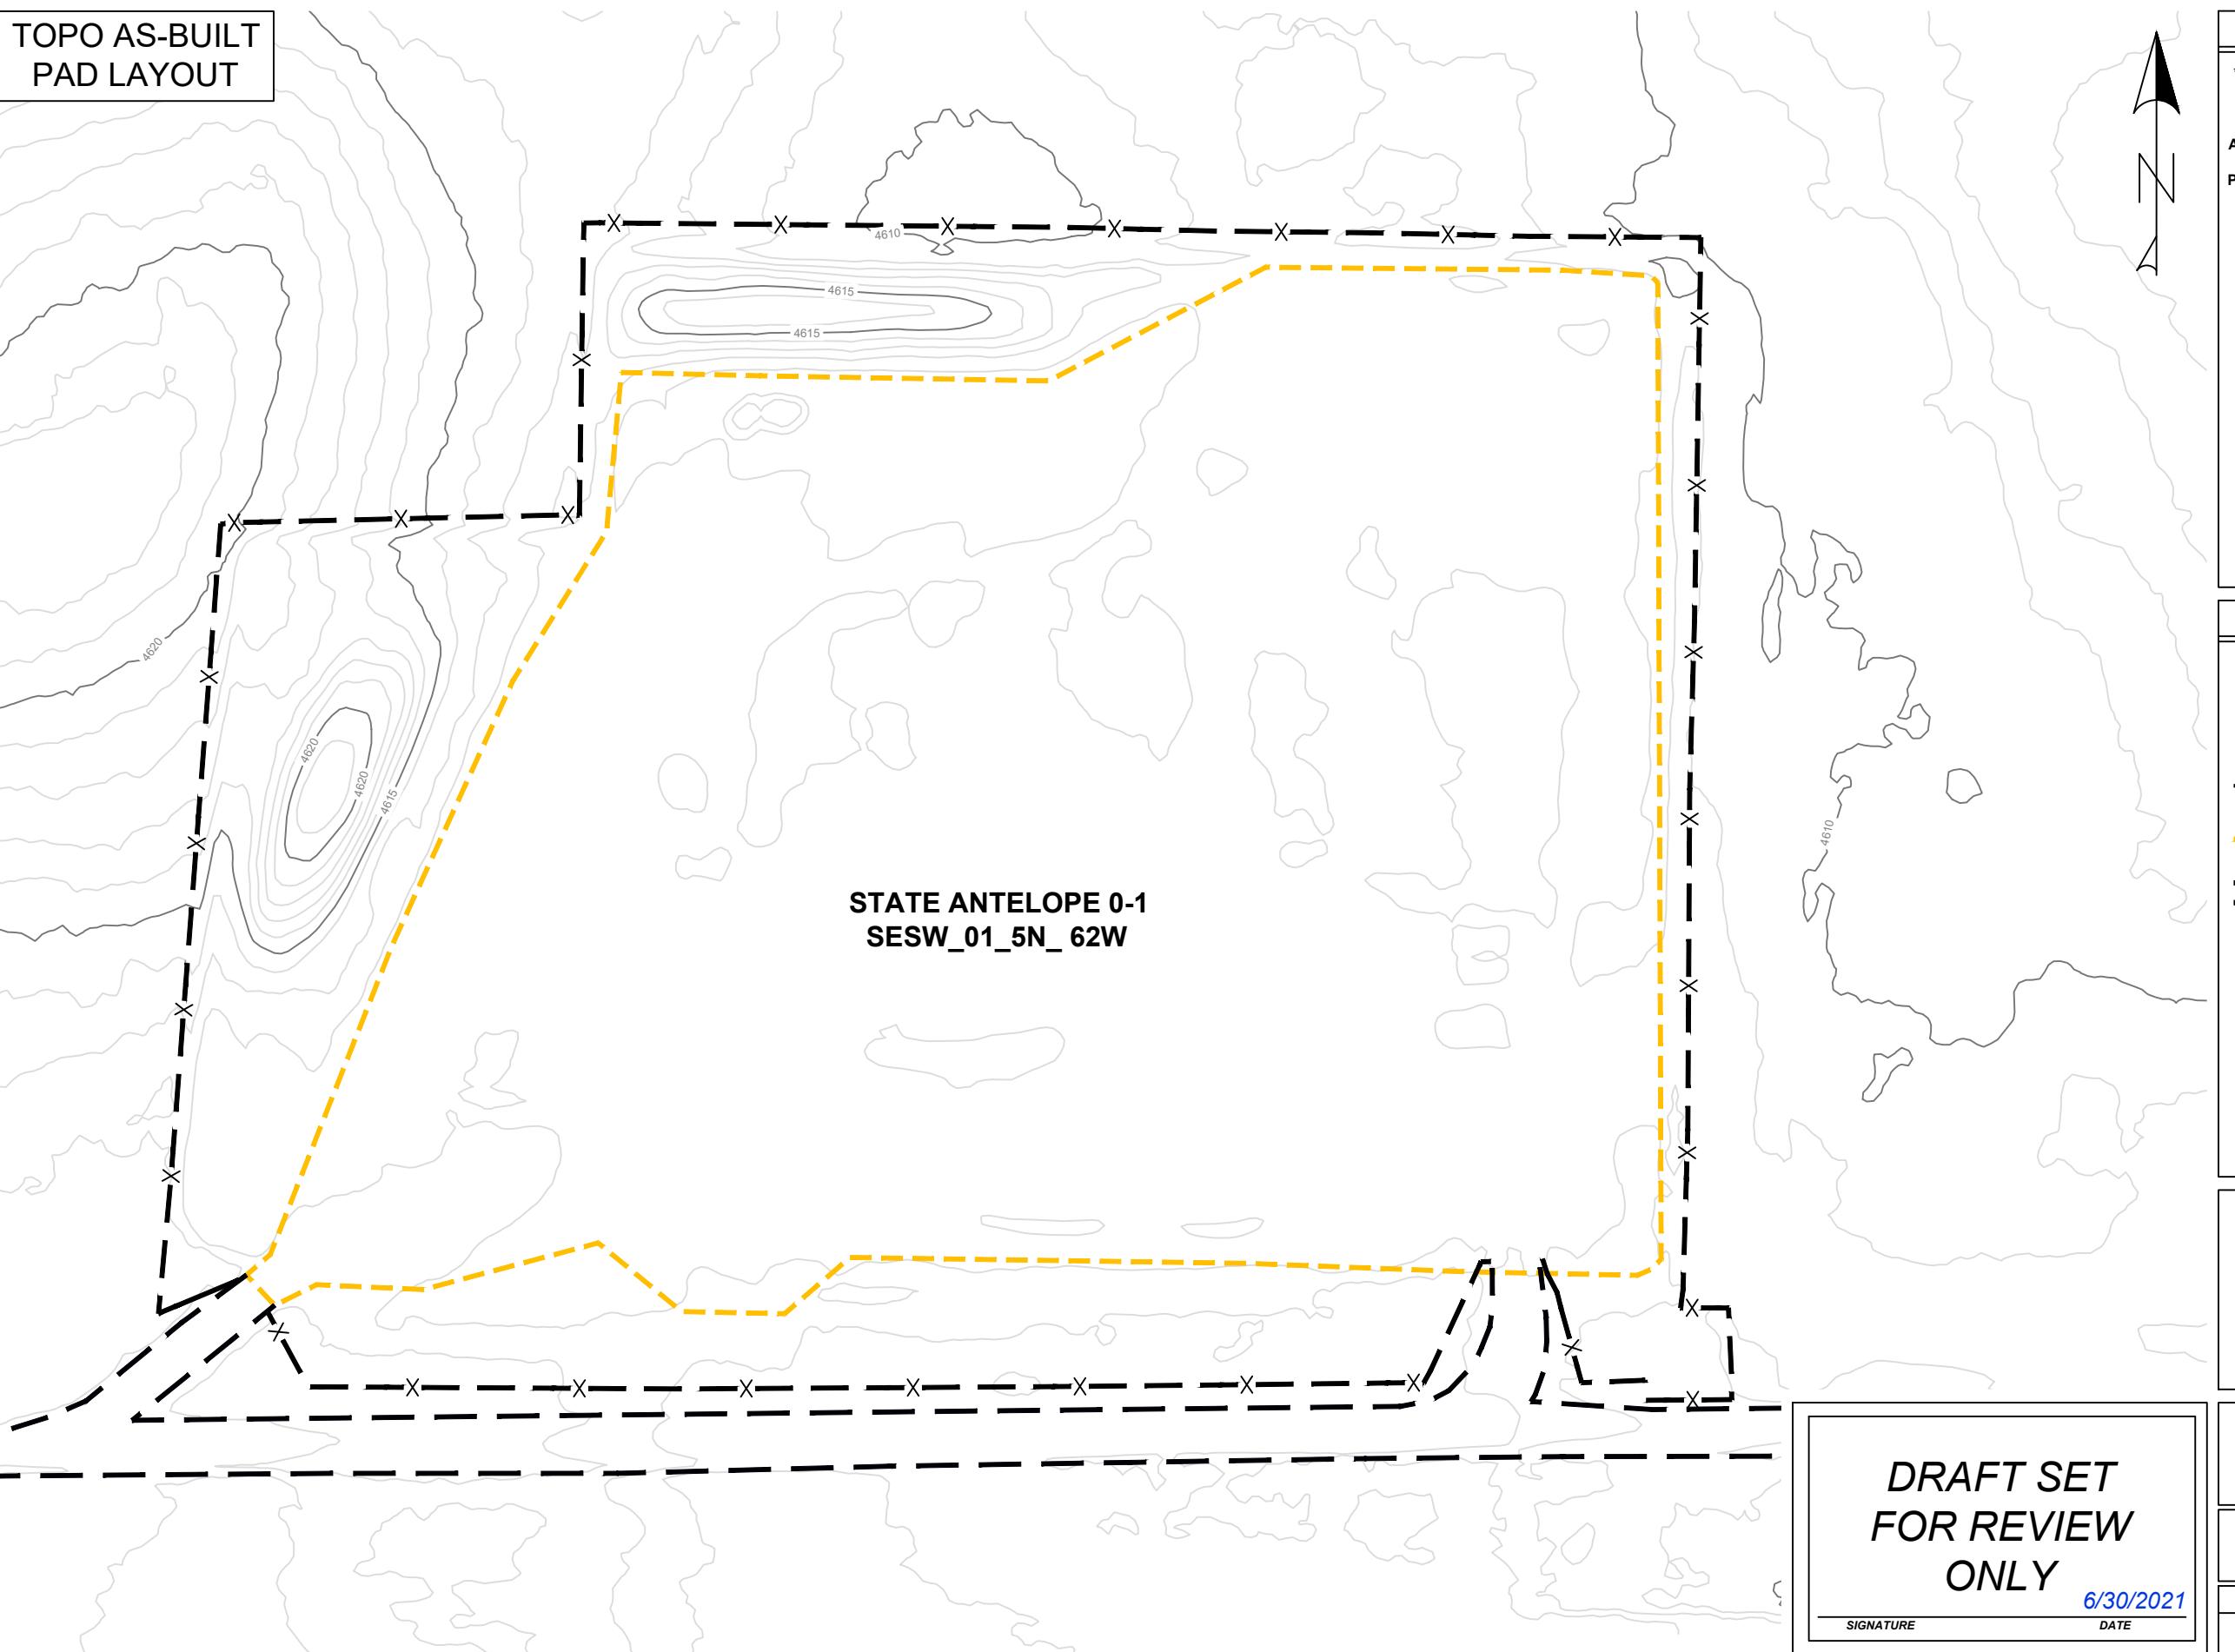

NOTES

**UPDATED AERIAL ORTHOIMAGERY COLLECTED BY
RPG RESOURCES BY USE OF UAV IN JUNE, 2021**

AREA INSIDE FENCE: ~8.5 ACRES

PAD SURFACE AREA: ~ 6.00 ACRES

LEGEND

- 4605 — EXISTING MAJOR CONTOUR
- 4615 — EXISTING MINOR CONTOUR
- X-X- EXISTING FENCE
- - - EXISTING EDGE OF PAD
- - - EXISTING ACCESS ROAD



**STATE ANTELOPE 0-1
AS-BUILT EXHIBITS**

SECTION 01, TOWNSHIP 5N, RANGE 62W,
WELD COUNTY, COLORADO

**DRAFT SET
FOR REVIEW
ONLY**

6/30/2021

SIGNATURE DATE

SHEET NAME:	SHEET NO.
TOPO OVERVIEW	2 OF 2