

AERIAL AS-BUILT
PAD LAYOUT




NOTES

**UPDATED AERIAL ORTHOIMAGERY & TOPO DATA
COLLECTED BY RPG RESOURCES BY USE OF UAV IN
AUGUST, 2021**

AREA INSIDE FENCE: 6.90 ACRES

INT. RECLAMATION PAD FOOTPRINT AREA: 2.80 ACRES

ACCESS RD SURFACE AREA: 0.37 ACRES

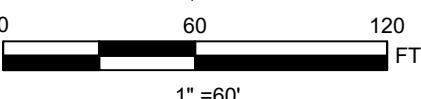

LEGEND

- X — X — X — FENCE LINE
- - - - - PAD EDGE
- - - - - ACCESS ROAD
- WELL HEAD




STATE ANTELOPE 41-11
AS-BUILT EXHIBITS

SECTION 11, TOWNSHIP 5N, RANGE 62W,
WELD COUNTY, COLORADO

SHEET NAME:	SHEET NO.
AERIAL IMAGERY	1 OF 4

**TOPO AS-BUILT
PAD LAYOUT**

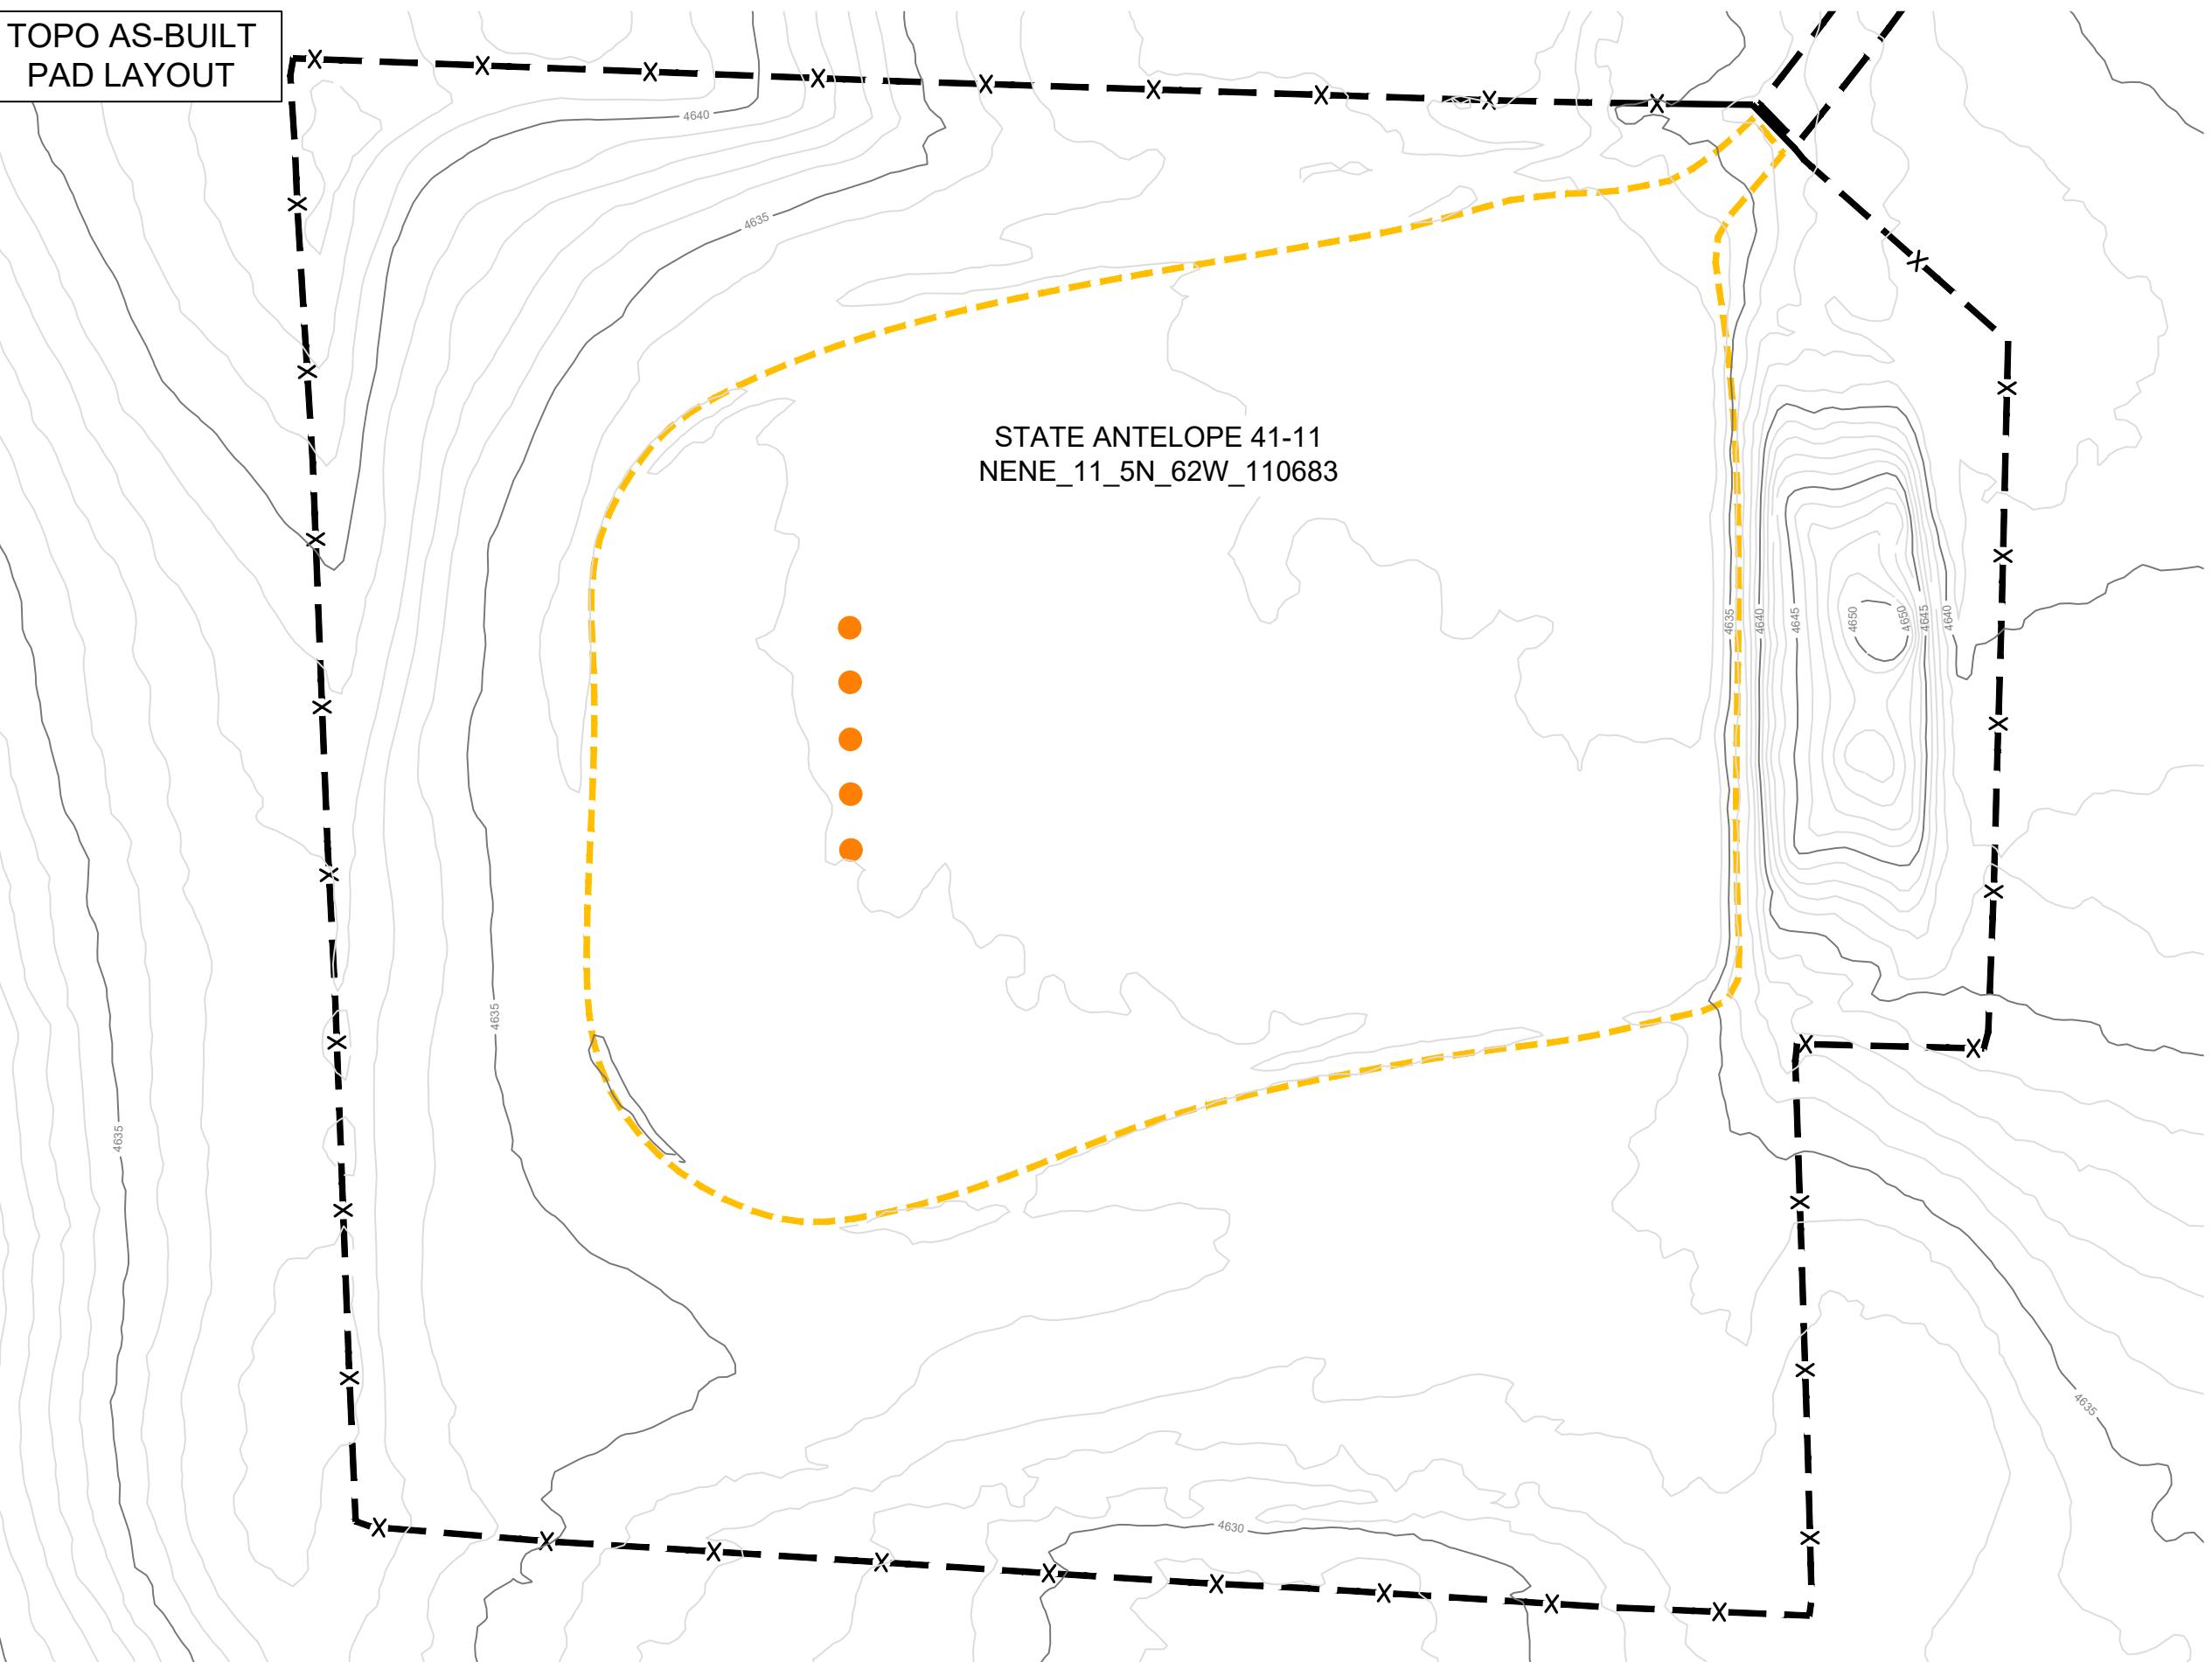

NOTES

**UPDATED AERIAL ORTHOIMAGERY & TOPO DATA
COLLECTED BY RPG RESOURCES BY USE OF UAV IN
AUGUST, 2021**

AREA INSIDE FENCE: 6.90 ACRES
INT. RECLAMATION PAD FOOTPRINT AREA: 2.80 ACRES
ACCESS RD SURFACE AREA: 0.37 ACRES



0 60 120 FT
1" = 60'

LEGEND

- 4600 — MAJOR CONTOUR
- 4600 — MINOR CONTOUR
- x-x- FENCE LINE
- - - - - PAD EDGE
- - - - - ACCESS ROAD
- WELL HEAD



**STATE ANTELOPE 41-11
AS-BUILT EXHIBITS**

SECTION 11, TOWNSHIP 5N, RANGE 62W,
WELD COUNTY, COLORADO

SHEET NAME:	SHEET NO.
TOPO OVERVIEW	2 OF 4





NOTES

**UPDATED AERIAL ORTHOIMAGERY & TOPO DATA
COLLECTED BY RPG RESOURCES BY USE OF UAV IN
AUGUST, 2021**

AREA INSIDE FENCE: 6.90 ACRES

INT. RECLAMATION PAD FOOTPRINT AREA: 2.80 ACRES

ACCESS RD SURFACE AREA: 0.37 ACRES

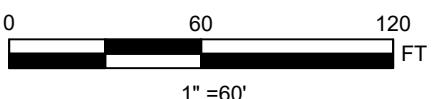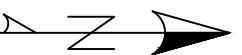

LEGEND




- X — X — FENCE LINE
- Y — Y — PAD EDGE
- Z — Z — ACCESS ROAD



STATE ANTELOPE 41-11 AS-BUILT EXHIBITS

SECTION 11, TOWNSHIP 5N, RANGE 62W,
WELD COUNTY, COLORADO

SHEET NAME:	SHEET NO.
ACCESS ROAD IMAGERY	3 OF 4

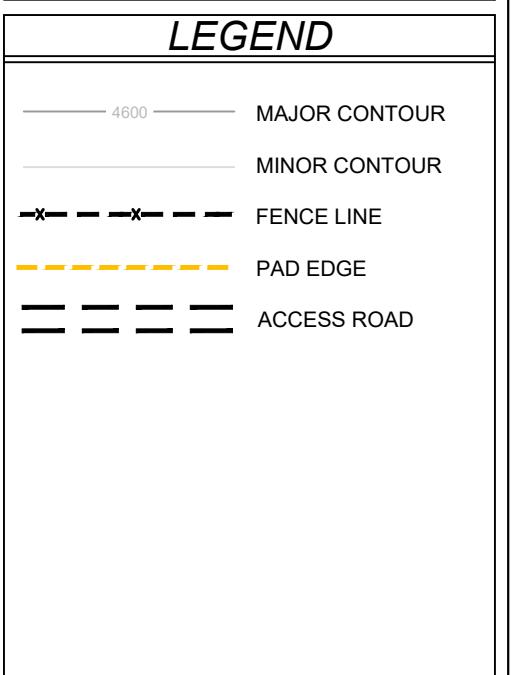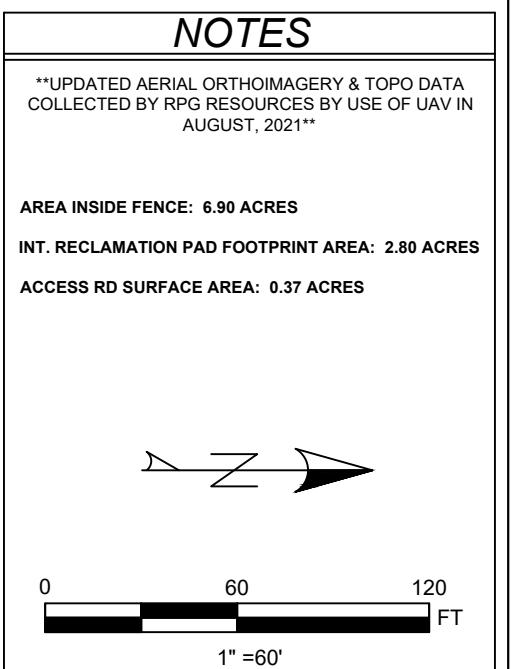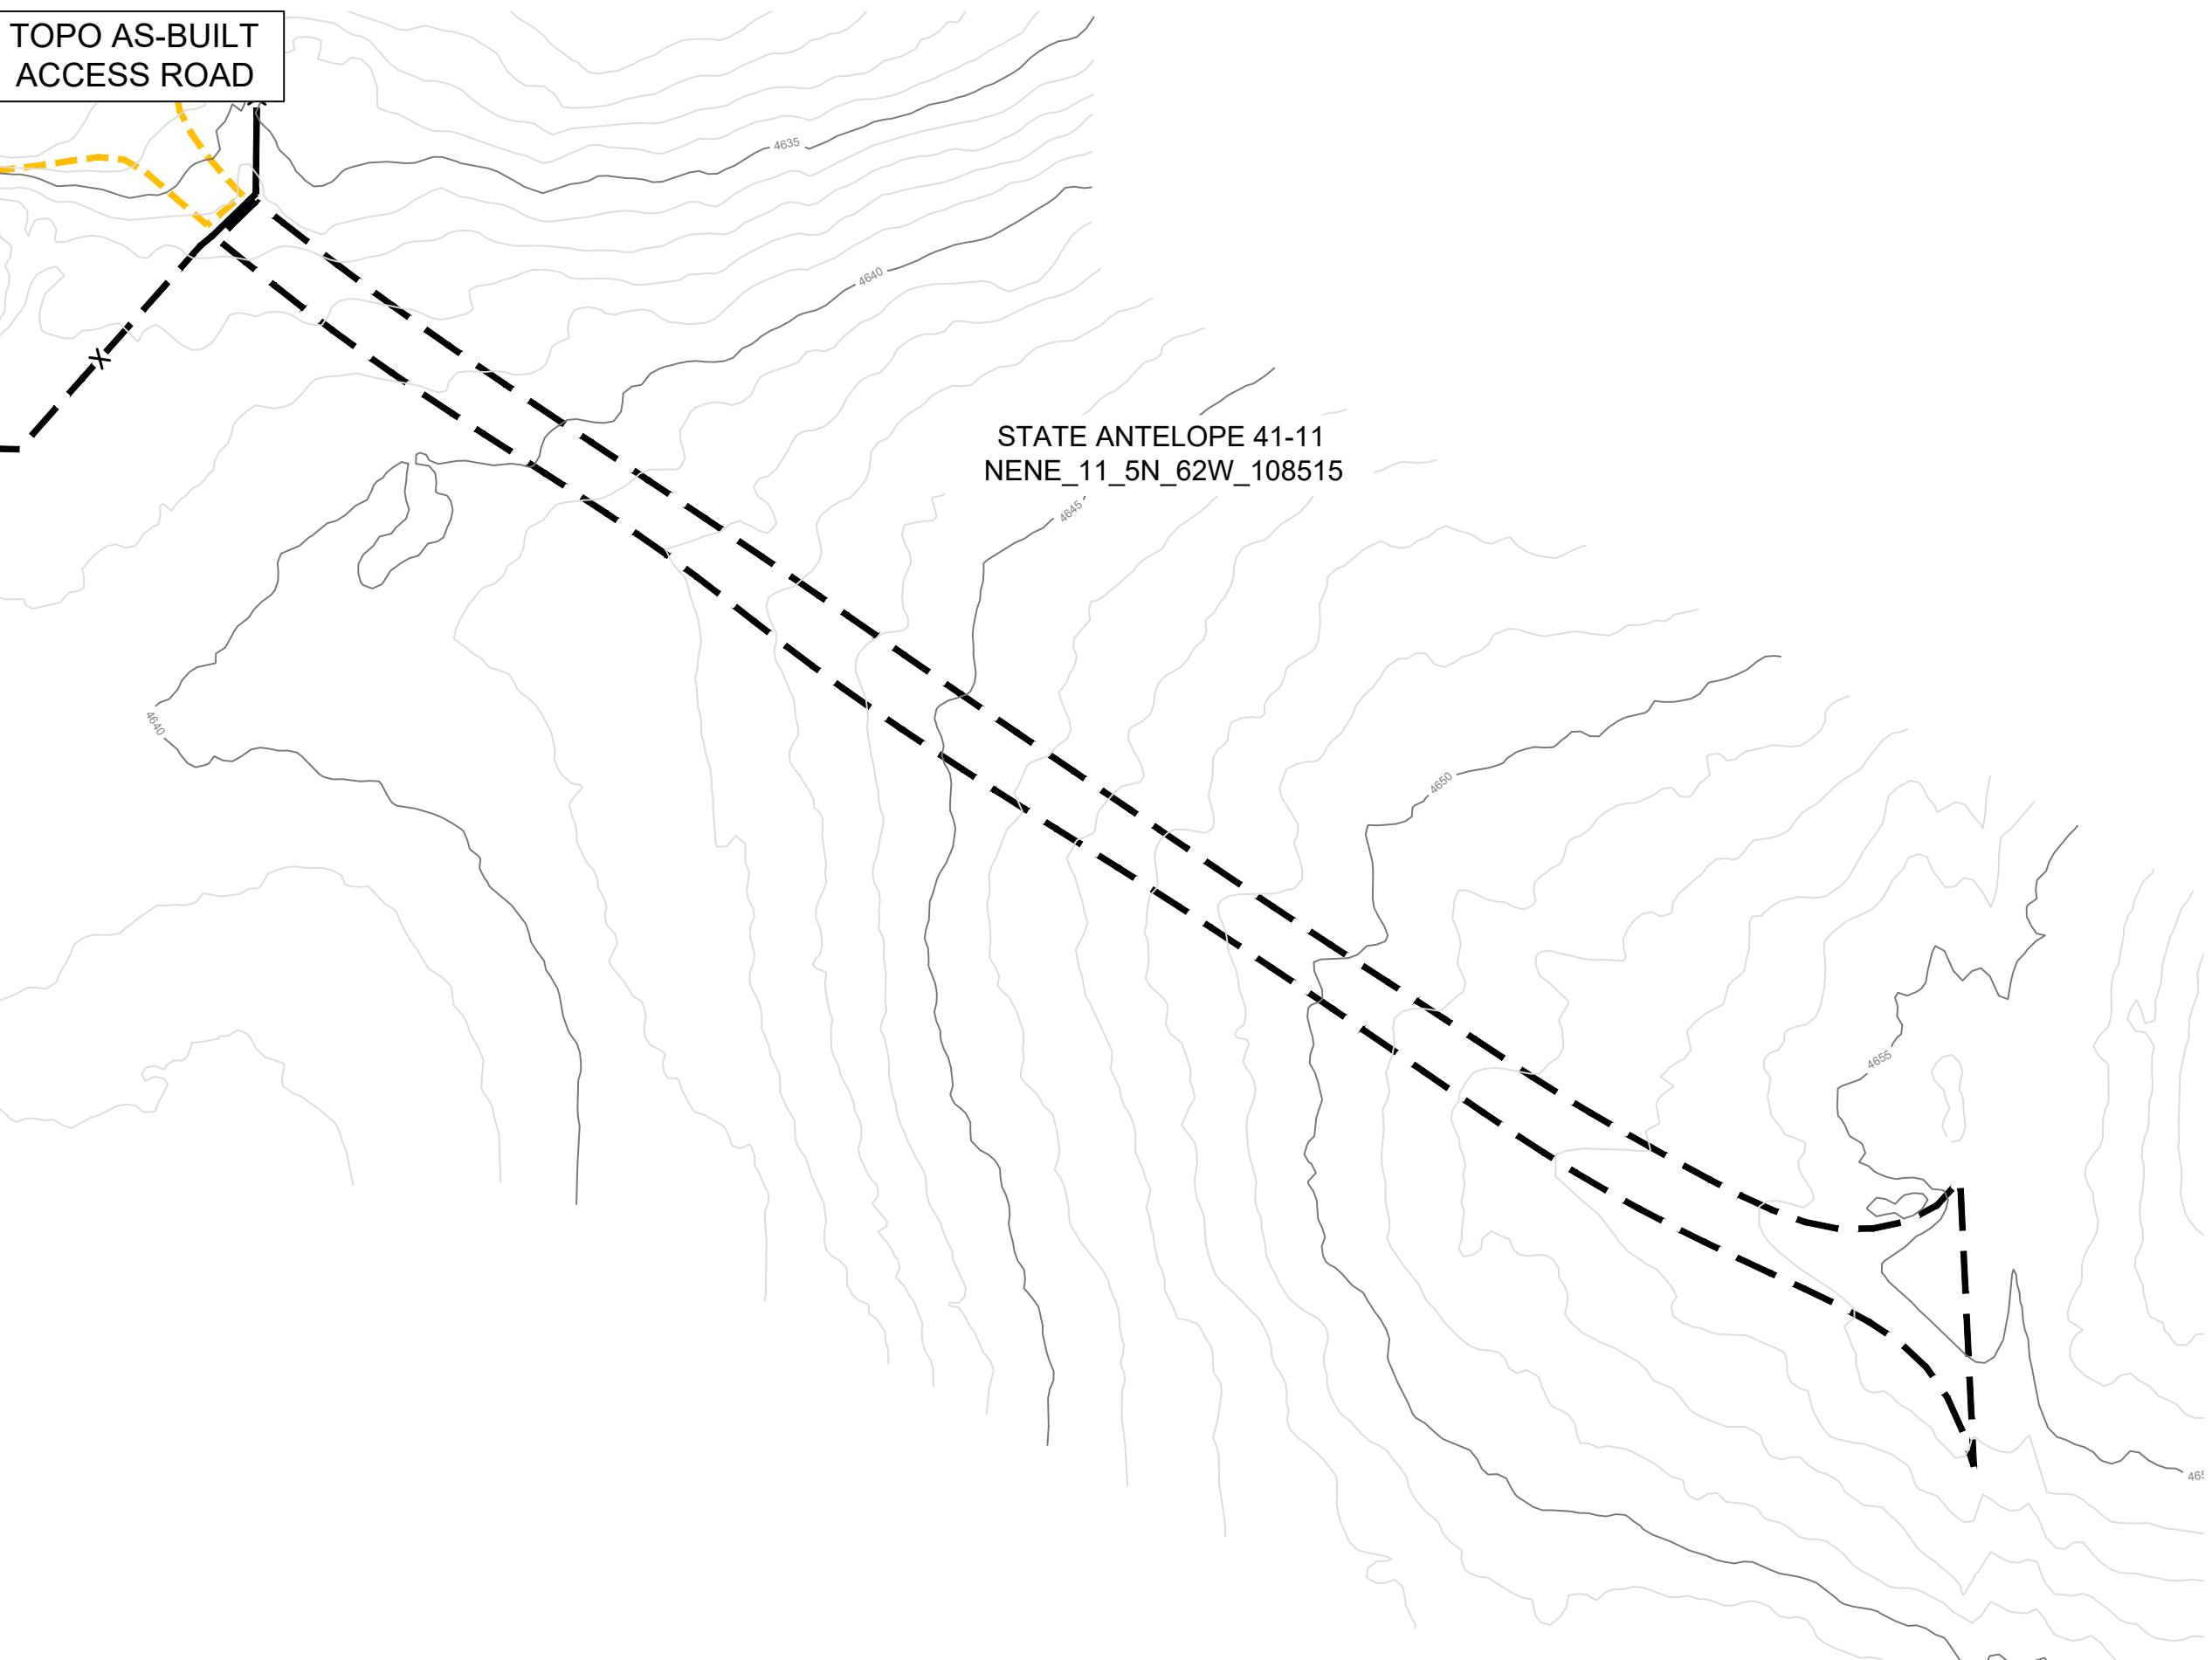

**STATE ANTELOPE 41-11
AS-BUILT EXHIBITS**

SECTION 11, TOWNSHIP 5N, RANGE 62W,
WELD COUNTY, COLORADO

SHEET NAME:	SHEET NO.
ACCESS ROAD TOPO	4 OF 4