


## AERIAL AS-BUILT PAD LAYOUT

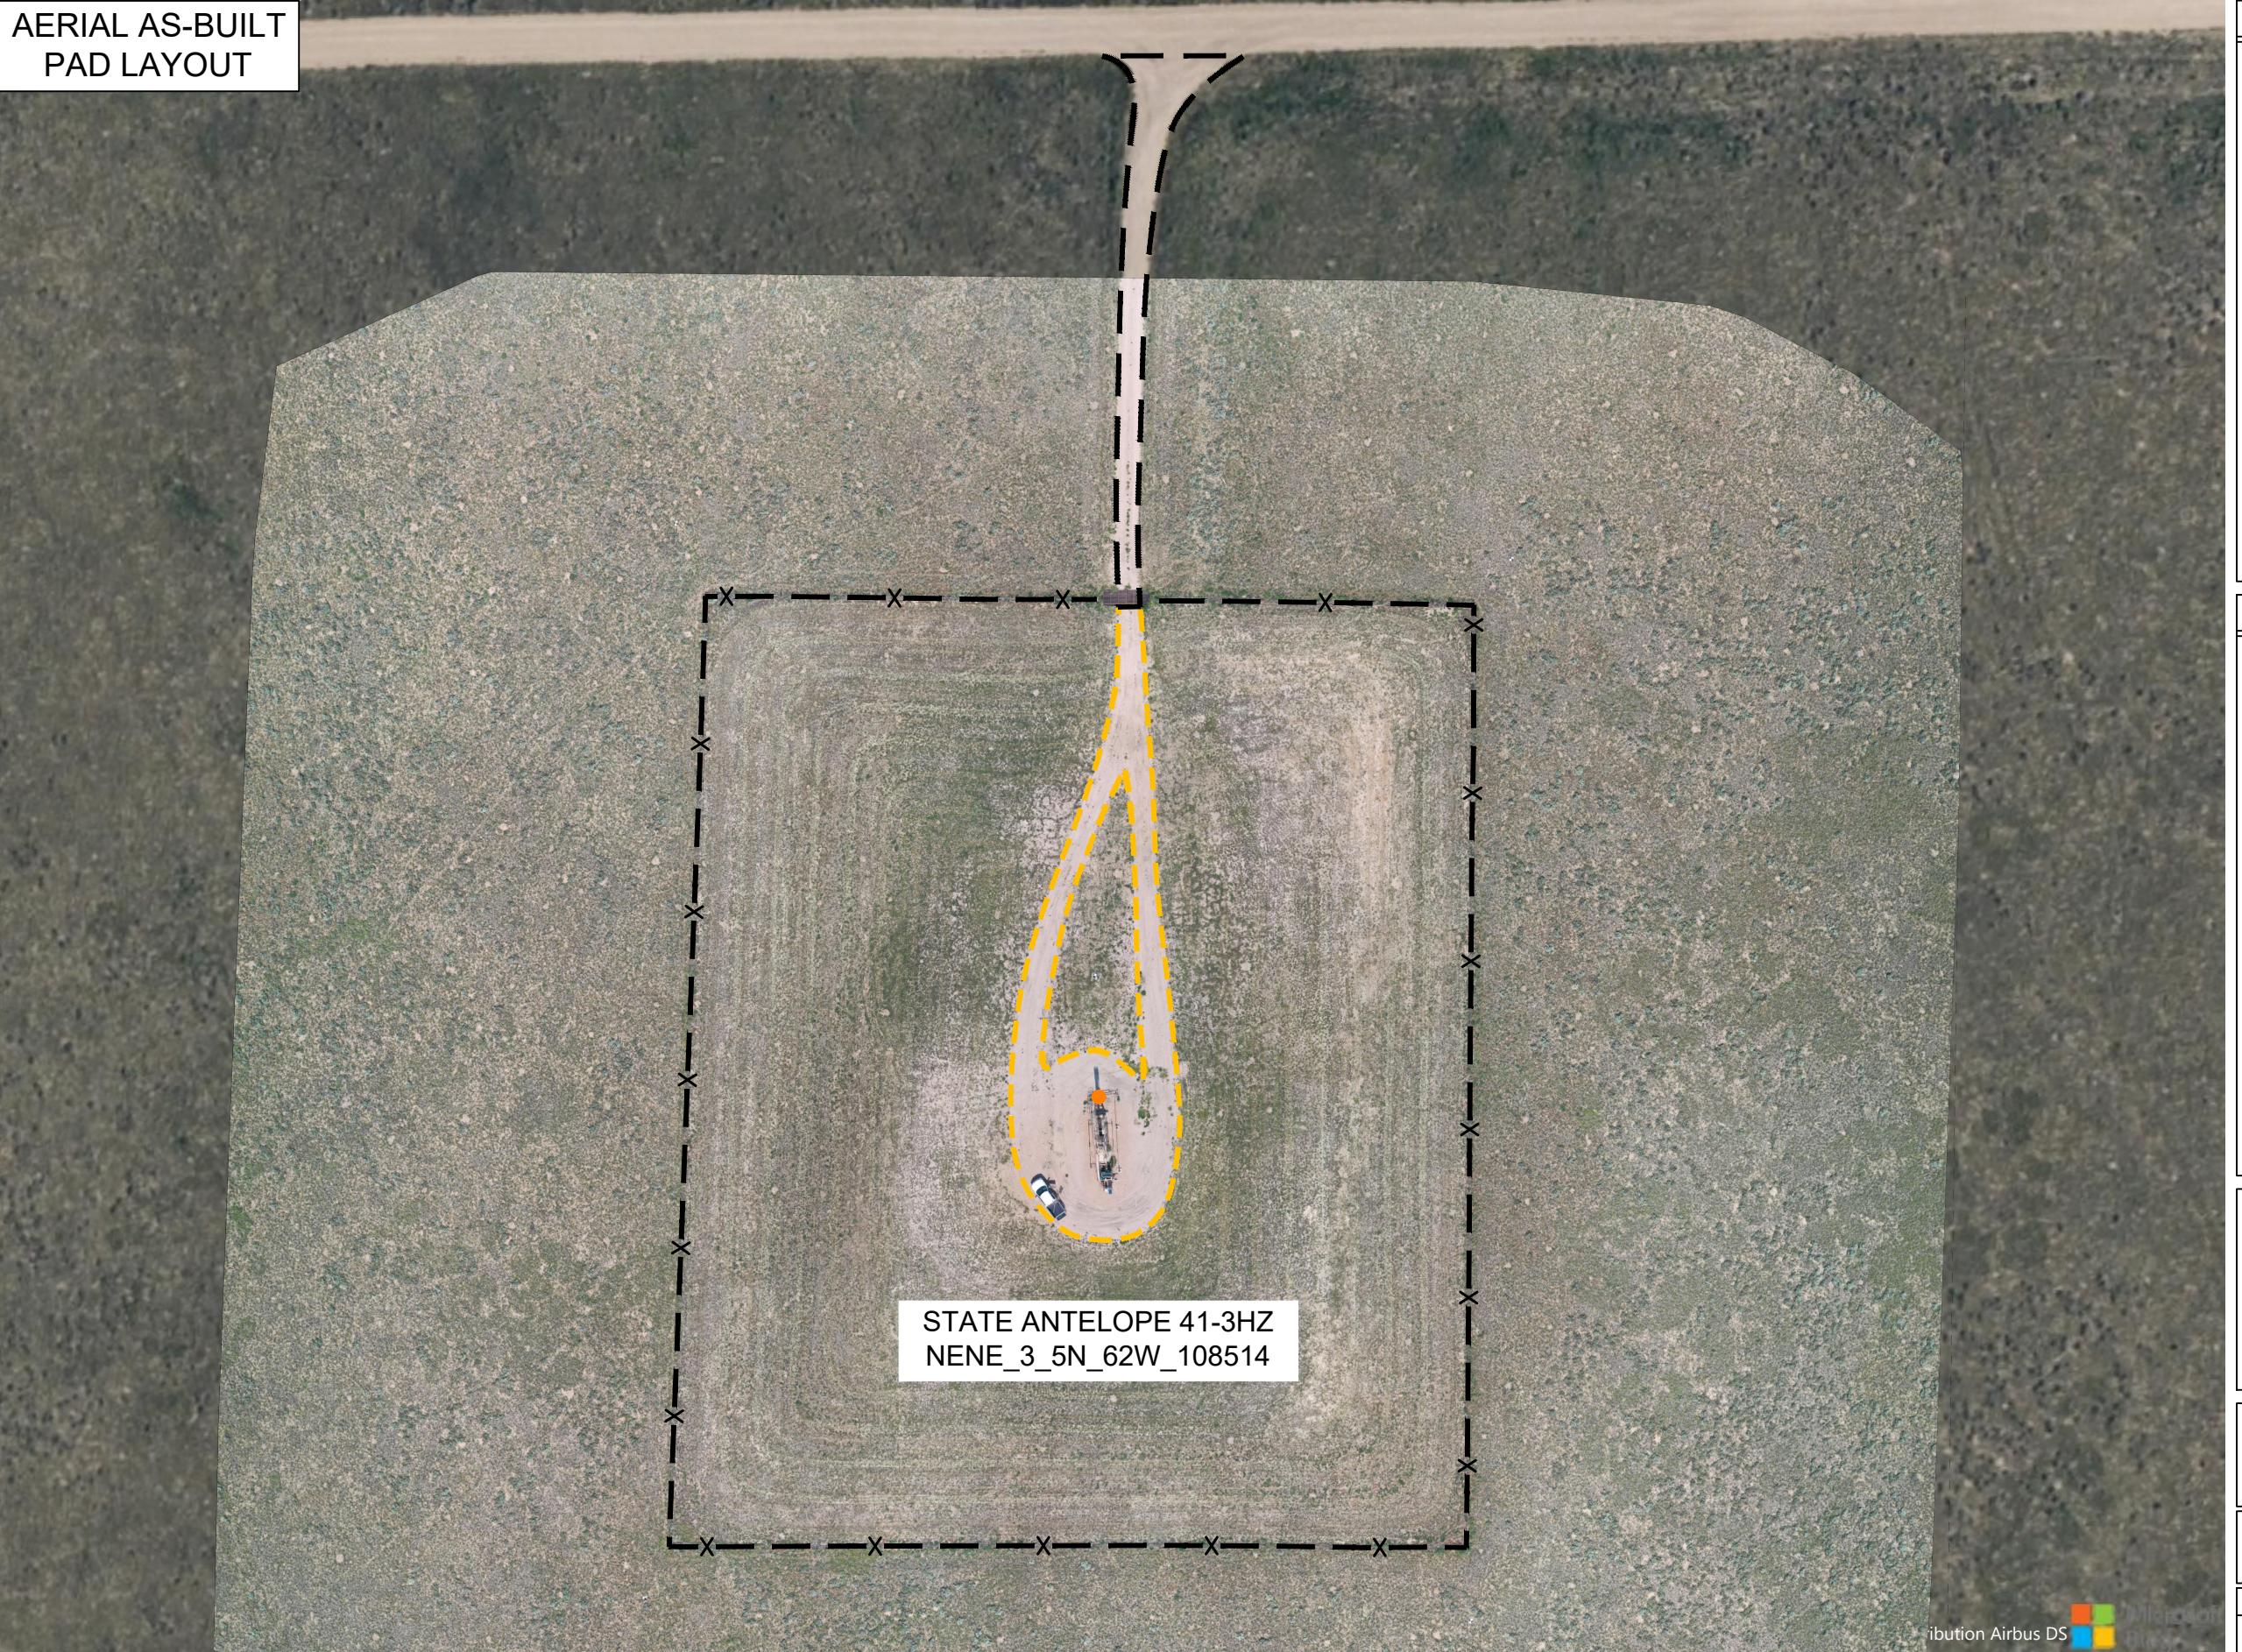


## NOTES

\*\*UPDATED AERIAL ORTHOIMAGERY COLLECTED BY RPG RESOURCES BY USE OF UAV IN AUGUST, 2021\*\*

AREA INSIDE FENCE: 3.84 ACRES

INT. RECLAMATION PAD FOOTPRINT AREA: 0.34 ACRES

ACCESS ROAD SURFACE AREA: 0.09 ACRES

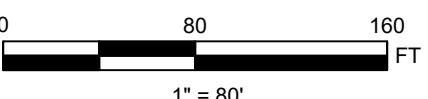

## LEGEND

- ACCESS ROAD
- FENCE LINE
- PAD EDGE
- WELL HEAD




## STATE ANTELOPE 41-3HZ AS-BUILT EXHIBITS

SECTION 3, TOWNSHIP 5N, RANGE 62W,  
WELD COUNTY, COLORADO

SHEET NAME:	SHEET NO.
AERIAL IMAGERY	1 OF 2

# TOPO AS-BUILT PAD LAYOUT

# TOPO AS-BUILT PAD LAYOUT

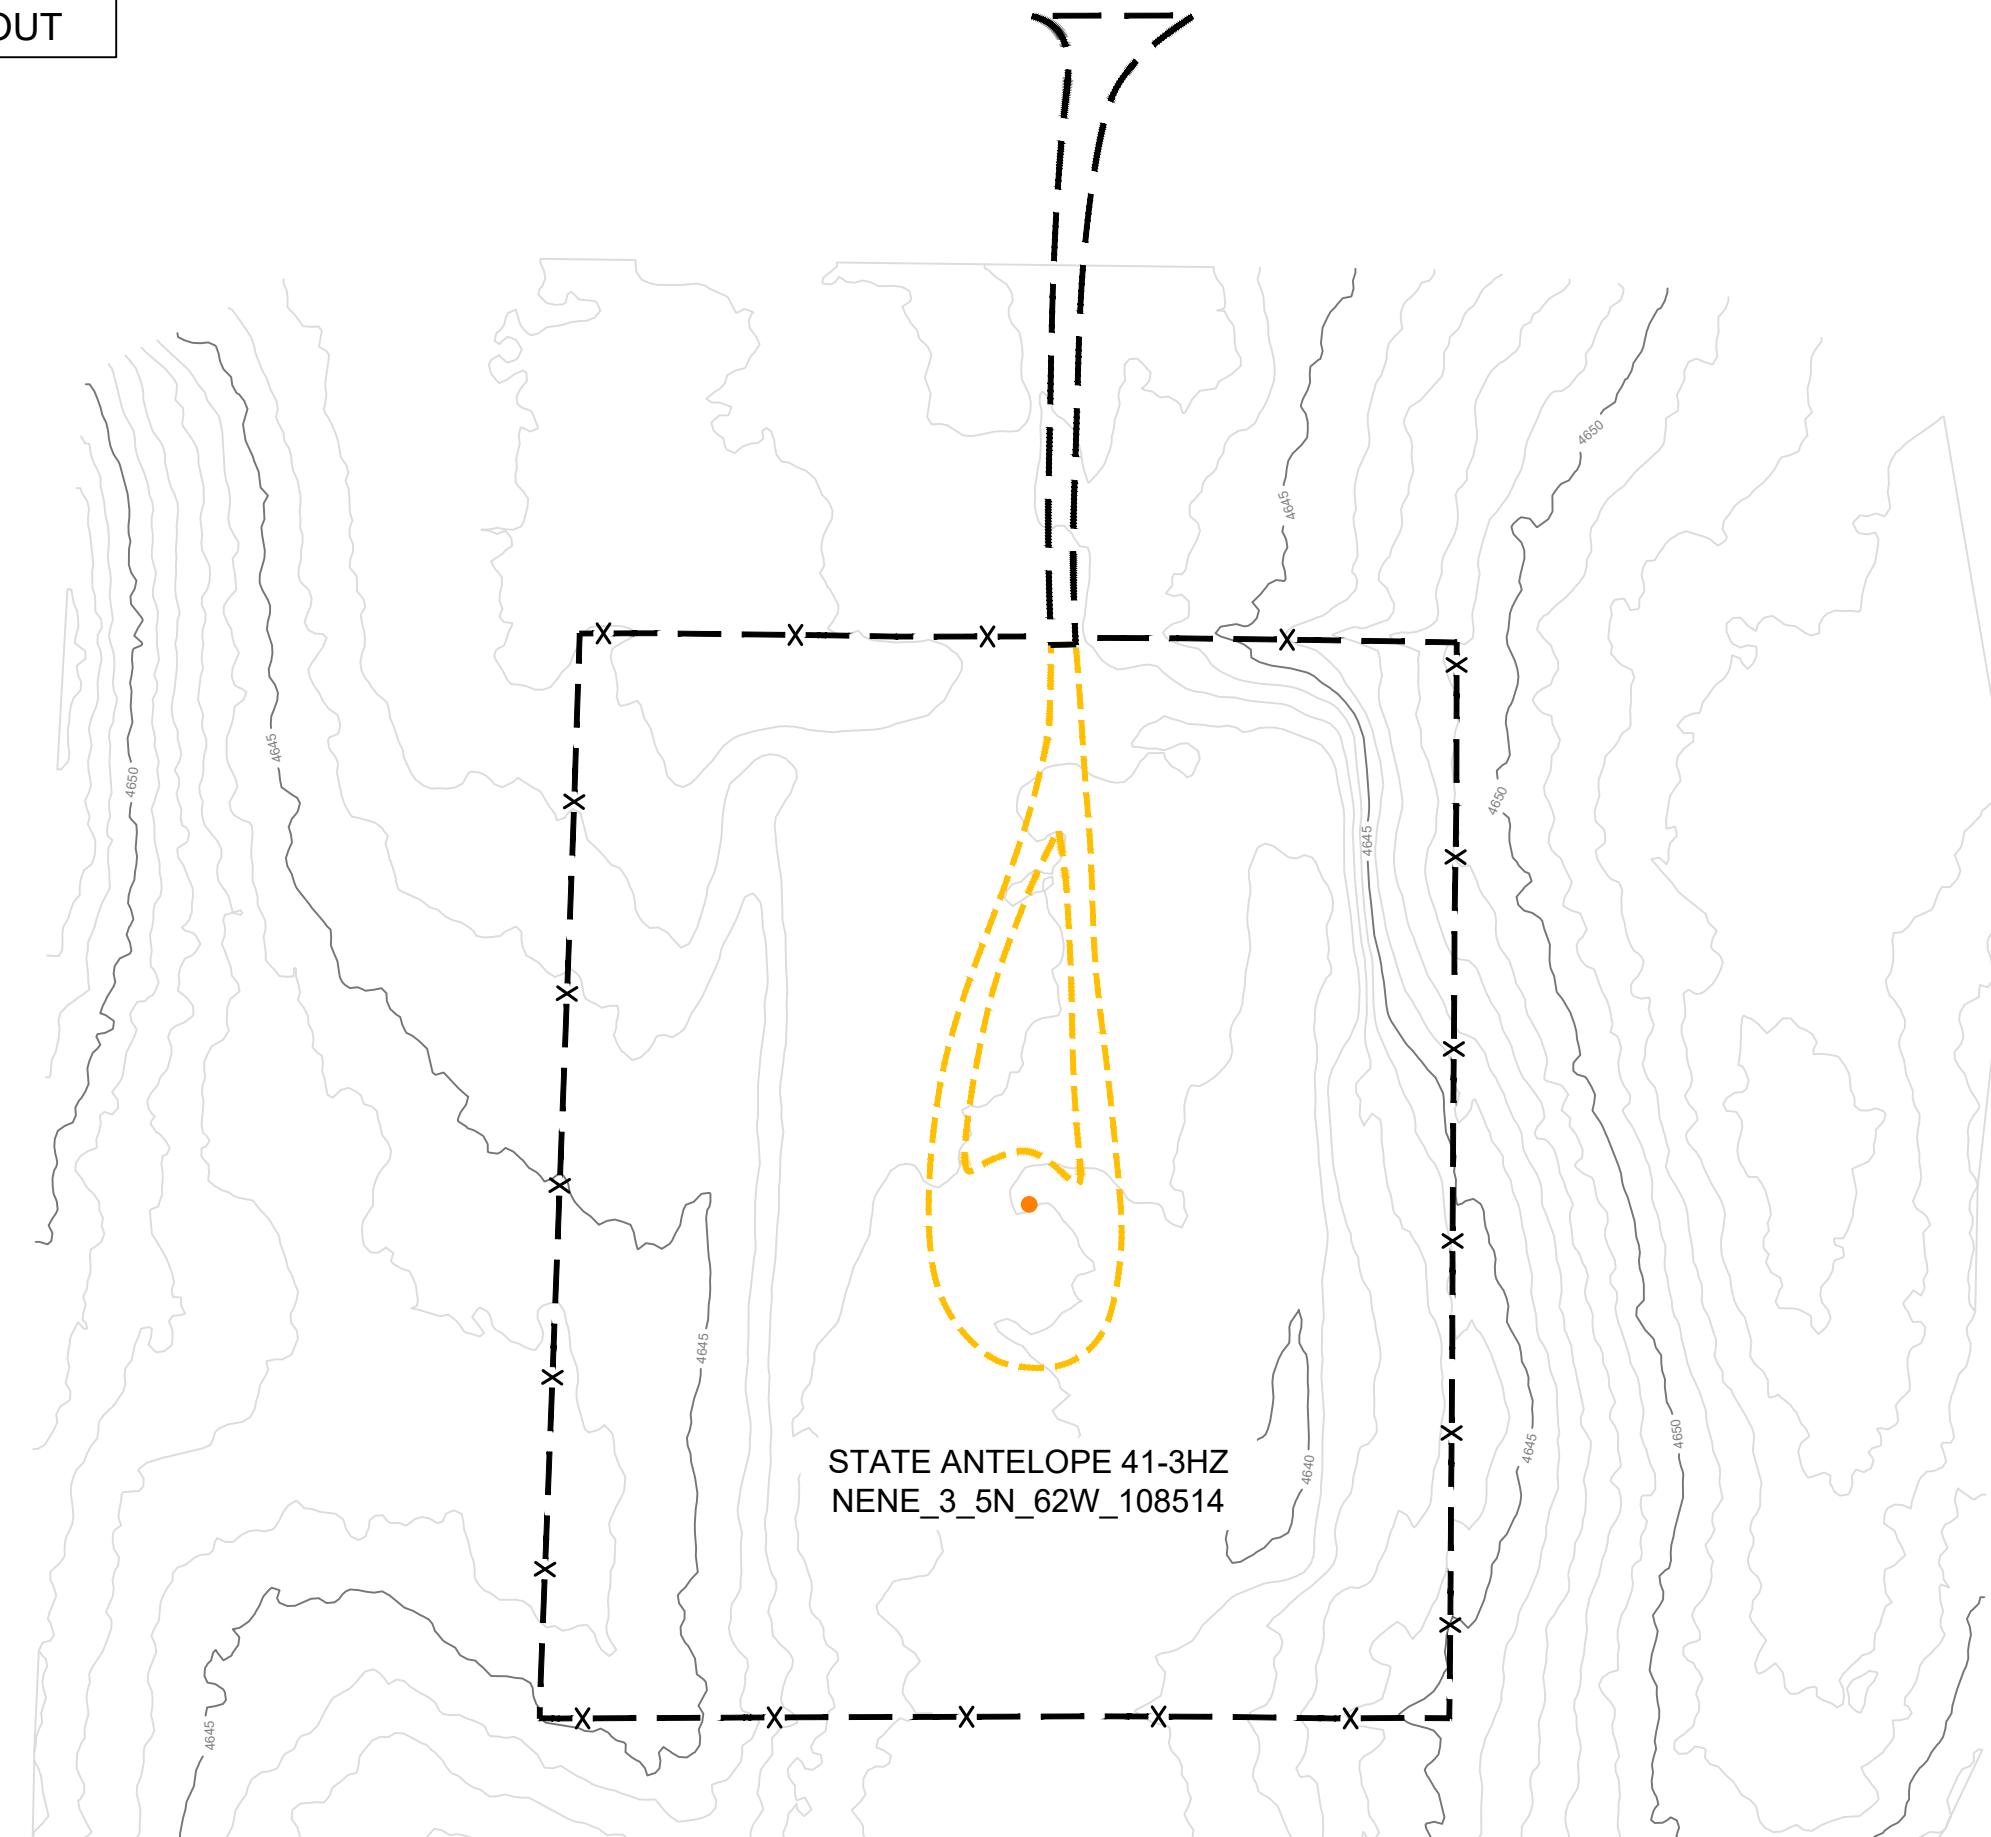


## **NOTES**

\*\*UPDATED TOPO DATA COLLECTED BY RPG  
RESOURCES BY USE OF UAV IN AUGUST, 2021\*\*

**AREA INSIDE FENCE: 3.85 ACRES**

**INT. RECLAMATION PAD FOOTPRINT AREA: 0.34 ACRES**

**ACCESS ROAD SURFACE AREA: 0.09 ACRES**

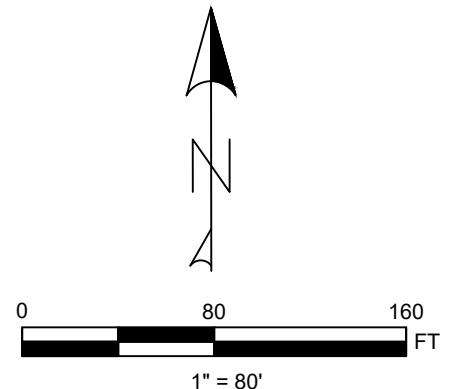

---

***LEGEND***

- The legend consists of five entries, each showing a symbol followed by its name. 1. A solid line segment labeled '4505'. 2. A solid line segment labeled 'MAJOR CONTOUR'. 3. A dashed line segment labeled 'MINOR CONTOUR'. 4. A dashed line segment labeled 'ACCESS ROAD'. 5. A dashed line segment labeled 'FENCE LINE'. 6. A yellow dashed line segment labeled 'PAD EDGE'. 7. An orange circle labeled 'WELL HEAD'.



## **STATE ANTELOPE 41-3HZ AS-BUILT EXHIBITS**

SECTION 3, TOWNSHIP 5N, RANGE 62W,  
WELD COUNTY, COLORADO

SHEET NAME:	SHEET NO.
TOPO OVERVIEW	2 OF 2