


NOTES

** UPDATED AERIAL IMAGERY WAS COLLECTED BY
RPG RESOURCES IN DECEMBER OF 2020 BY USE
OF UAV**

SITE ACREAGE:

- AREA INSIDE FENCE: 6.6 ACRES
- PERMITTED DISTURBANCE AREA: 6.5 ACRES
- PAD SURFACE AREA: 5.2 ACRES

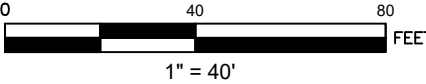

LEGEND


- LOD — LOD — PERMITTED LOD
- - - - - EXISTING FENCE
- - - - - EXISTING EDGE OF PAD
- - - - - EXISTING ACCESS ROAD
- EXISTING WELL HEAD



STATE NORTH PLATTE F-36 AS BUILT EXHIBIT

5N, 63W, SECTION 36, WELD COUNTY,
COLORADO

SHEET NAME:	SHEET NO.:
AERIAL IMAGERY	1 OF 2

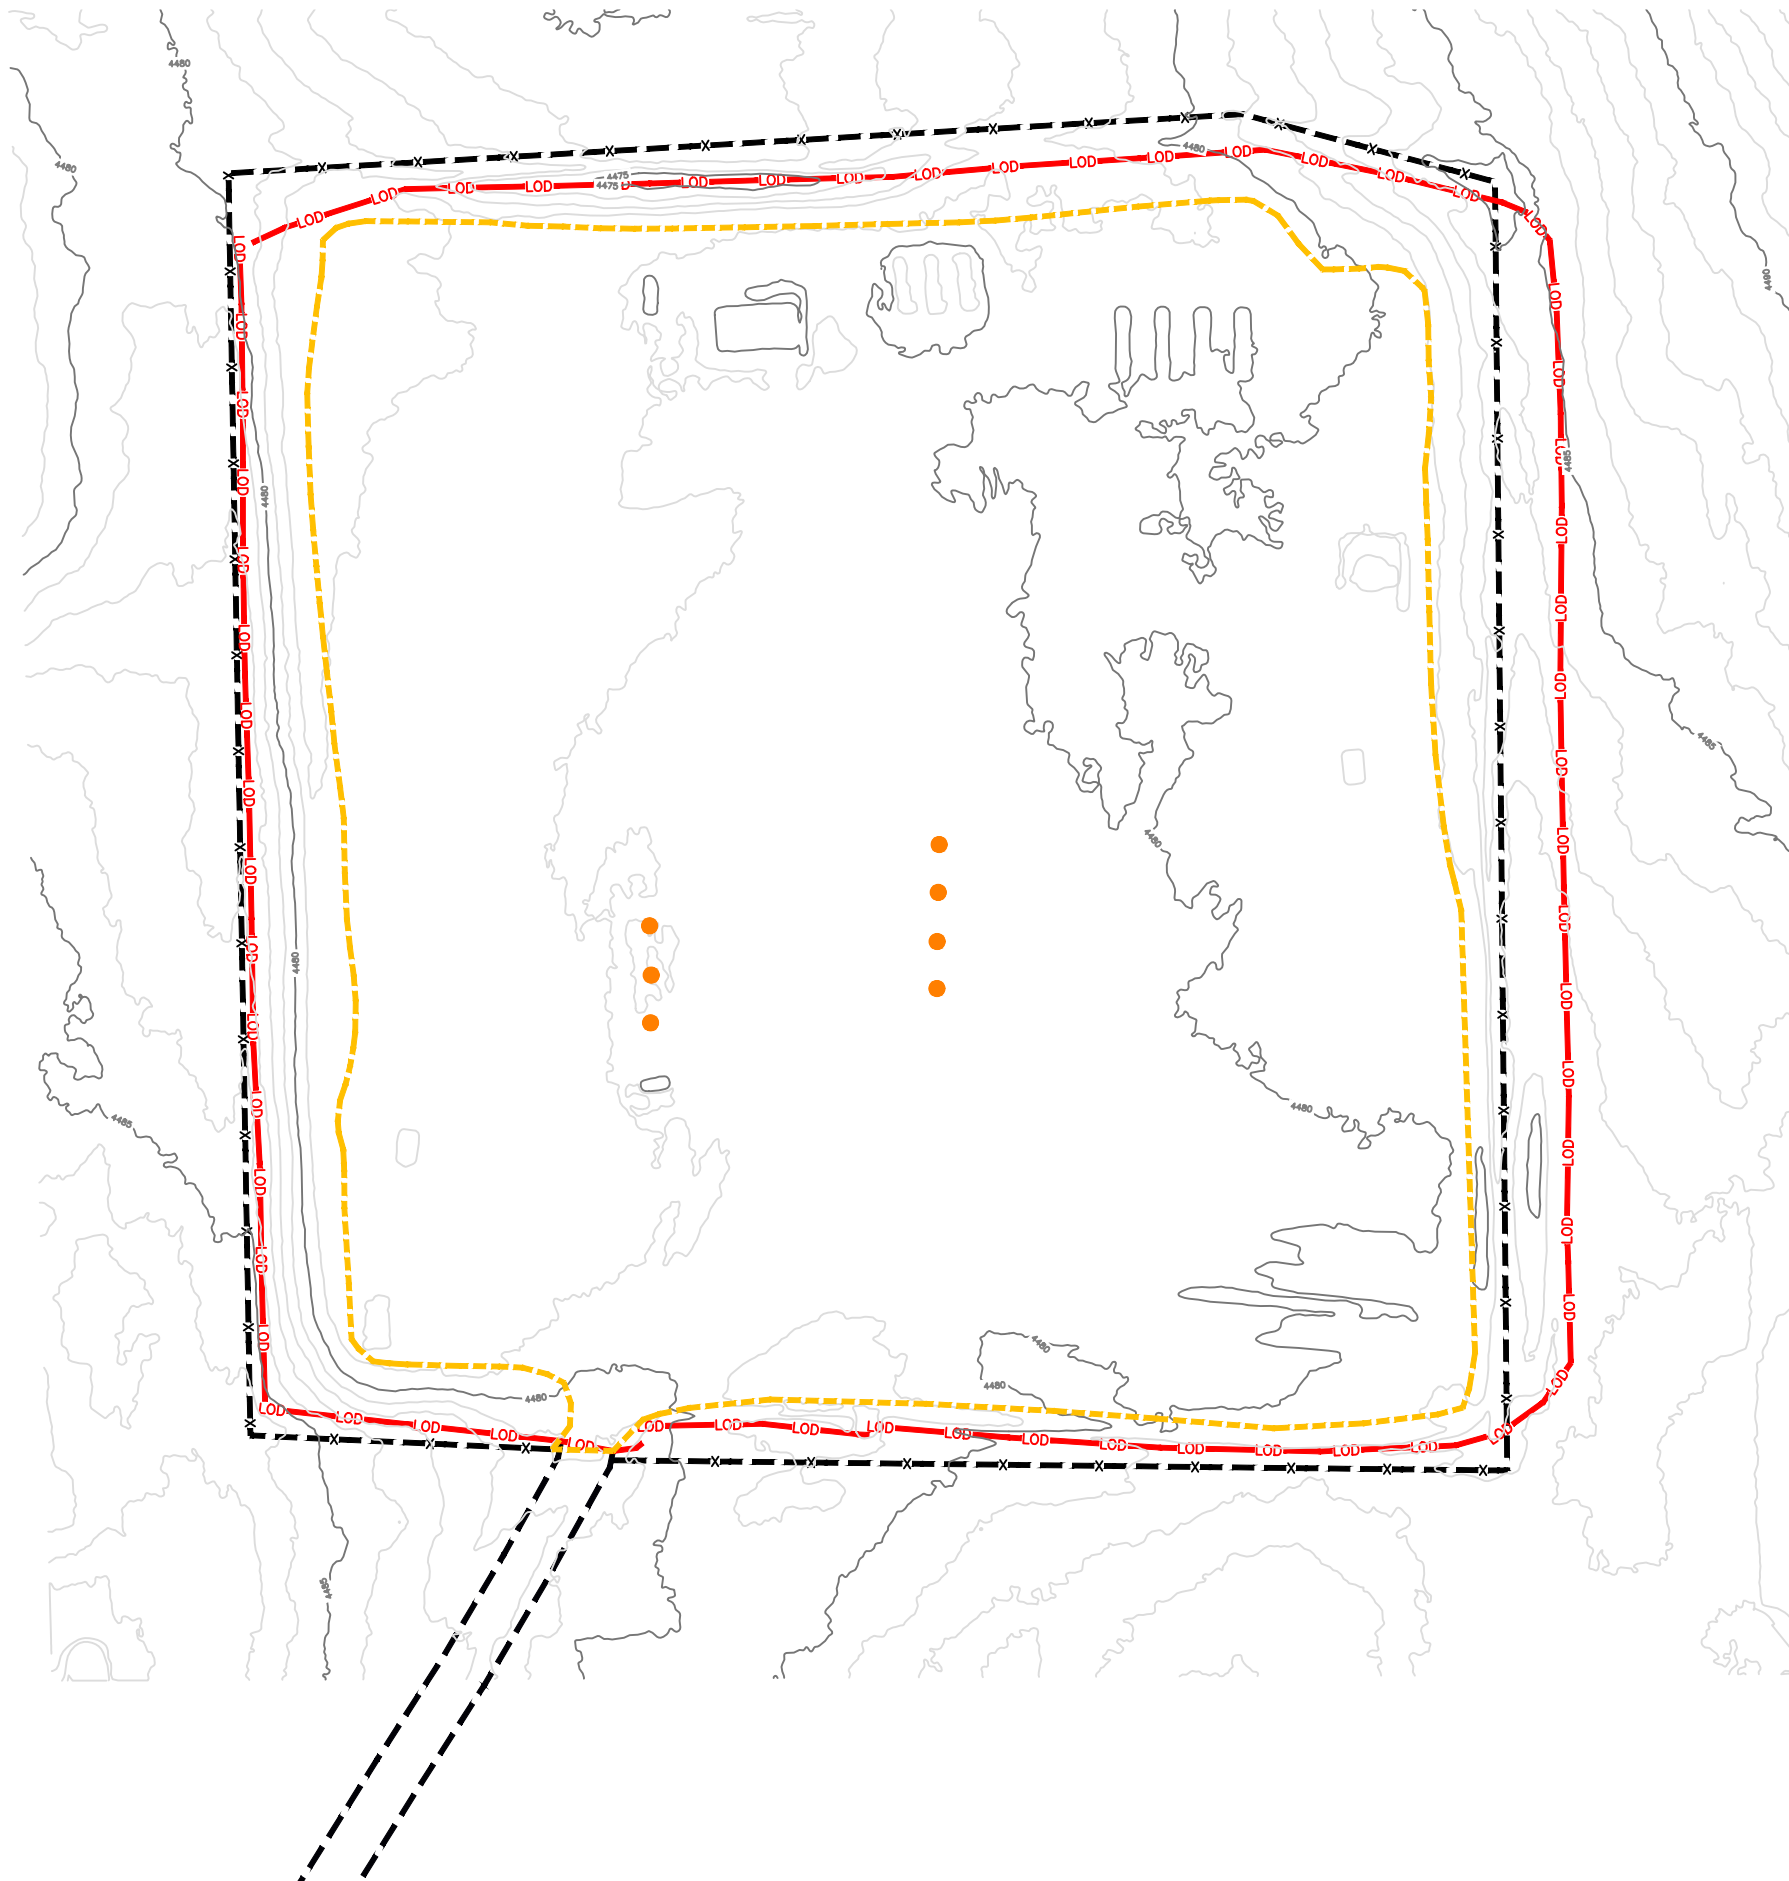

NOTES


** UPDATED TOPOGRAPHIC DATA WAS
COLLECTED BY RPG RESOURCES IN DECEMBER
OF 2020 BY USE OF UAV**

SITE ACREAGE:

AREA INSIDE FENCE: 6.6 ACRES

PERMITTED DISTURBANCE AREA: 6.5 ACRES

PAD SURFACE AREA: 5.2 ACRES

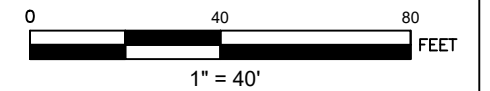

LEGEND

- 4605— EXISTING MAJOR CONTOUR
- EXISTING MINOR CONTOUR
- LOD—LOD— PERMITTED LOD
- - - - - EXISTING FENCE
- - - - - EXISTING EDGE OF PAD
- - - - - EXISTING ACCESS ROAD
- EXISTING WELL HEAD



STATE NORTH PLATTE F-36 AS BUILT EXHIBIT

5N, 63W, SECTION 36, WELD COUNTY,
COLORADO

SHEET NAME:	SHEET NO.:
TOPO OVERVIEW	2 OF 2