


AERIAL AS-BUILT PAD LAYOUT

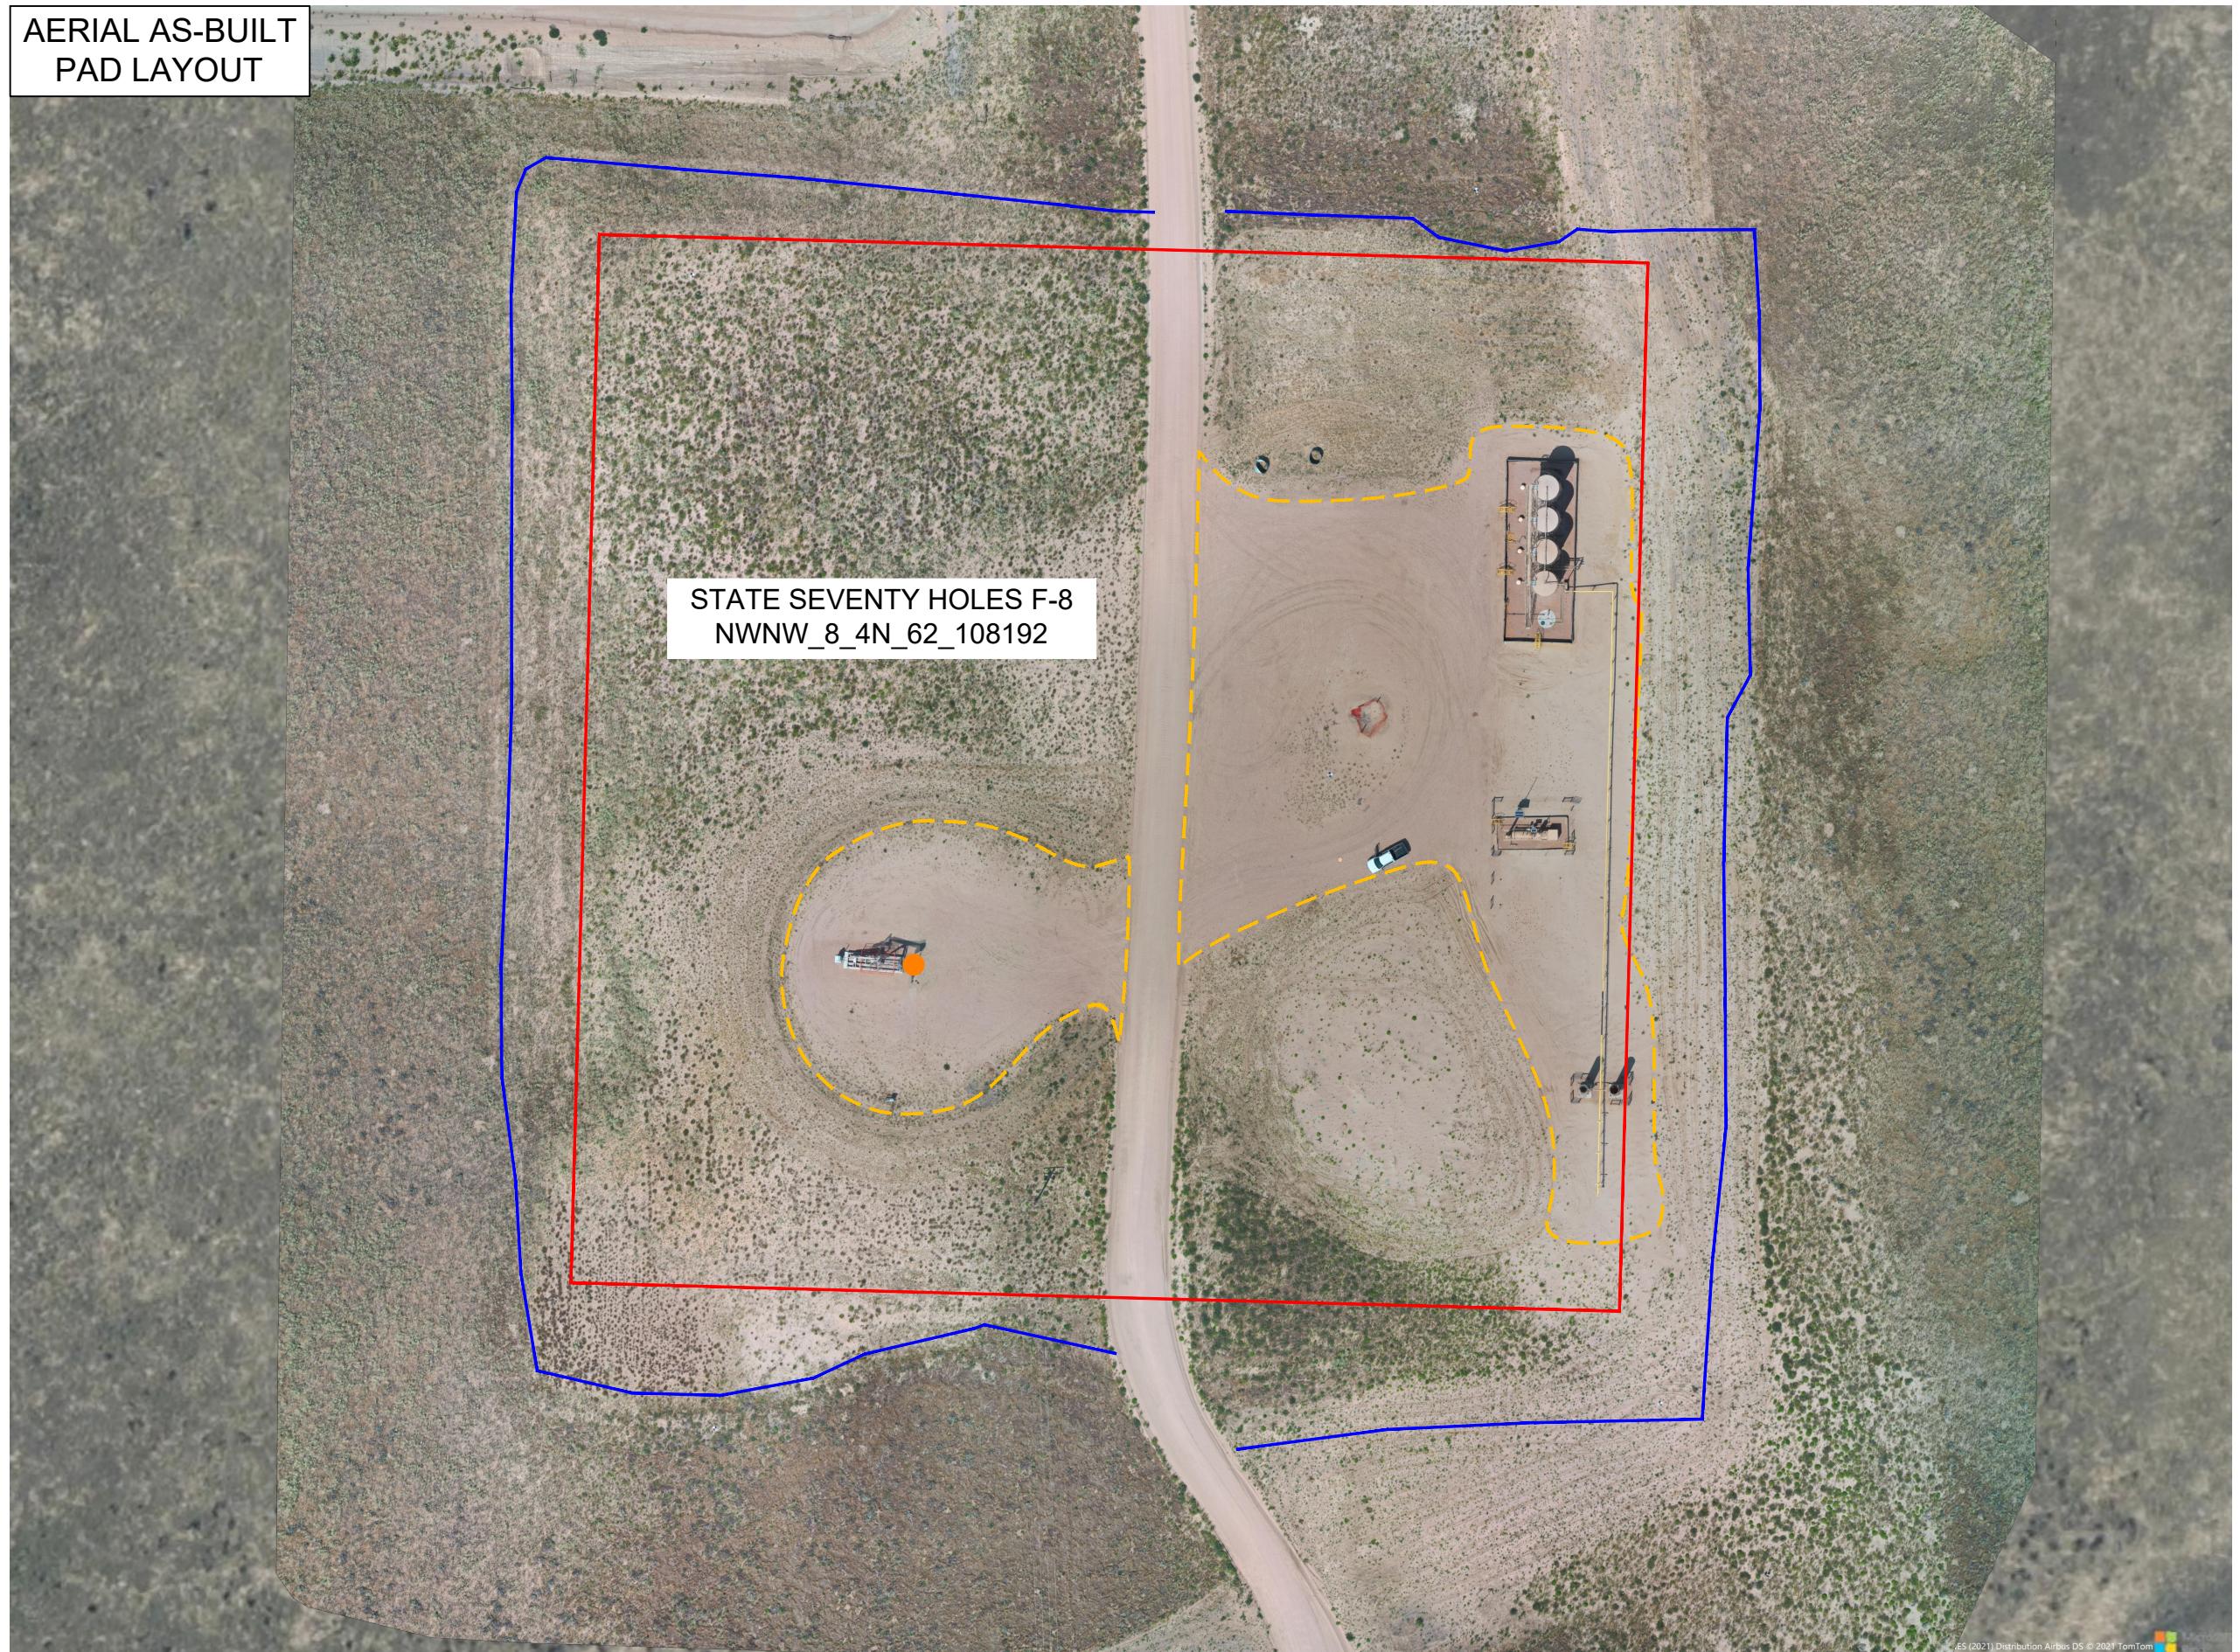


NOTES

UPDATED AERIAL ORTHOIMAGERY COLLECTED BY RPG RESOURCES BY USE OF UAV IN AUGUST, 2021

DISTURBED AREA SHAPE FROM SURVEY COLLECTED BY LAT40 INC. IN JUNE, 2015

SURVEYED DISTURBED AREA: 7.58 ACRES

INT. RECLAMATION PAD FOOTPRINT AREA: 1.62 ACRES

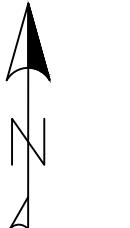

0 80 160
1" = 80' FT

LEGEND

- PERMITTED MAX DISTURBANCE
- SURVEYED MAX DISTURBANCE
- PAD EDGE
- WELL HEAD




STATE SEVENTY HOLES F-8 AS-BUILT EXHIBITS

SECTION 8, TOWNSHIP 4N, RANGE 62W,
WELD COUNTY, COLORADO

SHEET NAME:	SHEET NO.
AERIAL IMAGERY	1 OF 2

**TOPO AS-BUILT
PAD LAYOUT**

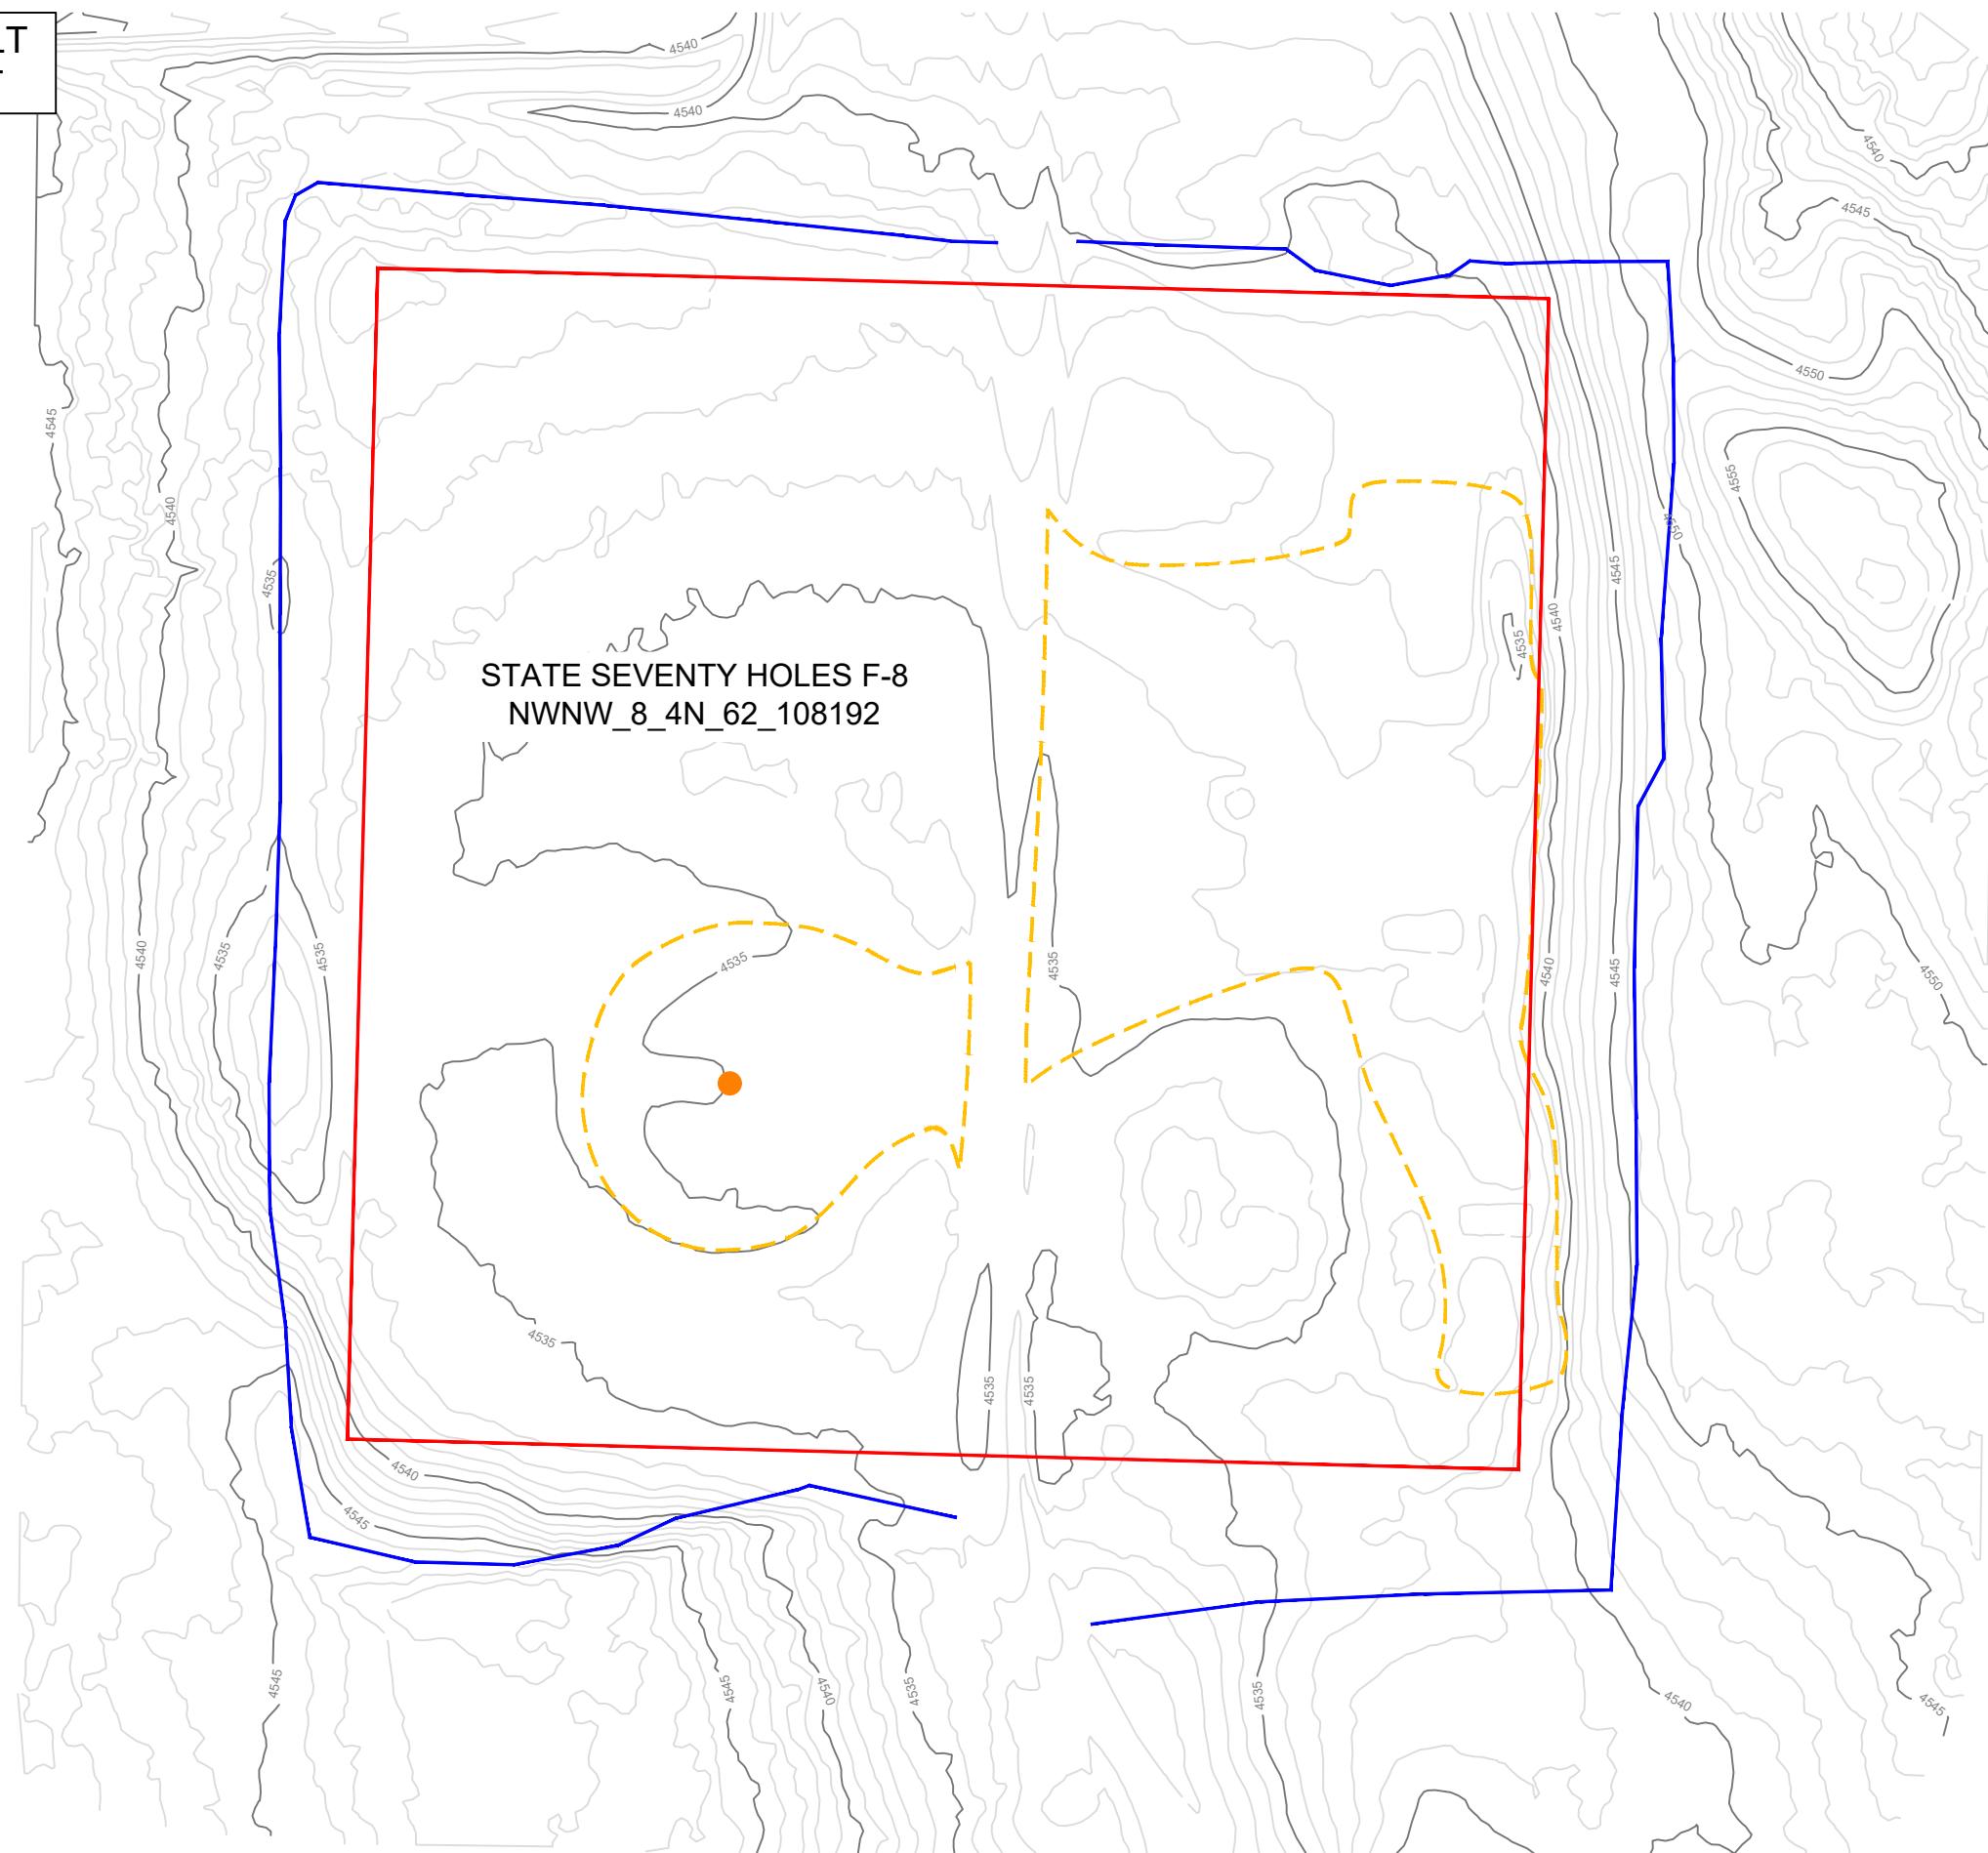

NOTES

UPDATED AERIAL ORTHOIMAGERY COLLECTED BY RPG RESOURCES BY USE OF UAV IN AUGUST, 2021

DISTURBED AREA SHAPE FROM SURVEY COLLECTED BY LAT40 INC. IN JUNE, 2015

SURVEYED DISTURBED AREA: 7.58 ACRES

INT. RECLAMATION PAD FOOTPRINT AREA: 1.62 ACRES



LEGEND

- MAJOR CONTOUR
- MINOR CONTOUR
- PERMITTED MAX DISTURBANCE
- SURVEYED MAX DISTURBANCE
- PAD EDGE
- WELL HEAD



**STATE SEVENTY HOLES F-8
AS-BUILT EXHIBITS**

SECTION 8, TOWNSHIP 4N, RANGE 62W,
WELD COUNTY, COLORADO

SHEET NAME:	SHEET NO.
TOPO OVERVIEW	2 OF 2