

AERIAL AS-BUILT PAD LAYOUT



NOTES

UPDATED AERIAL ORTHOIMAGERY COLLECTED BY RPG RESOURCES BY USE OF UAV IN AUGUST, 2021

AREA INSIDE FENCE: 5.31 ACRES

INT. RECLAMATION PAD FOOTPRINT AREA: 0.26 ACRES

ACCESS ROAD SURFACE AREA: 0.21 ACRES



0 60 120 FT
1" = 60'

LEGEND

- ACCESS ROAD
- FENCE LINE
- PAD EDGE
- WELL HEAD



STATE WHITETAIL 14-11-36HZ AS-BUILT EXHIBITS

SECTION 36, TOWNSHIP 6N, RANGE 62W,
WELD COUNTY, COLORADO

SHEET NAME:	SHEET NO.
AERIAL IMAGERY	1 OF 3

AERIAL AS-BUILT
ACCESS ROAD

STATE WHITETAIL 14-11-36HZ
SWSW_36_6N_62W_108487


NOTES

**UPDATED AERIAL ORTHOIMAGERY COLLECTED BY
RPG RESOURCES BY USE OF UAV IN AUGUST, 2021**

AREA INSIDE FENCE: 5.31 ACRES

INT. RECLAMATION PAD FOOTPRINT AREA: 0.26 ACRES

ACCESS ROAD SURFACE AREA: 0.21 ACRES

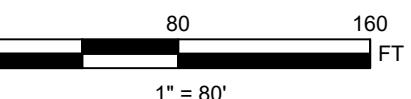

LEGEND

- ACCESS ROAD
- FENCE LINE
- PAD EDGE
- WELL HEAD




STATE WHITETAIL 14-11-36HZ
AS-BUILT EXHIBITS

SECTION 36, TOWNSHIP 6N, RANGE 62W,
WELD COUNTY, COLORADO

SHEET NAME:	SHEET NO.
ACCESS ROAD	2 OF 3

**TOPO AS-BUILT
PAD LAYOUT**

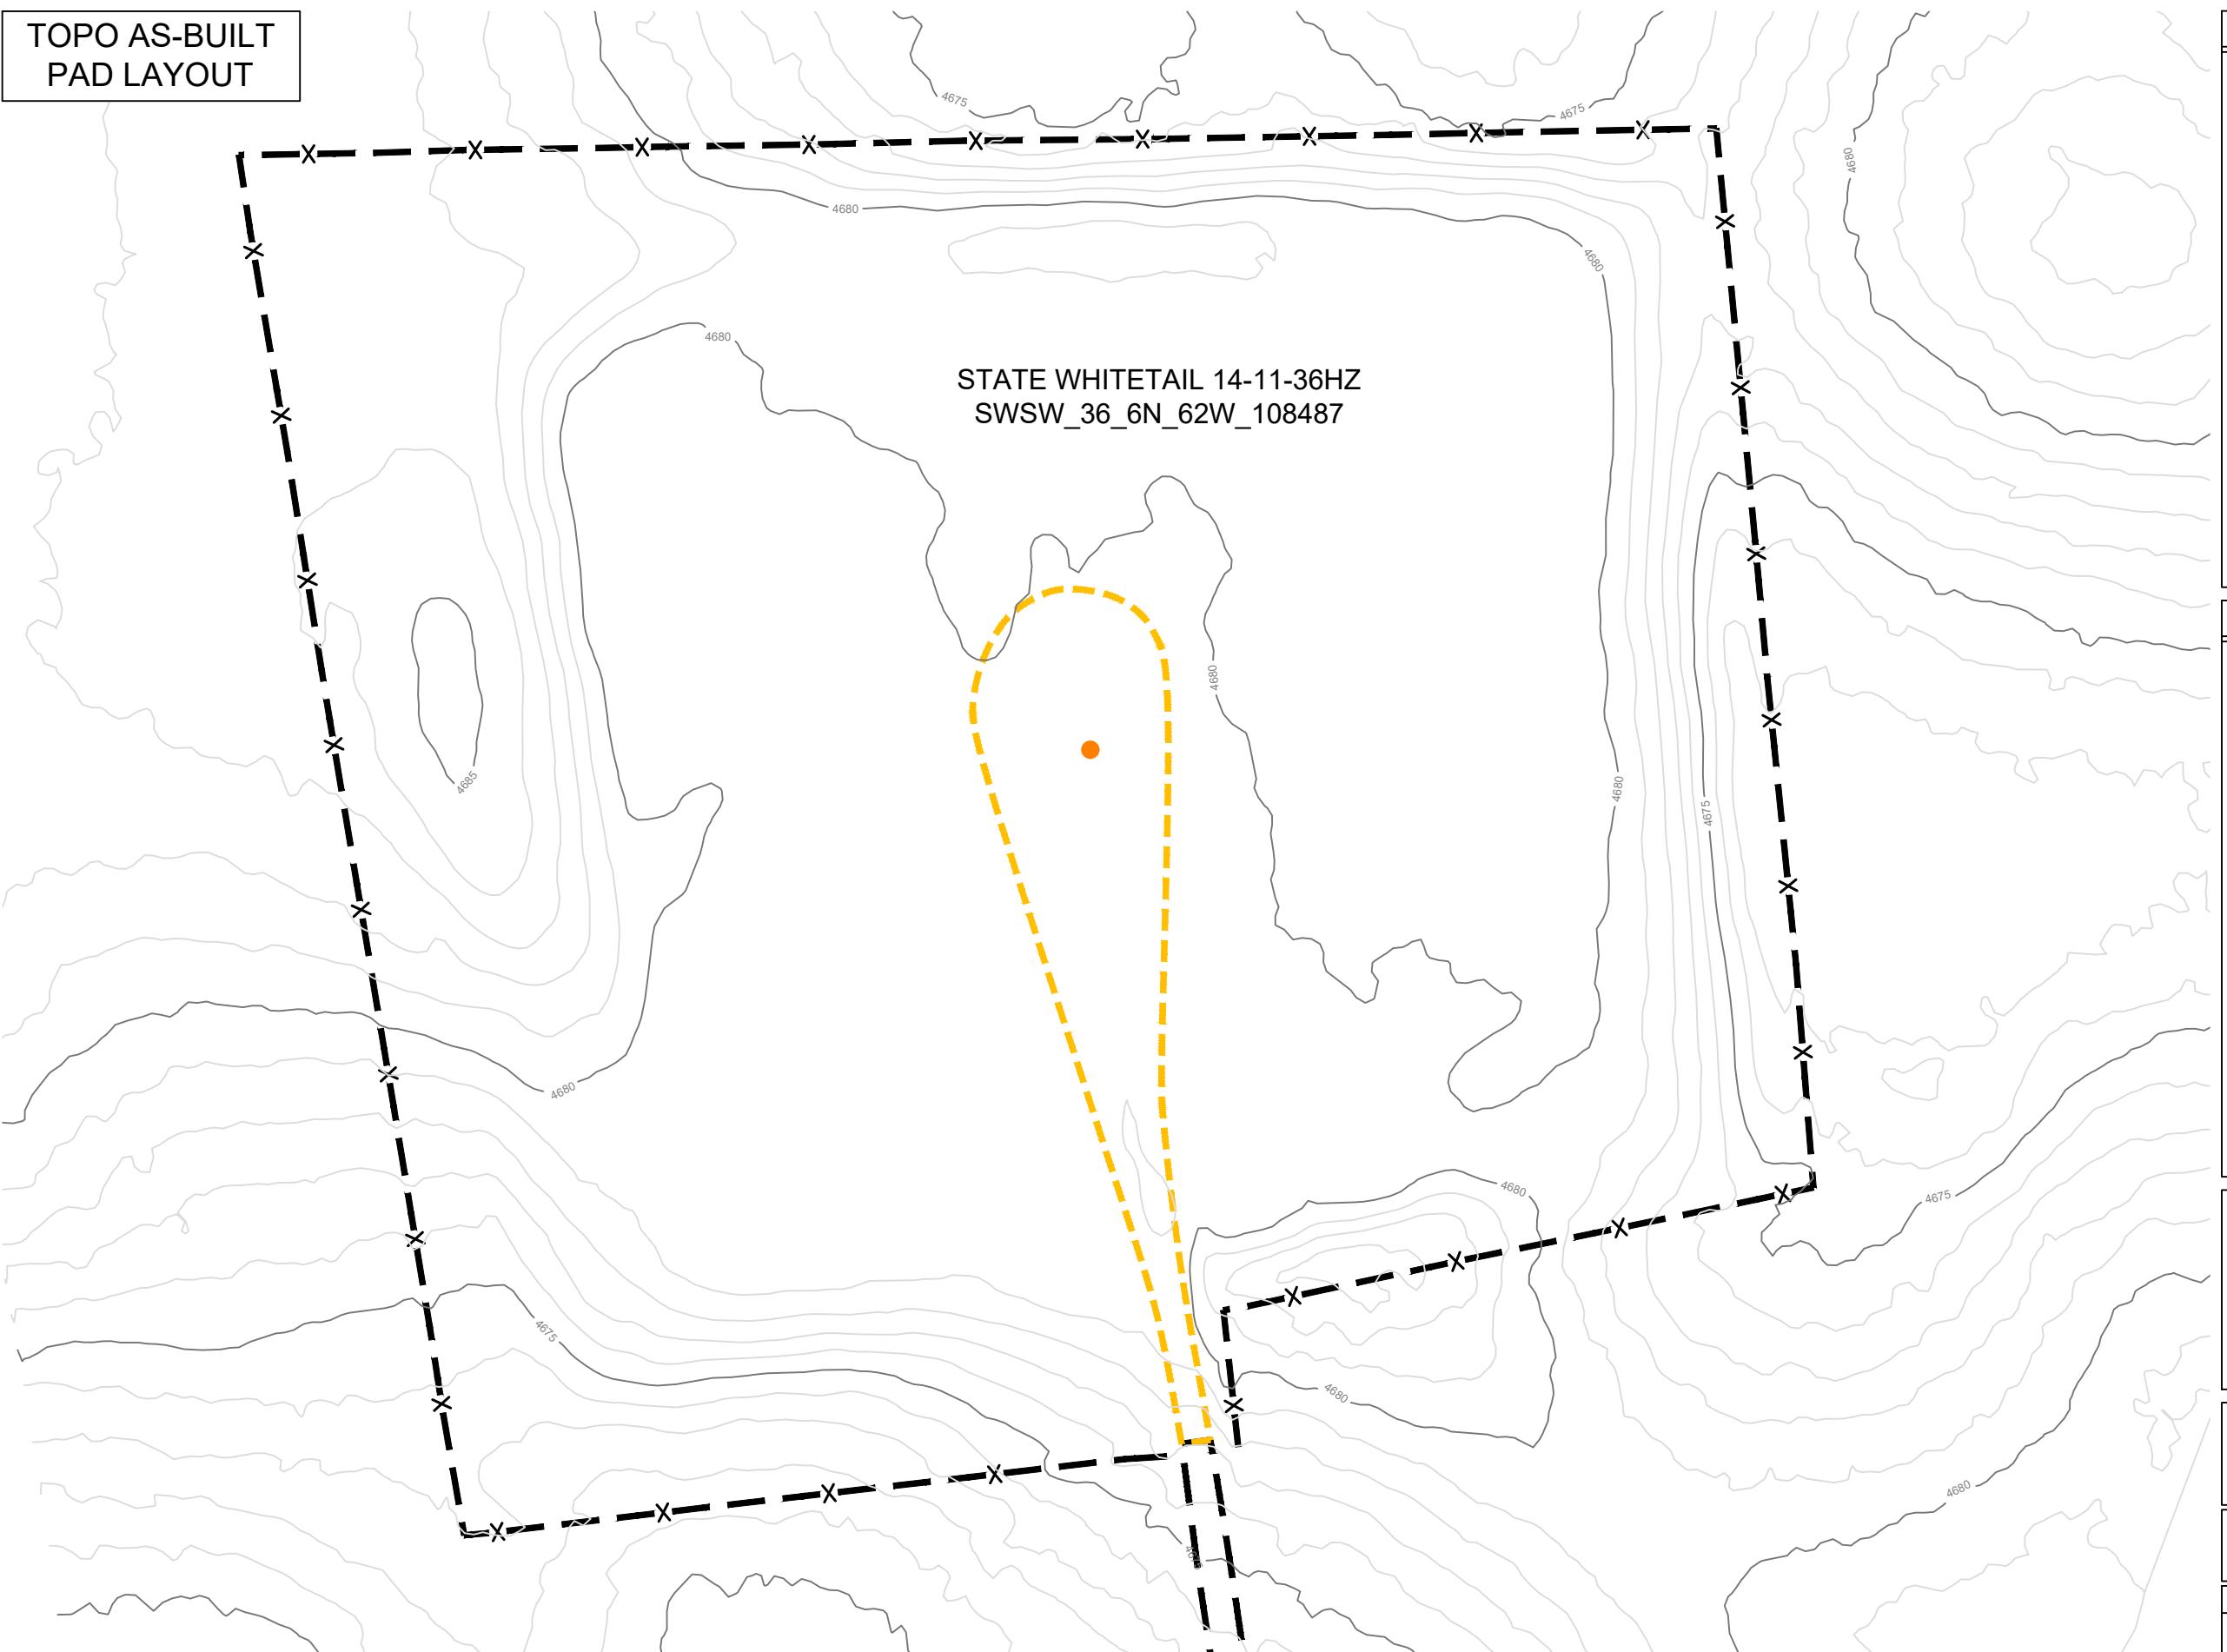

NOTES

**UPDATED TOPO DATA COLLECTED BY RPG
RESOURCES BY USE OF UAV IN AUGUST, 2021**

PERMITTED DISTURBED AREA: 4.80 ACRES

AREA INSIDE FENCE: 5.31 ACRES

INT. RECLAMATION PAD FOOTPRINT AREA: 0.26 ACRES

ACCESS ROAD SURFACE AREA: 0.21 ACRES



0 60 120
1" = 60' FT

LEGEND

- 4680 — MAJOR CONTOUR
- 4680 — MINOR CONTOUR
- - - - - ACCESS ROAD
- - - - - FENCE LINE
- - - - - PAD EDGE
- WELL HEAD



**STATE WHITETAIL 14-11-36HZ
AS-BUILT EXHIBITS**

SECTION 36, TOWNSHIP 6N, RANGE 62W,
WELD COUNTY, COLORADO

SHEET NAME:	SHEET NO.
TOPO OVERVIEW	3 OF 3