

AERIAL AS-BUILT
PAD LAYOUT




NOTES

UPDATED AERIAL ORTHOIMAGERY COLLECTED BY RPG RESOURCES BY USE OF UAV IN AUGUST, 2021

FIELD OBSERVED DISTURBED AREA : 8.00 ACRES

INT. RECLAMATION PAD FOOTPRINT AREA: 3.97 ACRES

ACCESS ROAD SURFACE AREA: 0.75 ACRES

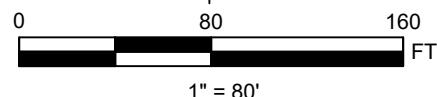

LEGEND

- — — — ACCESS ROAD
- — — — PERMITTED MAX DISTURBANCE
- — — — FIELD OBSERVED DISTURBED AREA
- — — — PAD EDGE
- WELL HEAD




STATE NORTH PLATTE O-26
AS-BUILT EXHIBITS

SECTION 26, TOWNSHIP 5N, RANGE 63W,
WELD COUNTY, COLORADO

SHEET NAME:	SHEET NO.
AERIAL IMAGERY	1 OF 3

**TOPO AS-BUILT
PAD LAYOUT**

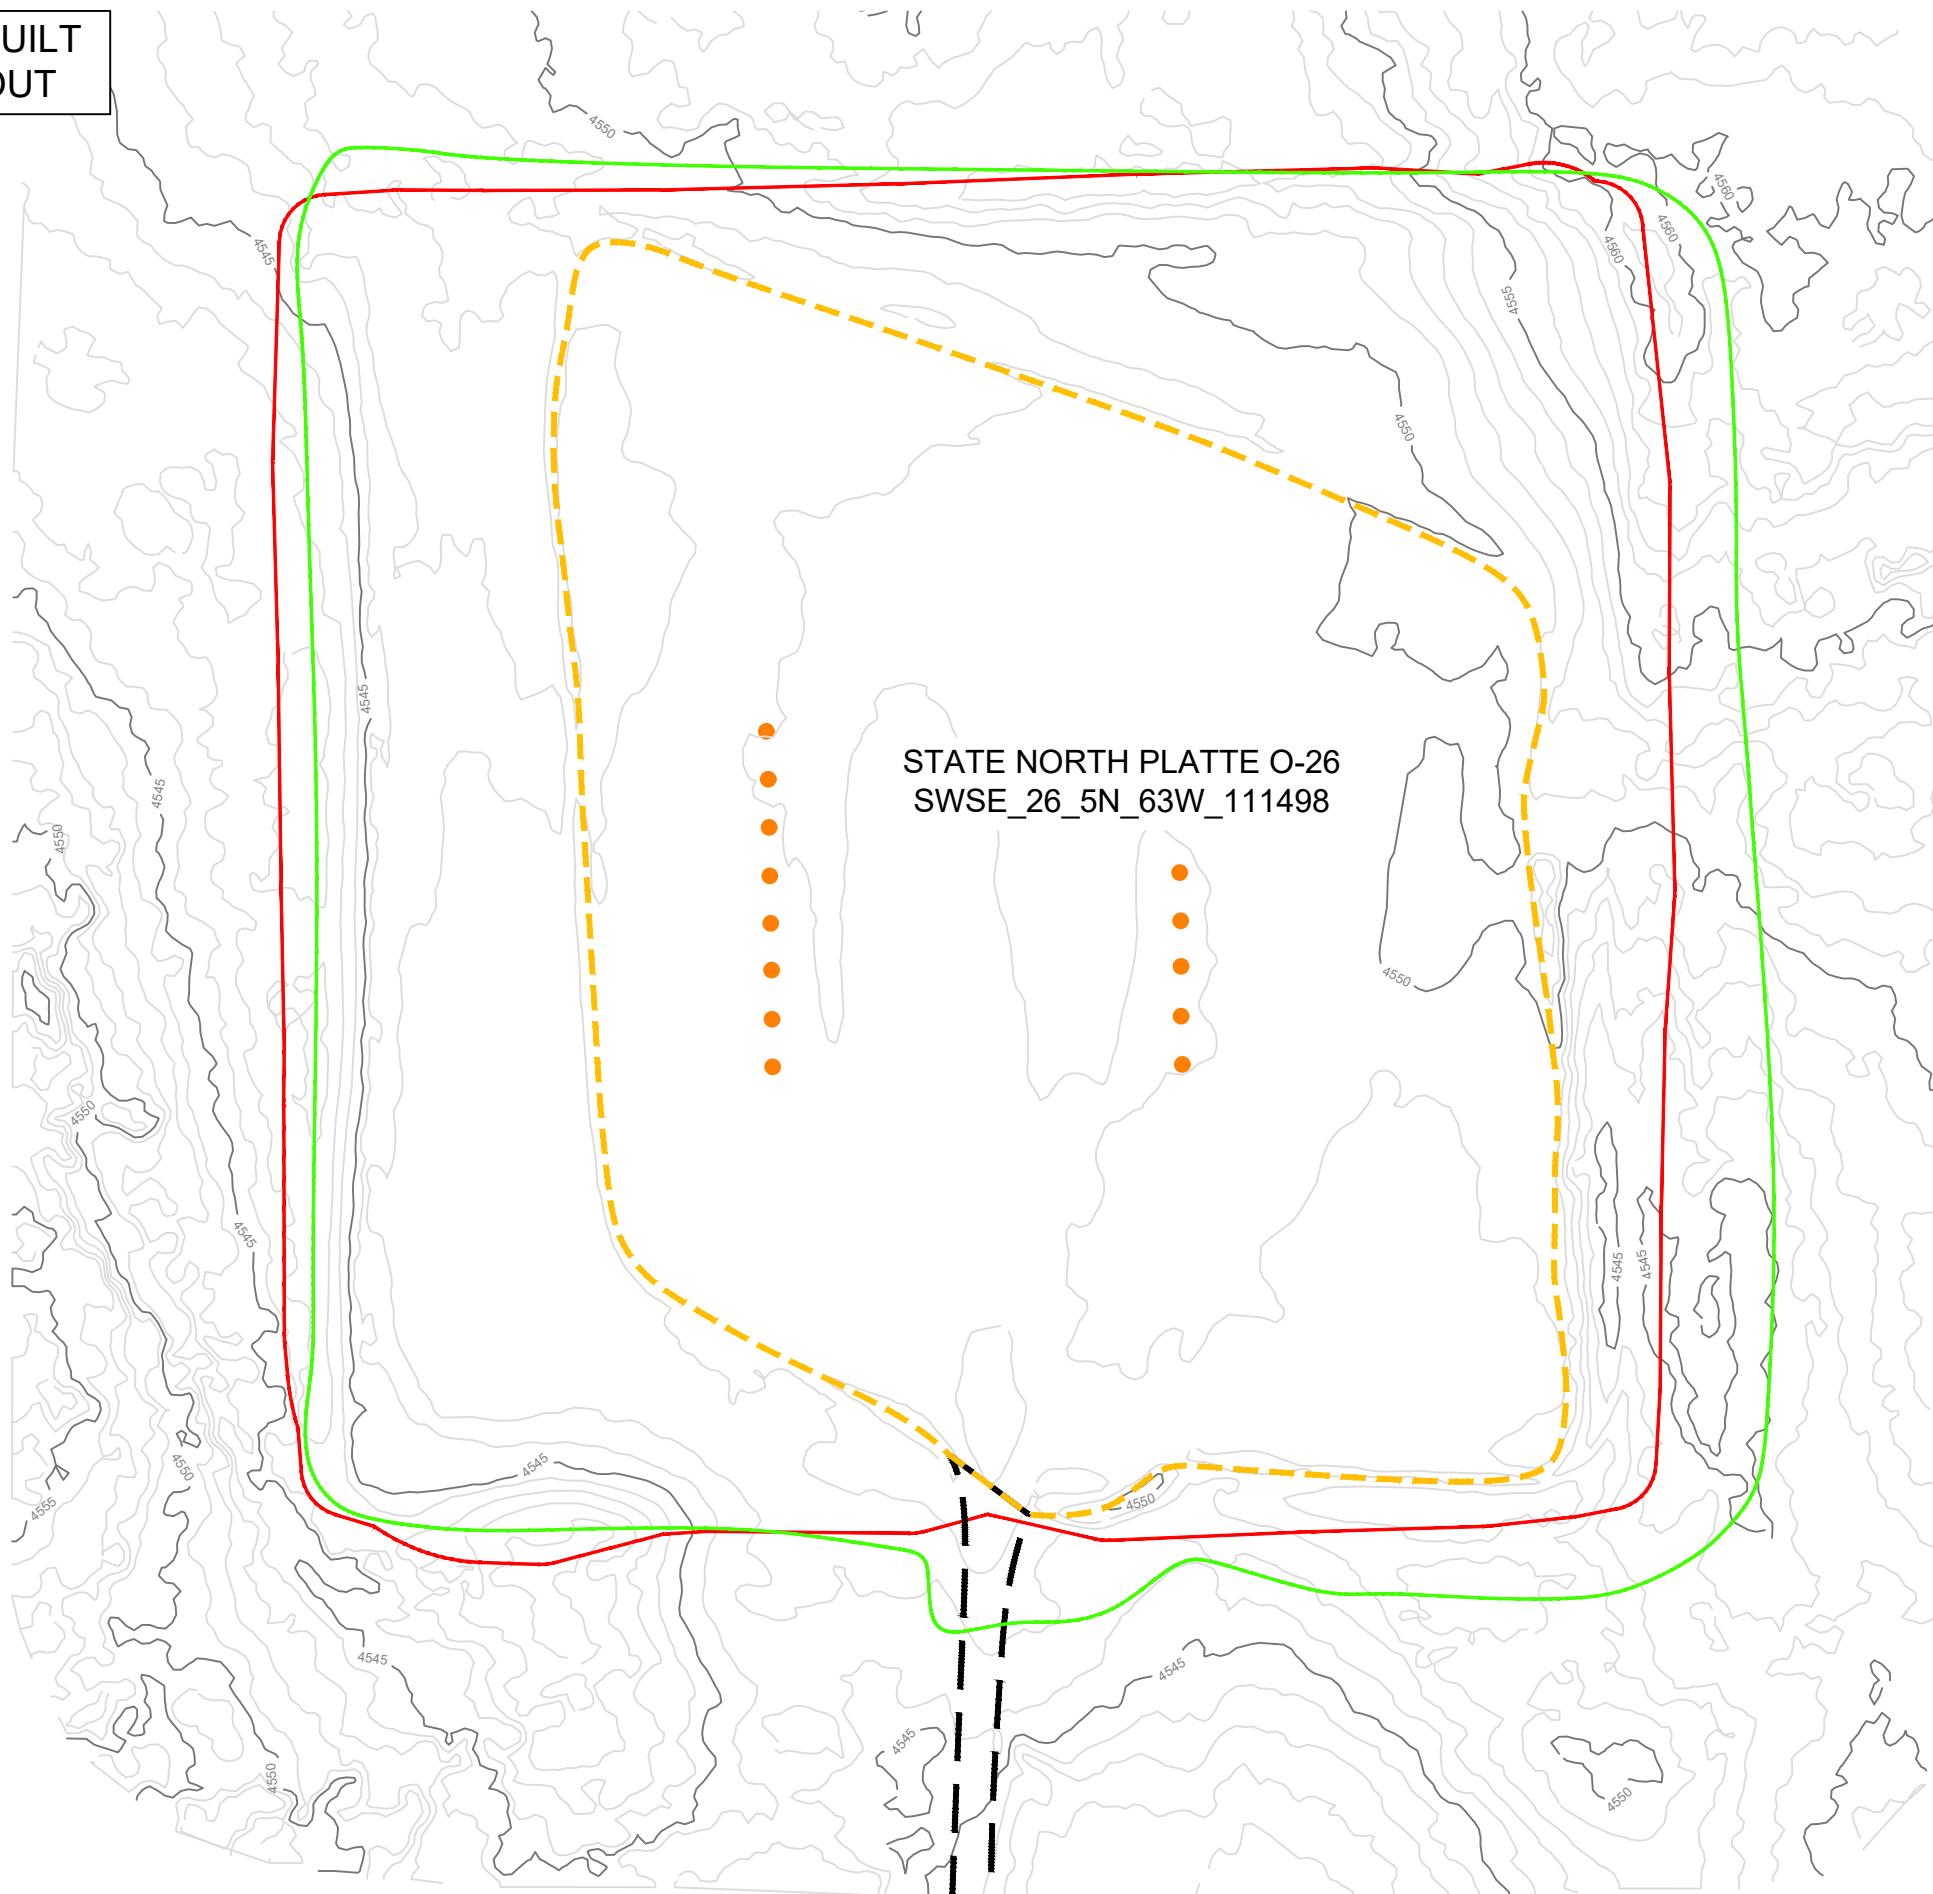

NOTES

**UPDATED TOPO DATA COLLECTED BY RPG
RESOURCES BY USE OF UAV IN AUGUST, 2021**

FIELD OBSERVED DISTURBED AREA : 8.00 ACRES
INT. RECLAMATION PAD FOOTPRINT AREA: 3.97 ACRES
ACCESS ROAD SURFACE AREA: 0.75 ACRES



0 80 160 FT
1" = 80'

LEGEND


- 4505 — MAJOR CONTOUR
- 4545 — MINOR CONTOUR
- - - - - ACCESS ROAD
- PERMITTED MAX DISTURBANCE
- FIELD OBSERVED DISTURBED AREA
- - - - - PAD EDGE
- WELL HEAD



**STATE NORTH PLATTE F-26
AS-BUILT EXHIBITS**

SECTION 26, TOWNSHIP 5N, RANGE 63W,
WELD COUNTY, COLORADO

SHEET NAME:	SHEET NO.
TOPO OVERVIEW	3 OF 3

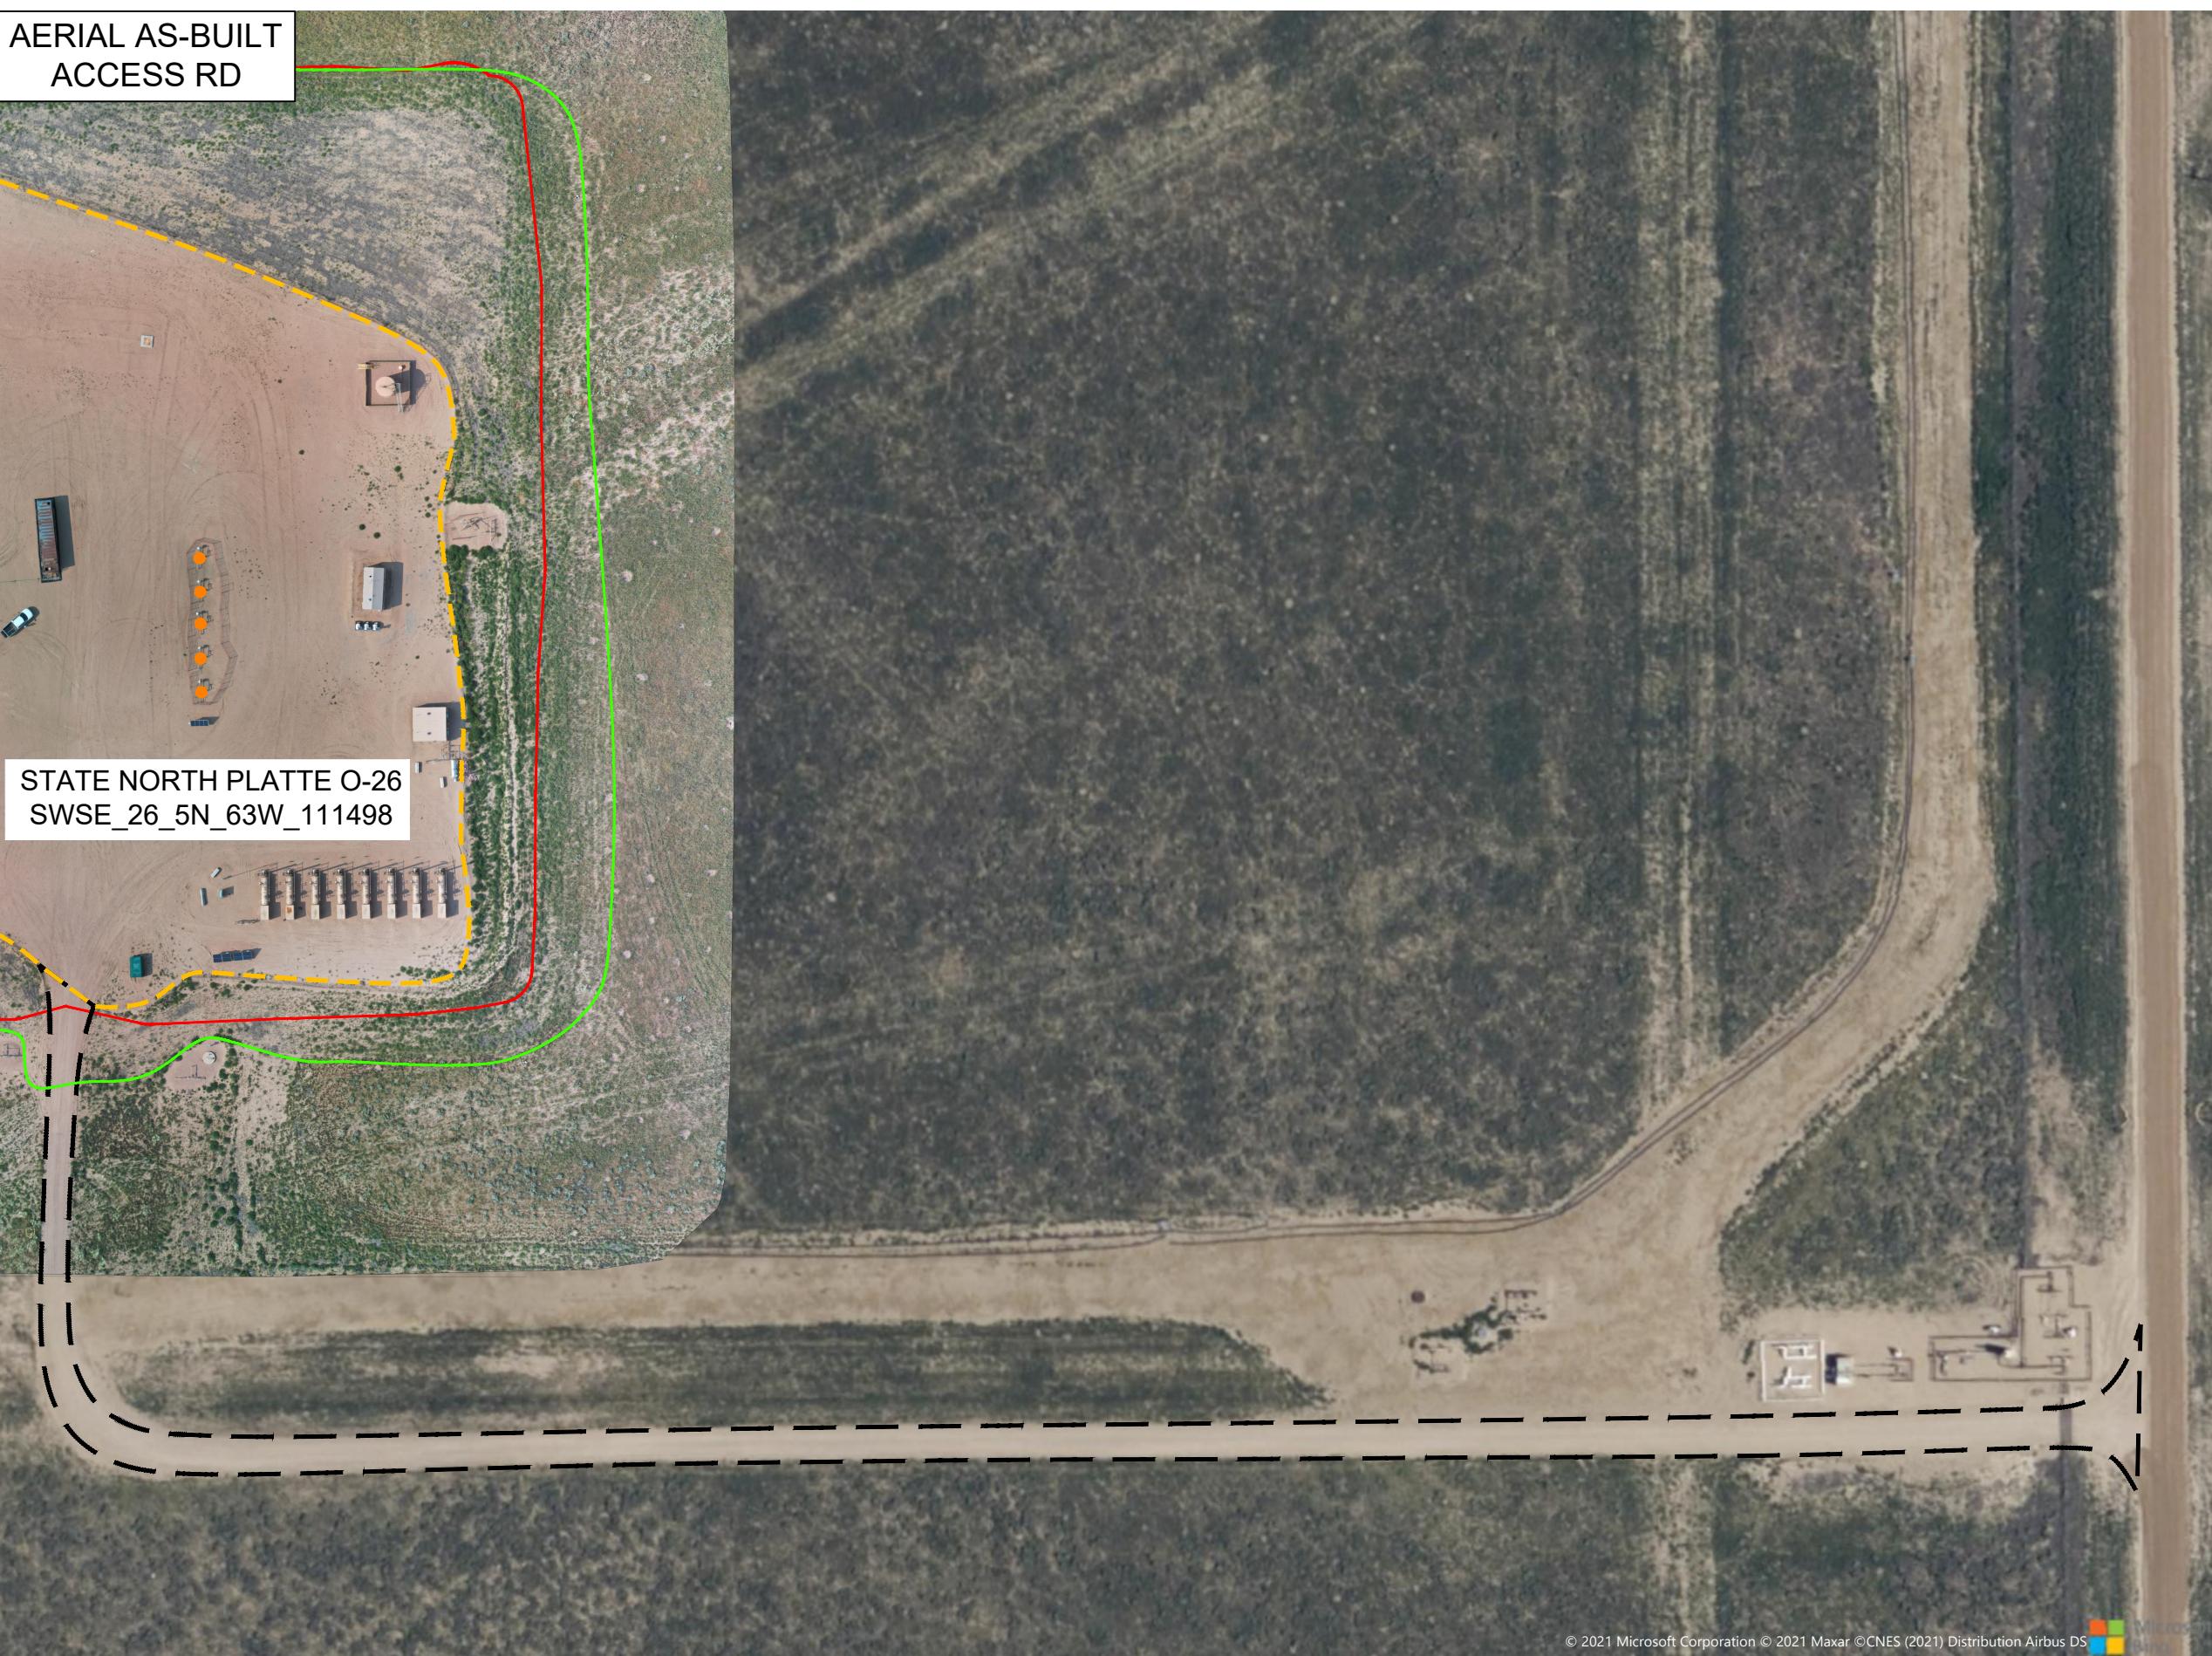

NOTES

UPDATED AERIAL ORTHOIMAGERY COLLECTED BY RPG RESOURCES BY USE OF UAV IN AUGUST, 2021

FIELD OBSERVED DISTURBED AREA : 8.00 ACRES
INT. RECLAMATION PAD FOOTPRINT AREA: 3.97 ACRES
ACCESS ROAD SURFACE AREA: 0.75 ACRES

0 100 200 FT
1" = 100'

LEGEND

- — — — ACCESS ROAD
- PERMITTED MAX DISTURBANCE
- FIELD OBSERVED DISTURBED AREA
- - - PAD EDGE
- WELL HEAD

RPG RESOURCES

**STATE NORTH PLATTE O-26
AS-BUILT EXHIBITS**

SECTION 26, TOWNSHIP 5N, RANGE 63W,
WELD COUNTY, COLORADO

SHEET NAME:	SHEET NO.
ACCESS RD	2 OF 3