


AERIAL AS-BUILT  
PAD LAYOUT



NOTES

\*\*UPDATED AERIAL ORTHOIMAGERY COLLECTED BY  
RPG RESOURCES BY USE OF UAV IN JUNE, 2021\*\*

PAD SURFACE AREA: 10.7 ACRES

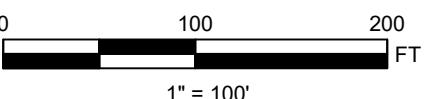

LEGEND

- EXISTING EDGE OF PAD
- - - EXISTING ACCESS ROAD



STATE NORTH PLATTE 42-26  
AS-BUILT EXHIBIT


5N, 63W, SECTION 26,  
WELD COUNTY, COLORADO

DRAFT SET  
FOR REVIEW  
ONLY  
6/17/2021

SIGNATURE DATE

SHEET NAME:	SHEET NO.
AERIAL IMAGERY	1 OF 2


**TOPO AS-BUILT  
PAD LAYOUT**

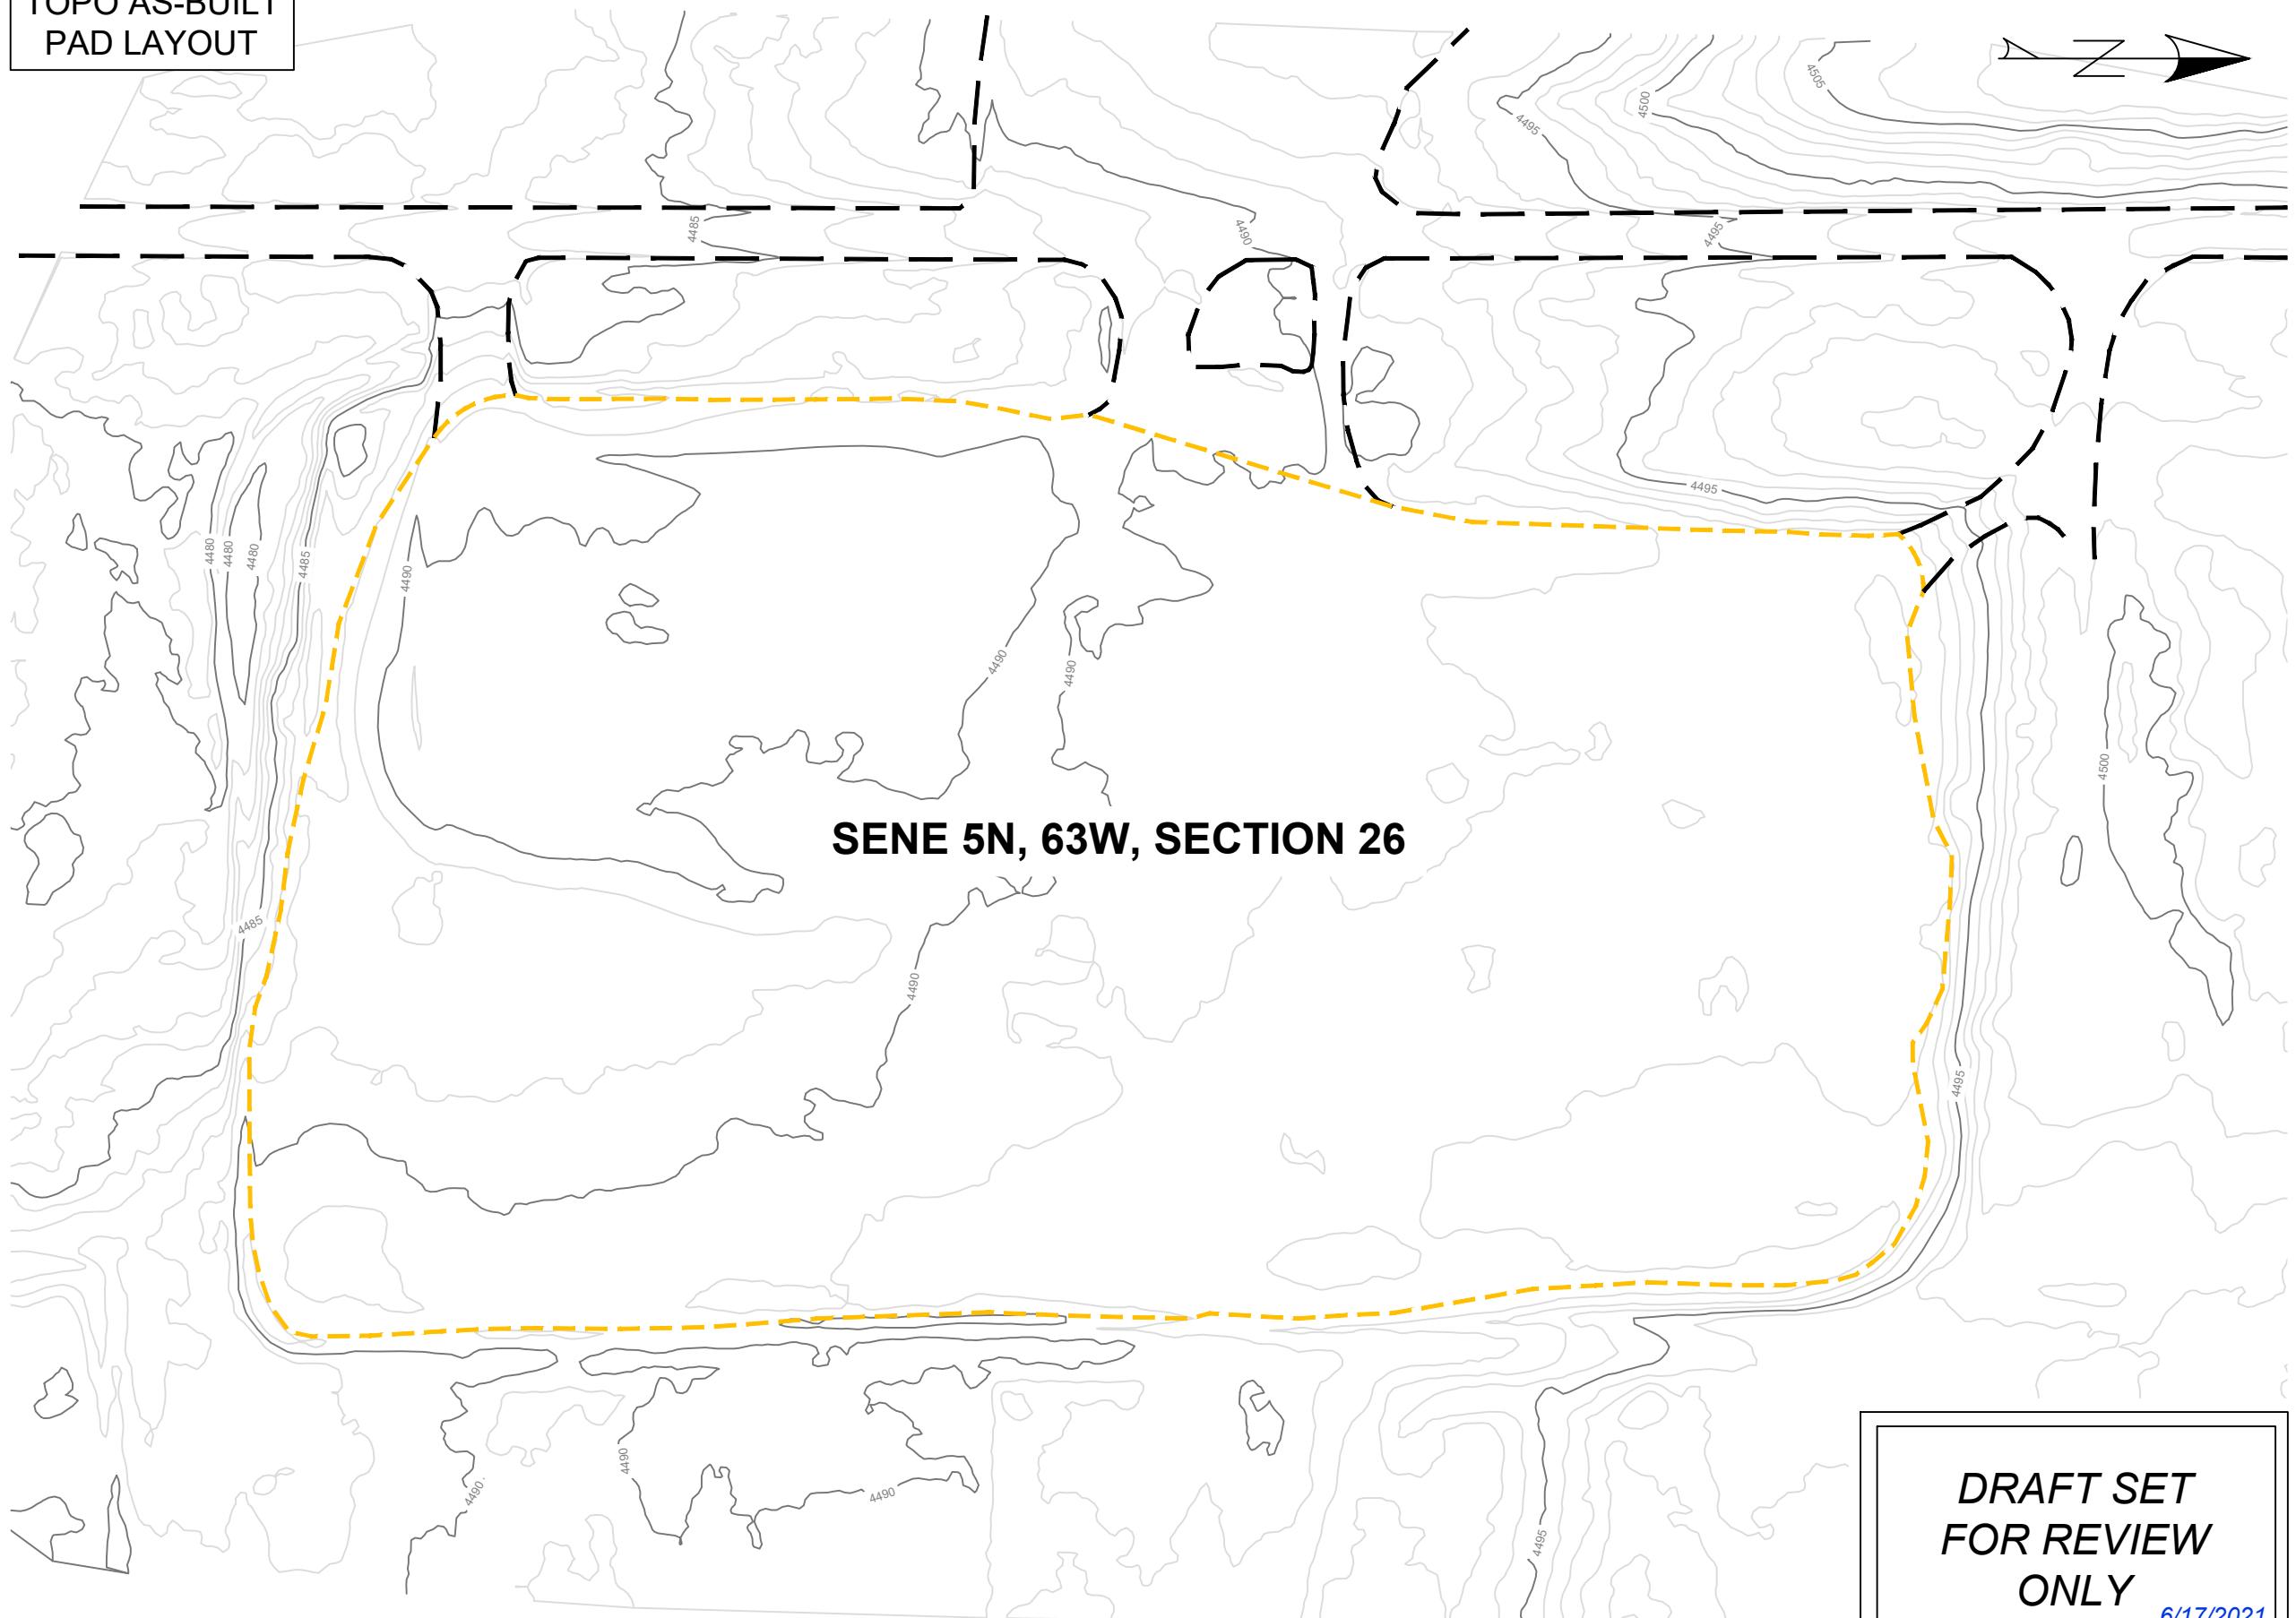

**NOTES**

\*\*UPDATED TOPO DATA COLLECTED BY RPG RESOURCES BY USE OF UAV IN JUNE, 2021\*\*

PAD SURFACE AREA: 10.7 ACRES

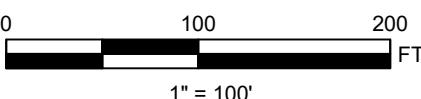

**LEGEND**

- 4605 — EXISTING MAJOR CONTOUR
- 4605 — EXISTING MINOR CONTOUR
- 4605 — EXISTING EDGE OF PAD
- 4605 — EXISTING ACCESS ROAD



**STATE NORTH PLATTE 42-26  
AS-BUILT EXHIBIT**

5N, 63W, SECTION 26,  
WELD COUNTY, COLORADO

**DRAFT SET  
FOR REVIEW  
ONLY**

6/17/2021

SIGNATURE

DATE

SHEET NAME:	SHEET NO.
TOPO OVERVIEW	2 OF 2