


## NOTES

\*\* UPDATED AERIAL IMAGERY WAS COLLECTED BY  
RPG RESOURCES IN DECEMBER OF 2020 BY USE  
OF UAV\*\*

### SITE ACREAGE:

AREA INSIDE FENCE: 6.6 ACRES

PAD SURFACE AREA: 5.2 ACRES

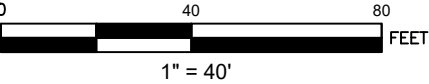

## LEGEND

- LOD — LOD — PERMITTED LOD
- - - - - EXISTING FENCE
- - - - - EXISTING EDGE OF PAD
- - - - - EXISTING ACCESS ROAD
- EXISTING WELL HEAD




## STATE NORTH PLATTE F-36 AS BUILT EXHIBIT

5N, 63W, SECTION 36, WELD COUNTY,  
COLORADO

SHEET NAME:  
AERIAL IMAGERY

SHEET NO.:  
1 OF 2



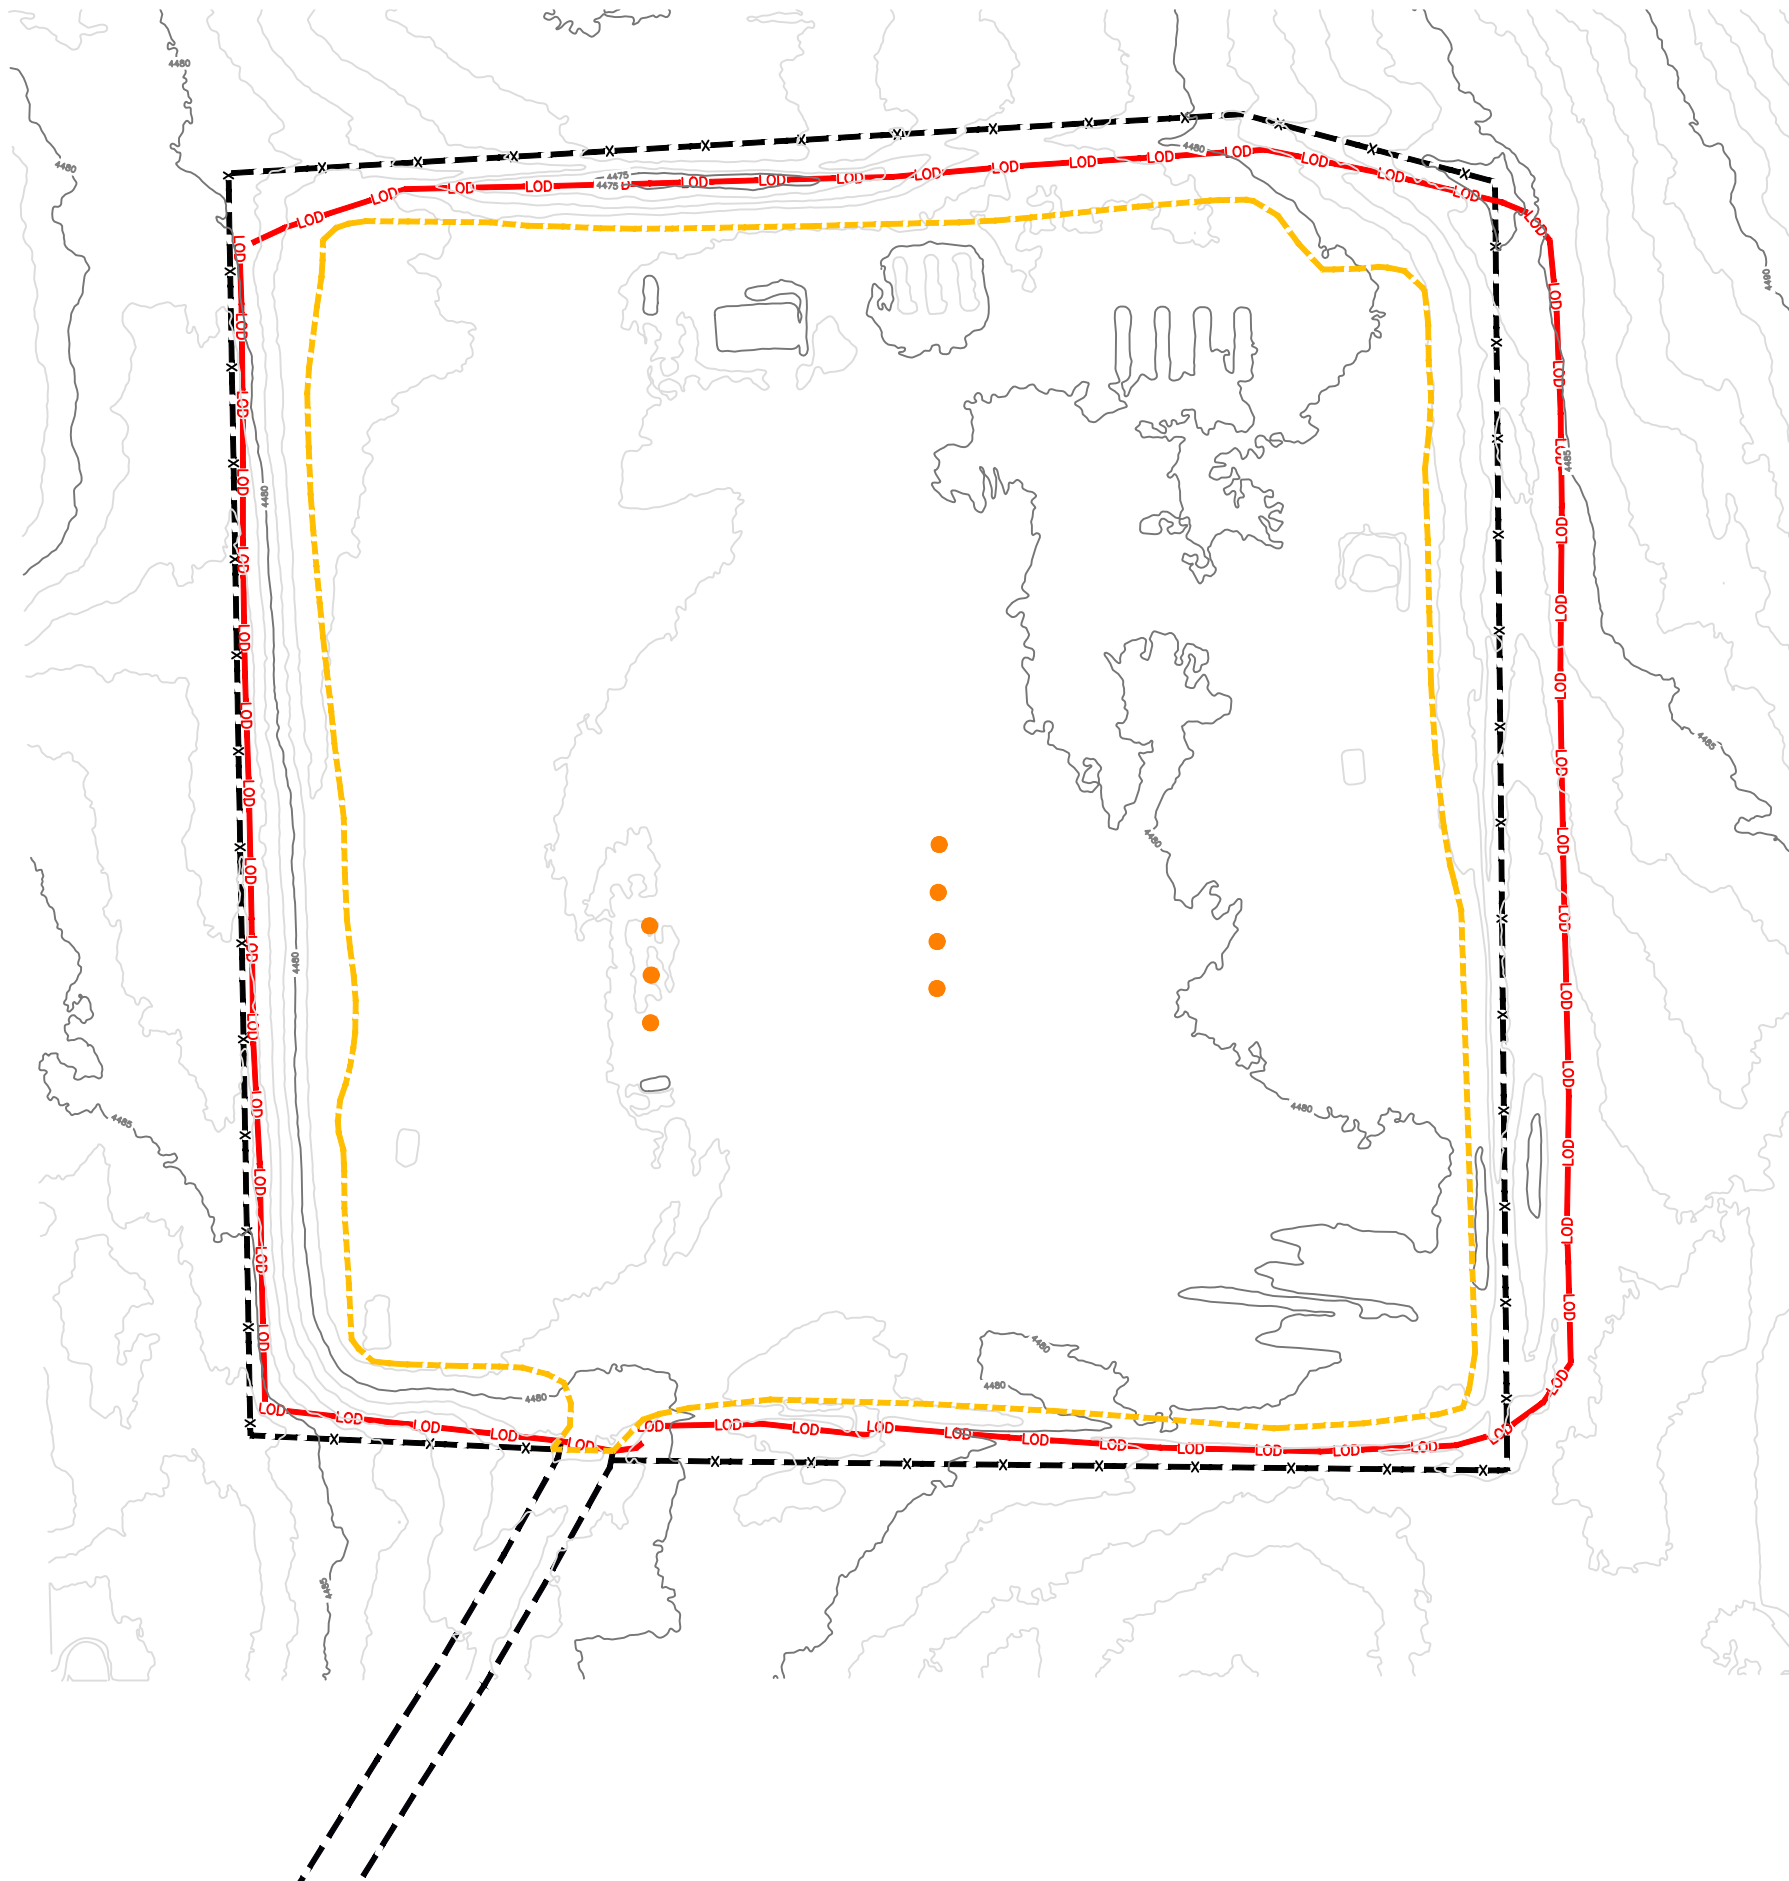


## NOTES

\*\* UPDATED TOPOGRAPHIC DATA WAS COLLECTED BY RPG RESOURCES IN DECEMBER OF 2020 BY USE OF UAV\*\*

### SITE ACREAGE:

AREA INSIDE FENCE: 6.6 ACRES

PAD SURFACE AREA: 5.2 ACRES

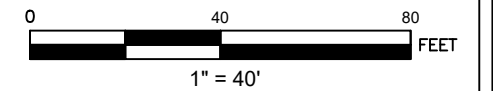

## LEGEND

- 4605— EXISTING MAJOR CONTOUR
- EXISTING MINOR CONTOUR
- LOD—LOD— PERMITTED LOD
- - - - - EXISTING FENCE
- - - - - EXISTING EDGE OF PAD
- - - - - EXISTING ACCESS ROAD
- EXISTING WELL HEAD



## STATE NORTH PLATTE F-36 AS BUILT EXHIBIT

5N, 63W, SECTION 36, WELD COUNTY,  
COLORADO

SHEET NAME:  
TOPO OVERVIEW

SHEET NO.:  
2 OF 2