

## AERIAL AS-BUILT PAD LAYOUT





## NOTES

\*\*UPDATED AERIAL ORTHOIMAGERY COLLECTED BY RPG RESOURCES BY USE OF UAV IN AUGUST, 2021\*\*

AREA INSIDE FENCE: 9.10 ACRES

INT. RECLAMATION PAD FOOTPRINT AREA: 1.46 ACRES

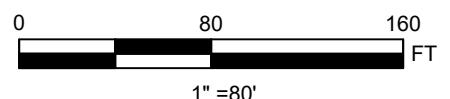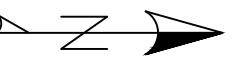

## LEGEND

- FENCE LINE
- PAD EDGE
- WELL HEAD




## STATE ANTELOPE 11-14-1HZ AS-BUILT EXHIBITS

SECTION 1, TOWNSHIP 5N, RANGE 62W,  
WELD COUNTY, COLORADO

SHEET NAME:	SHEET NO.
AERIAL IMAGERY	1 OF 2

# TOPO AS-BUILT PAD LAYOUT

STATE ANTELOPE 11-14-1HZ  
Lot 4 1 5N 62W 108485

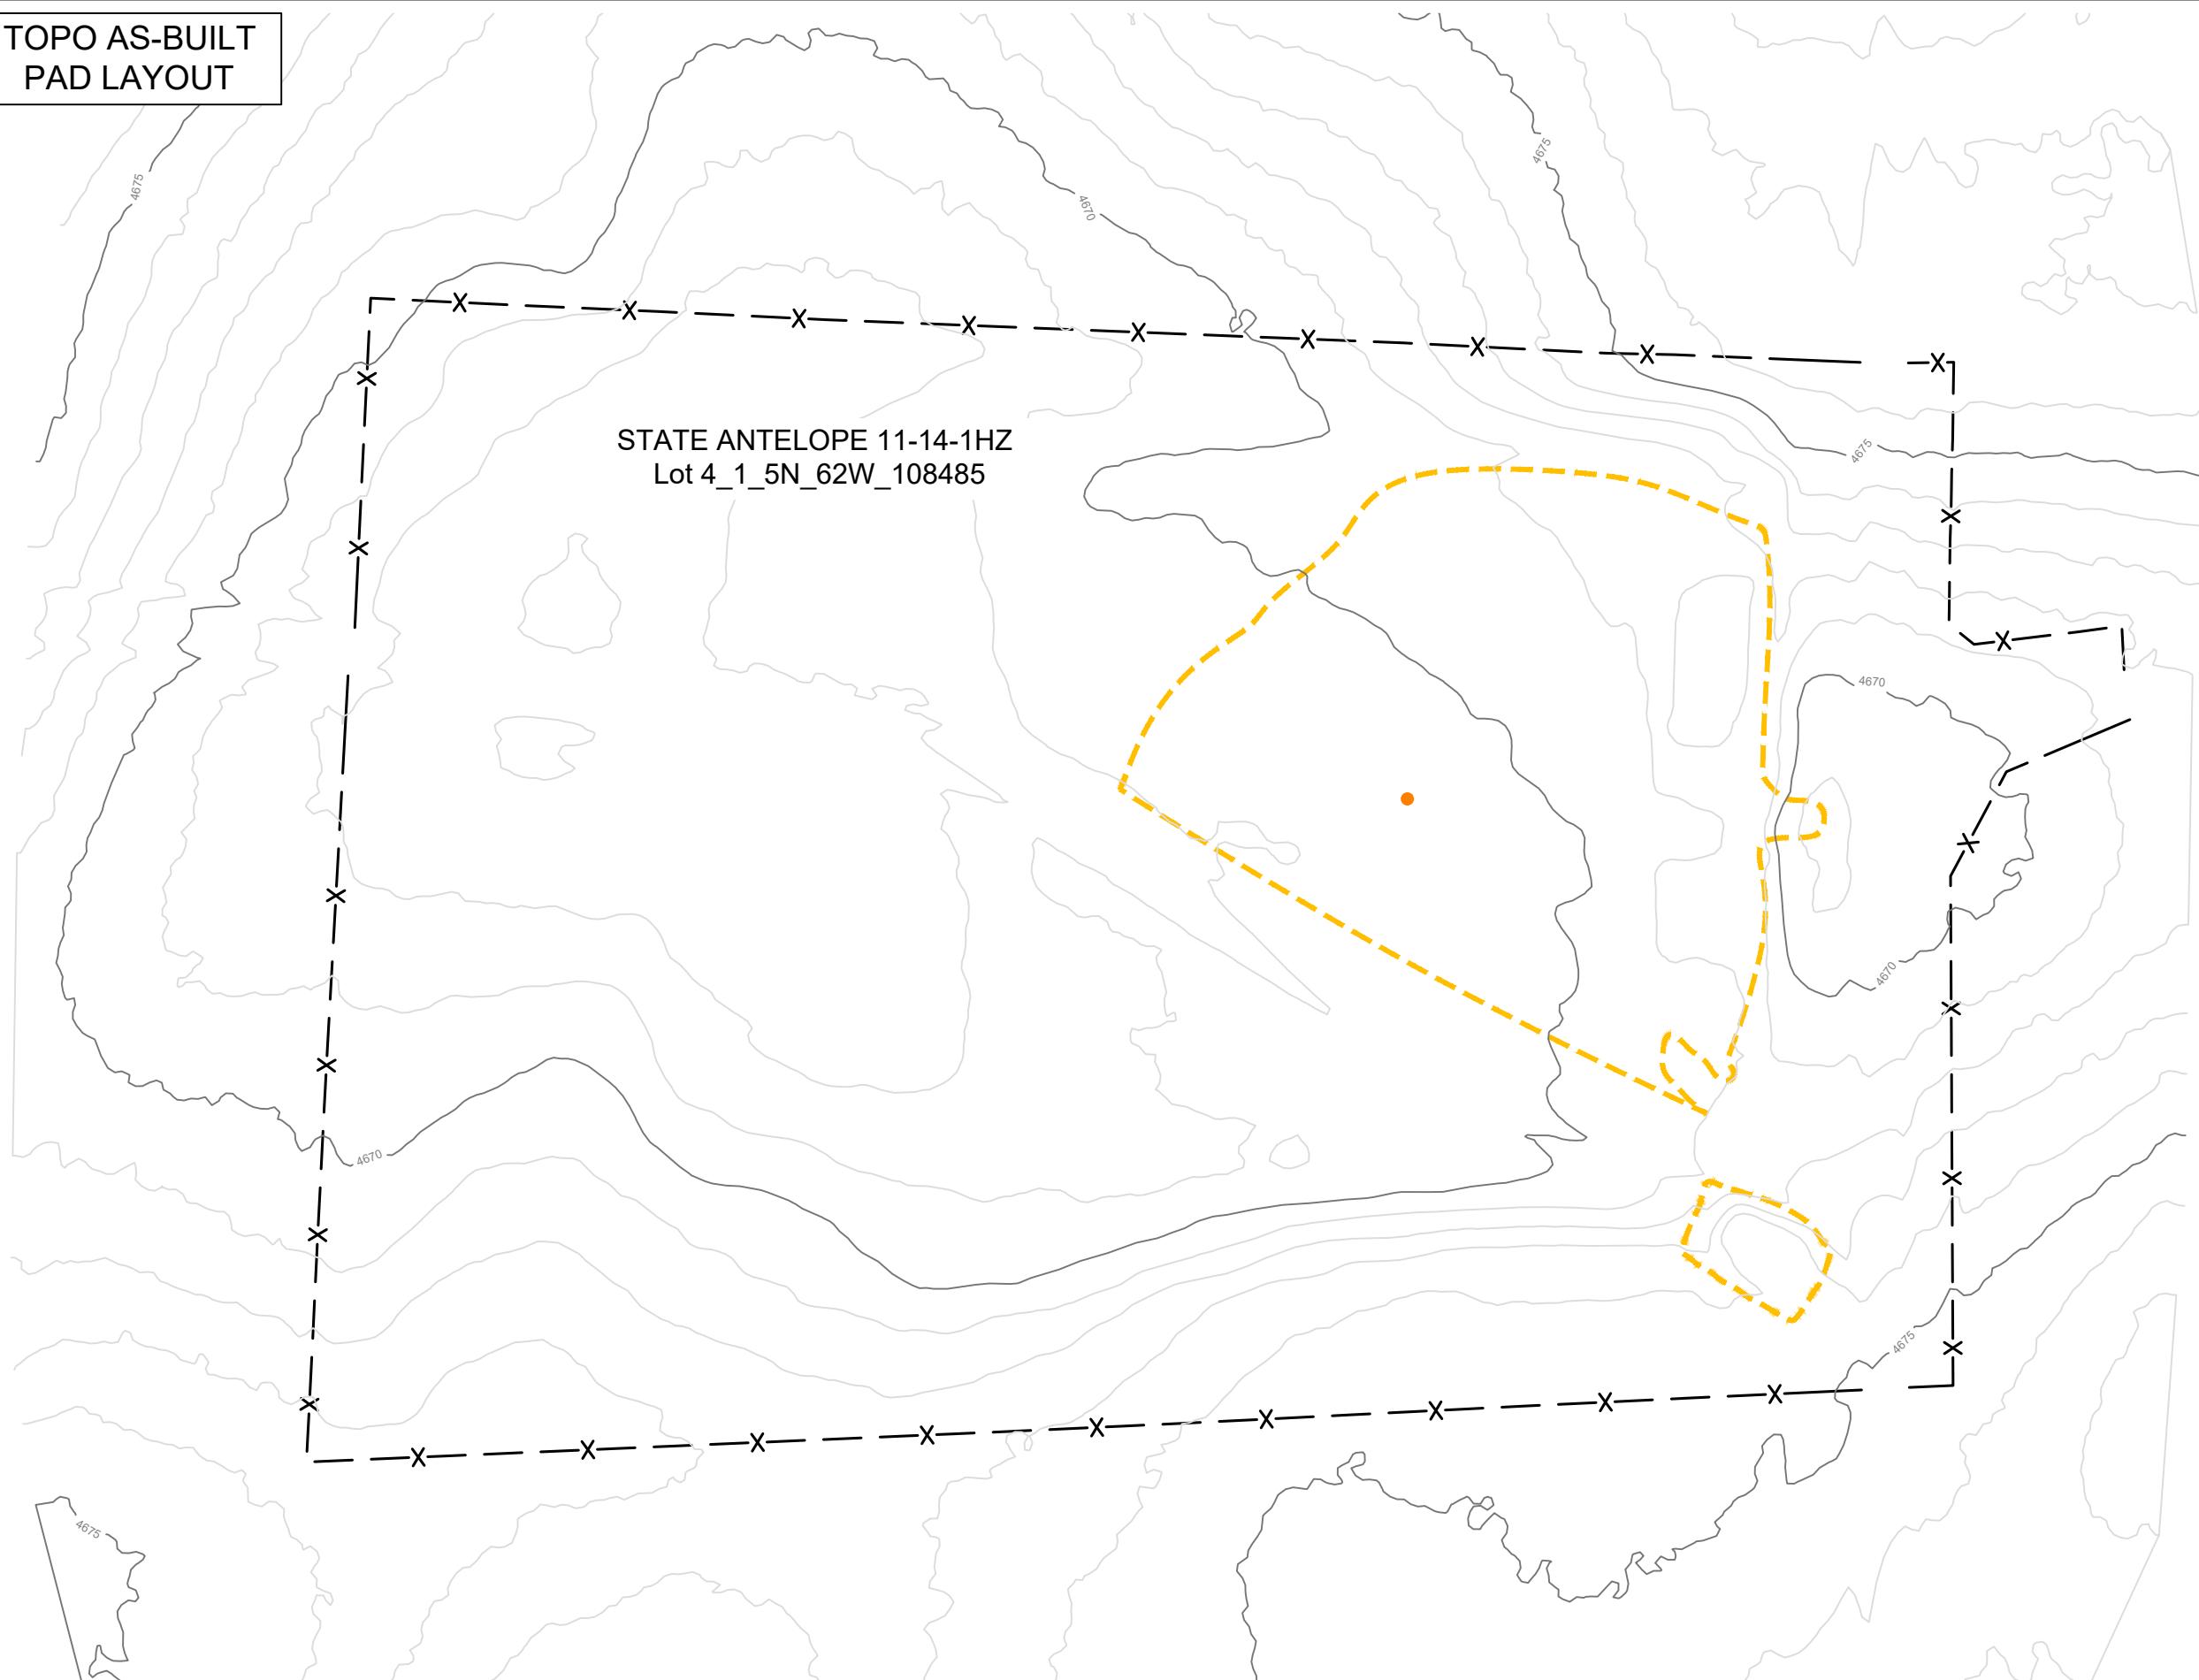



---

## **NOTES**

\*\*UPDATED AERIAL ORTHOIMAGERY COLLECTED BY  
RPG RESOURCES BY USE OF UAV IN AUGUST, 2021\*\*

**AREA INSIDE FENCE: 9.10 ACRES**

INT. RECLAMATION PAD FOOTPRINT AREA: 1.46 ACRES

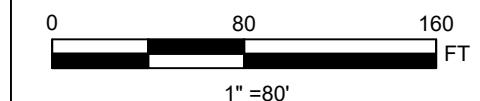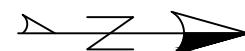

---

***LEGEND***

- 4600 — MAJOR CONTOUR  
— MINOR CONTOUR  
-x- FENCE LINE  
--- PAD EDGE  
● WELL HEAD



RPG  
RESOURCES

**STATE ANTELOPE 11-14-1HZ  
AS-BUILT EXHIBITS**

SECTION 1, TOWNSHIP 5N, RANGE 62W,  
WELD COUNTY, COLORADO

SHEET NAME:	SHEET NO.
TOPO OVERVIEW	2 OF 2