

AERIAL AS-BUILT PAD LAYOUT

STATE ANTELOPE D-13
NWSW_13_5N_62W_108516





NOTES

**UPDATED AERIAL ORTHOIMAGERY COLLECTED BY
RPG RESOURCES BY USE OF UAV IN SEPTEMBER,
2021**

AREA INSIDE FENCE: 6.54 ACRES

INT. RECLAMATION PAD FOOTPRINT AREA: 2.41 ACRES

ACCESS ROAD SURFACE AREA: 1.55 ACRES

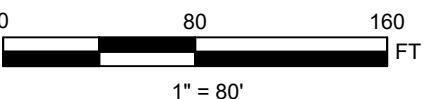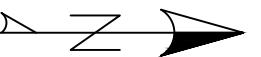

LEGEND

- — — ACCESS ROAD
- - - FENCE LINE
- - - PAD EDGE
- WELL HEAD




STATE ANTELOPE D-13 AS-BUILT EXHIBITS

SECTION 13, TOWNSHIP 5N, RANGE 62W,
WELD COUNTY, COLORADO

SHEET NAME:	SHEET NO.
AERIAL IMAGERY	1 OF 10


**TOPO AS-BUILT
PAD LAYOUT**

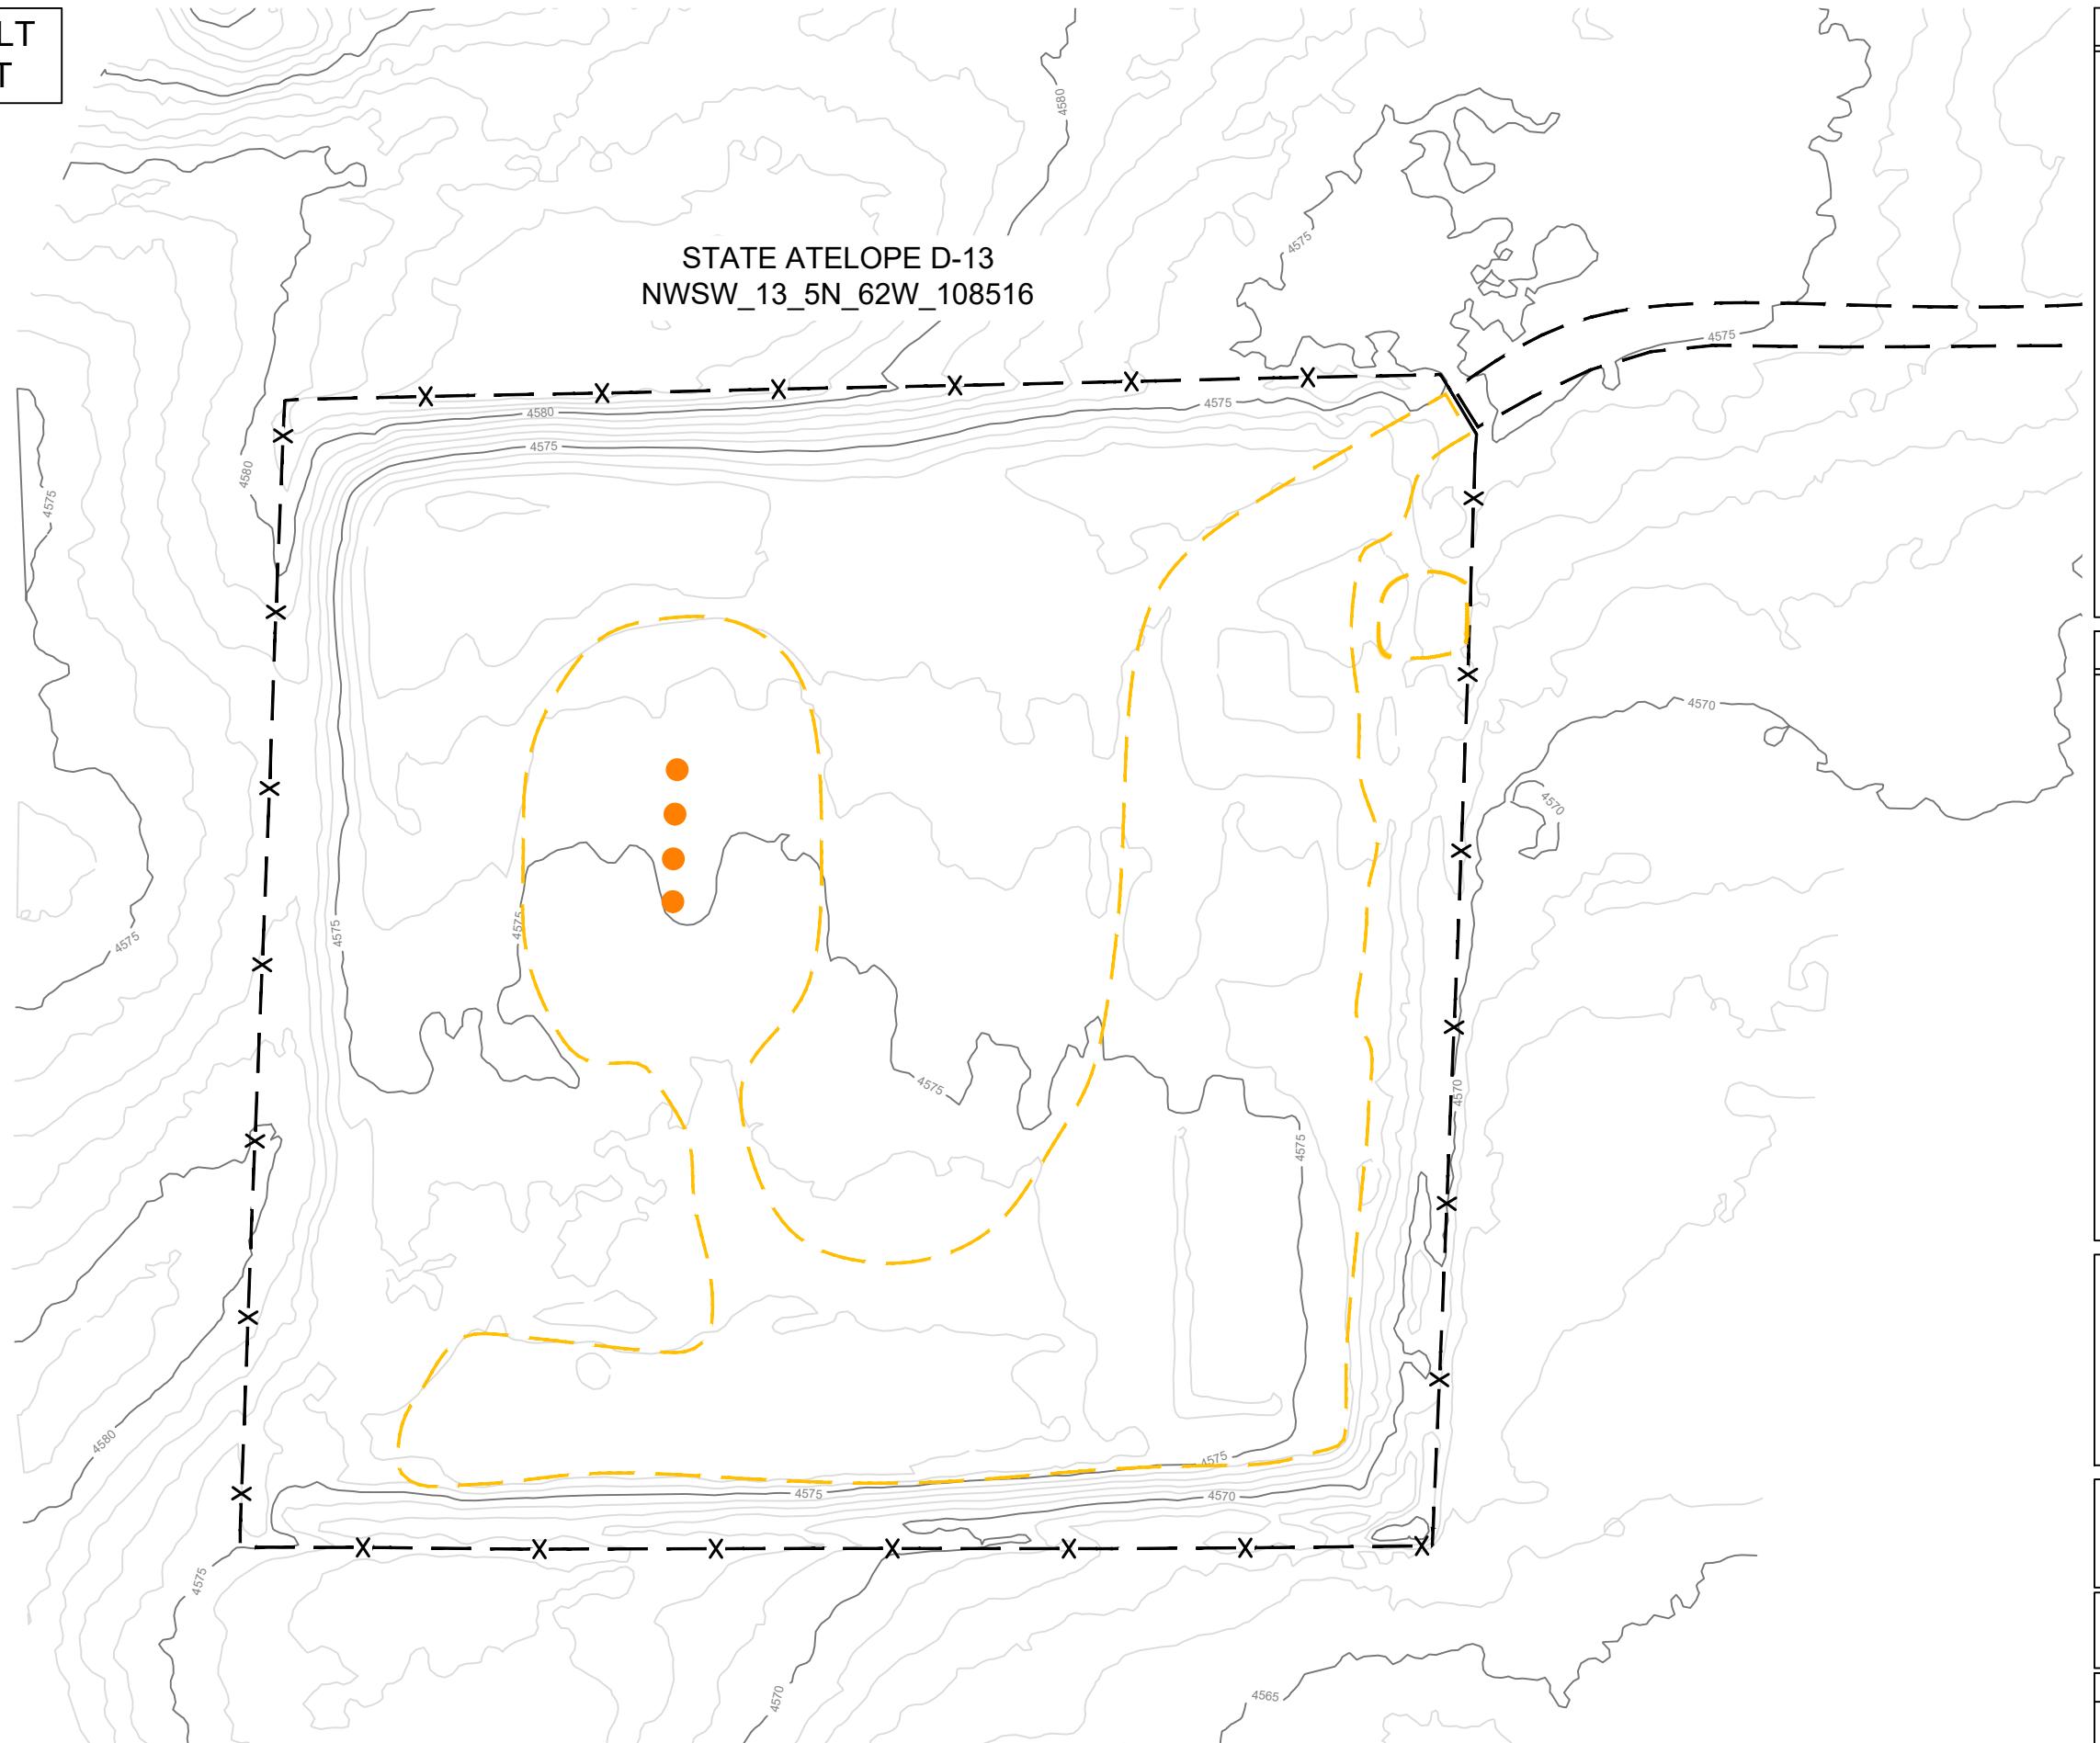

NOTES

**UPDATED TOPO DATA COLLECTED BY RPG
RESOURCES BY USE OF UAV IN SEPTEMBER, 2021**

AREA INSIDE FENCE: 6.54 ACRES
INT. RECLAMATION PAD FOOTPRINT AREA: 2.41 ACRES
ACCESS ROAD SURFACE AREA: 1.55 ACRES

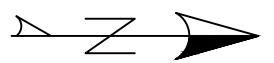

0 80 160 FT
1" = 80'

LEGEND

- 4505 — MAJOR CONTOUR
- 4575 — MINOR CONTOUR
- - - - - ACCESS ROAD
- x-x- - FENCE LINE
- - - - - PAD EDGE
- WELL HEAD



**STATE ANTELOPE D-13
AS-BUILT EXHIBITS**

SECTION 13, TOWNSHIP 5N, RANGE 62W,
WELD COUNTY, COLORADO



SHEET NAME:	SHEET NO.
TOPO OVERVIEW	2 OF 10

AERIAL AS-BUILT ACCESS ROAD



NOTES

UPDATED AERIAL ORTHOIMAGERY COLLECTED BY RPG RESOURCES BY USE OF UAV IN SEPTEMBER, 2021
PERMITTED DISTURBANCE AREA: 5.75 ACRES
AREA INSIDE FENCE: 6.54 ACRES
INT. RECLAMATION PAD FOOTPRINT AREA: 2.41 ACRES
ACCESS ROAD SURFACE AREA: 1.55 ACRES

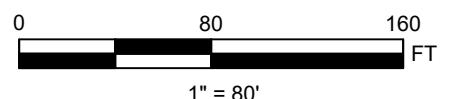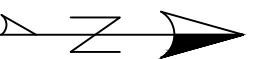

LEGEND

- — — — — ACCESS ROAD
- x-x-x-x- FENCE LINE
- - - - - PAD EDGE




STATE ANTELOPE D-13 AS-BUILT EXHIBITS

SECTION 13, TOWNSHIP 5N, RANGE 62W,
WELD COUNTY, COLORADO

SHEET NAME:	SHEET NO.
ACCESS ROAD IMAGERY	3 OF 10

**TOPO AS-BUILT
ACCESS ROAD**

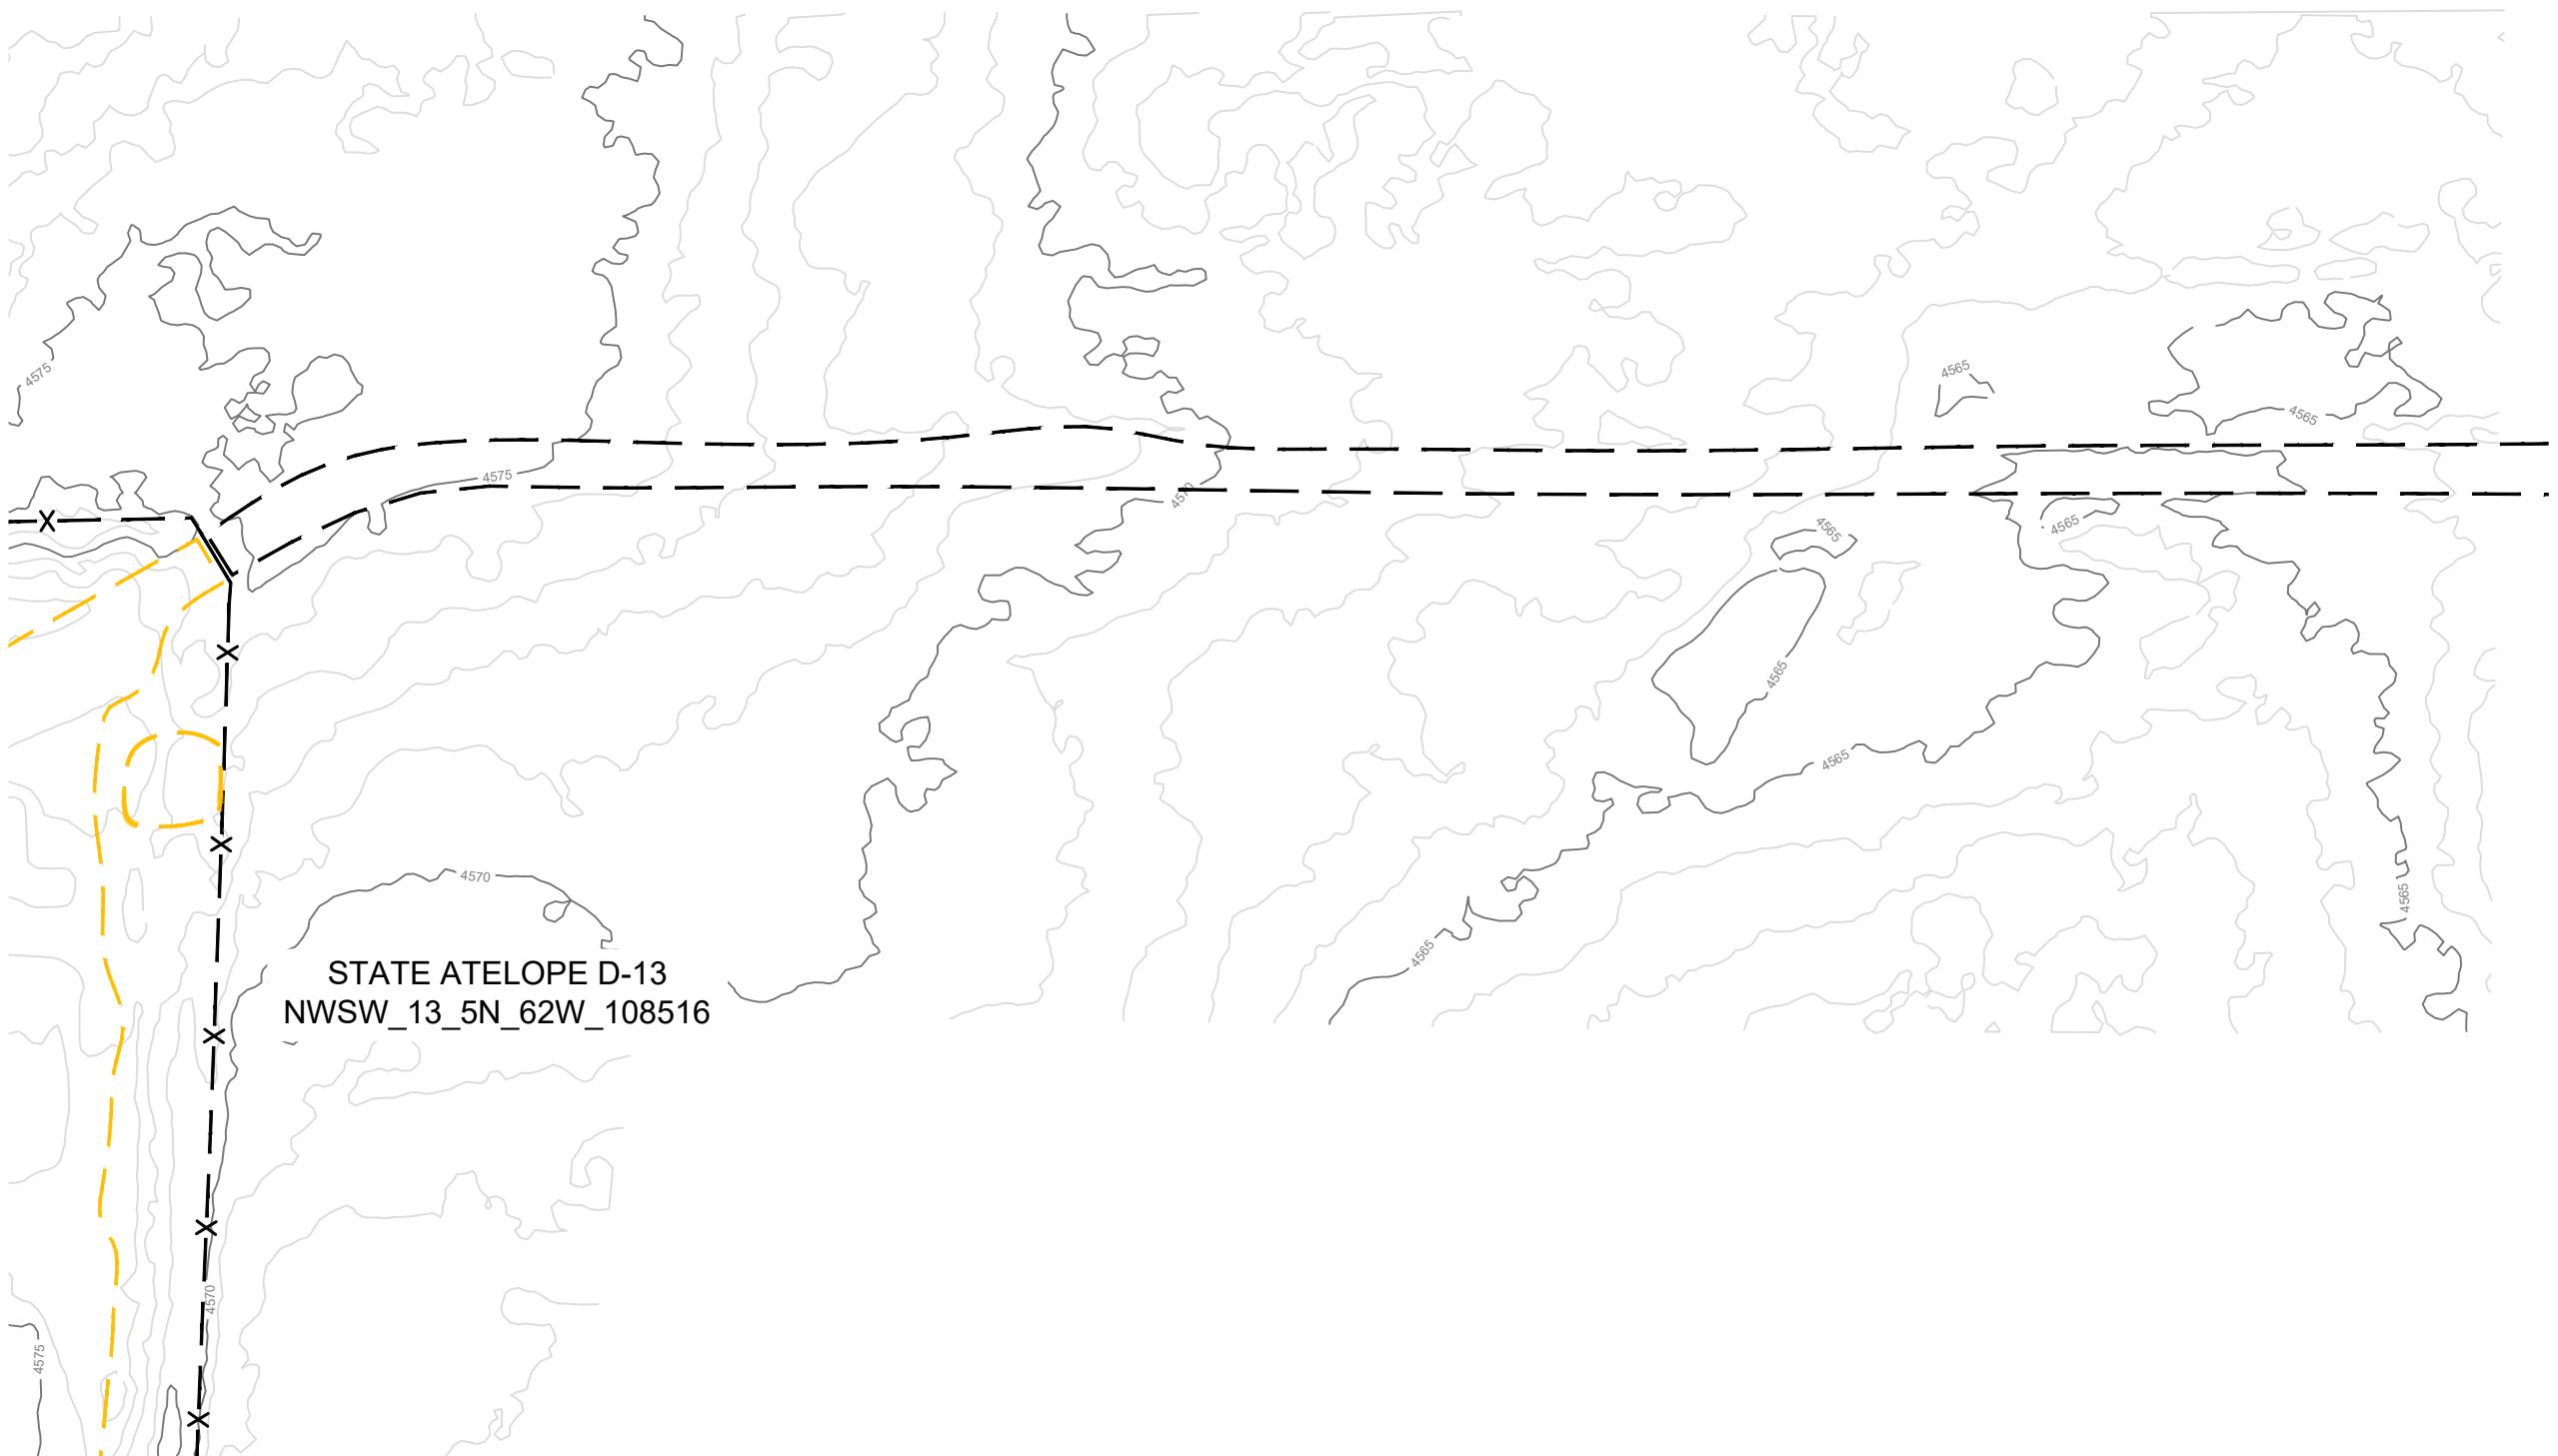

NOTES



UPDATED TOPO DATA COLLECTED BY RPG RESOURCES BY USE OF UAV IN SEPTEMBER, 2021

PERMITTED DISTURBANCE AREA: 5.75 ACRES

AREA INSIDE FENCE: 6.54 ACRES

INT. RECLAMATION PAD FOOTPRINT AREA: 2.41 ACRES

ACCESS ROAD SURFACE AREA: 1.55 ACRES

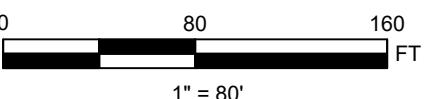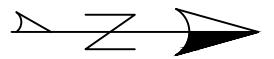

LEGEND

- 4505 — MAJOR CONTOUR
- 4565 — MINOR CONTOUR
- - - - - ACCESS ROAD
- x-x- - FENCE LINE
- - - - - PAD EDGE



**STATE ANTELOPE D-13
AS-BUILT EXHIBITS**

SECTION 13, TOWNSHIP 5N, RANGE 62W,
WELD COUNTY, COLORADO



SHEET NAME:	SHEET NO.
ACCESS ROAD TOPO	4 OF 10

AERIAL AS-BUILT
ACCESS ROAD



NOTES

**UPDATED AERIAL ORTHOIMAGERY COLLECTED BY
RPG RESOURCES BY USE OF UAV IN SEPTEMBER,
2021**
PERMITTED DISTURBANCE AREA: 5.75 ACRES
AREA INSIDE FENCE: 6.54 ACRES
INT. RECLAMATION PAD FOOTPRINT AREA: 2.41 ACRES
ACCESS ROAD SURFACE AREA: 1.55 ACRES

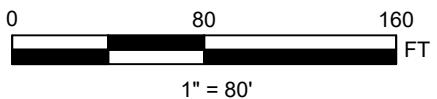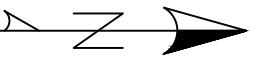

LEGEND

— — — — ACCESS ROAD




STATE ANTELOPE D-13
AS-BUILT EXHIBITS

SECTION 13, TOWNSHIP 5N, RANGE 62W,
WELD COUNTY, COLORADO

SHEET NAME:	SHEET NO.
ACCESS ROAD IMAGERY 2	5 OF 10

**TOPO AS-BUILT
ACCESS ROAD**

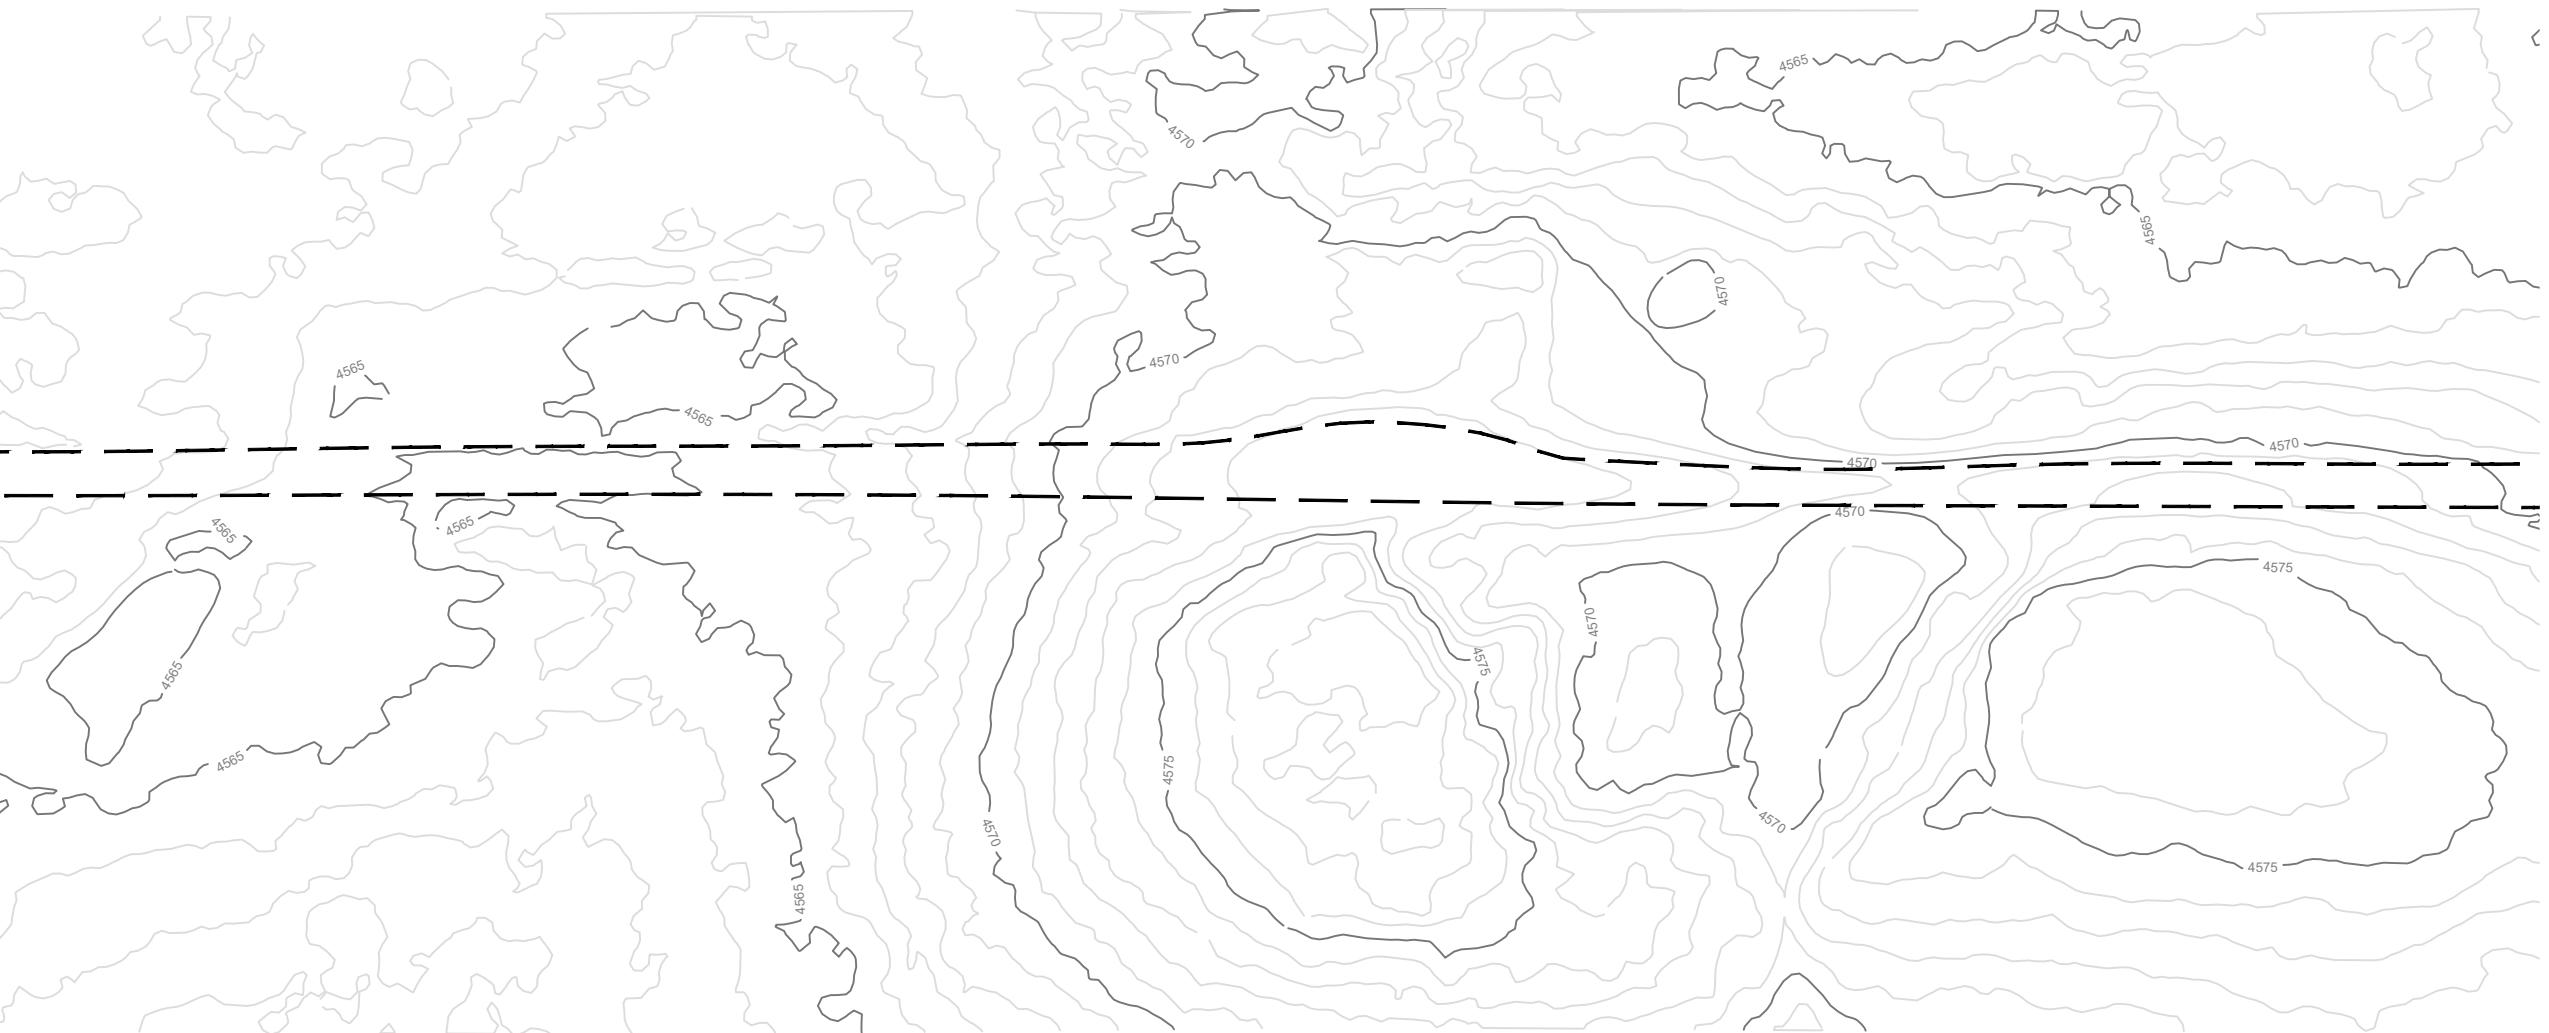

NOTES



**UPDATED TOPO DATA COLLECTED BY RPG
RESOURCES BY USE OF UAV IN SEPTEMBER, 2021**

PERMITTED DISTURBANCE AREA: 5.75 ACRES

AREA INSIDE FENCE: 6.54 ACRES

INT. RECLAMATION PAD FOOTPRINT AREA: 2.41 ACRES

ACCESS ROAD SURFACE AREA: 1.55 ACRES

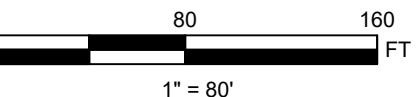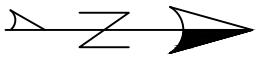

LEGEND

- MAJOR CONTOUR
- MINOR CONTOUR
- ACCESS ROAD




**STATE ANTELOPE D-13
AS-BUILT EXHIBITS**

SECTION 13, TOWNSHIP 5N, RANGE 62W,
WELD COUNTY, COLORADO



SHEET NAME:	SHEET NO.
ACCESS ROAD TOPO 2	6 OF 10

AERIAL AS-BUILT
ACCESS ROAD

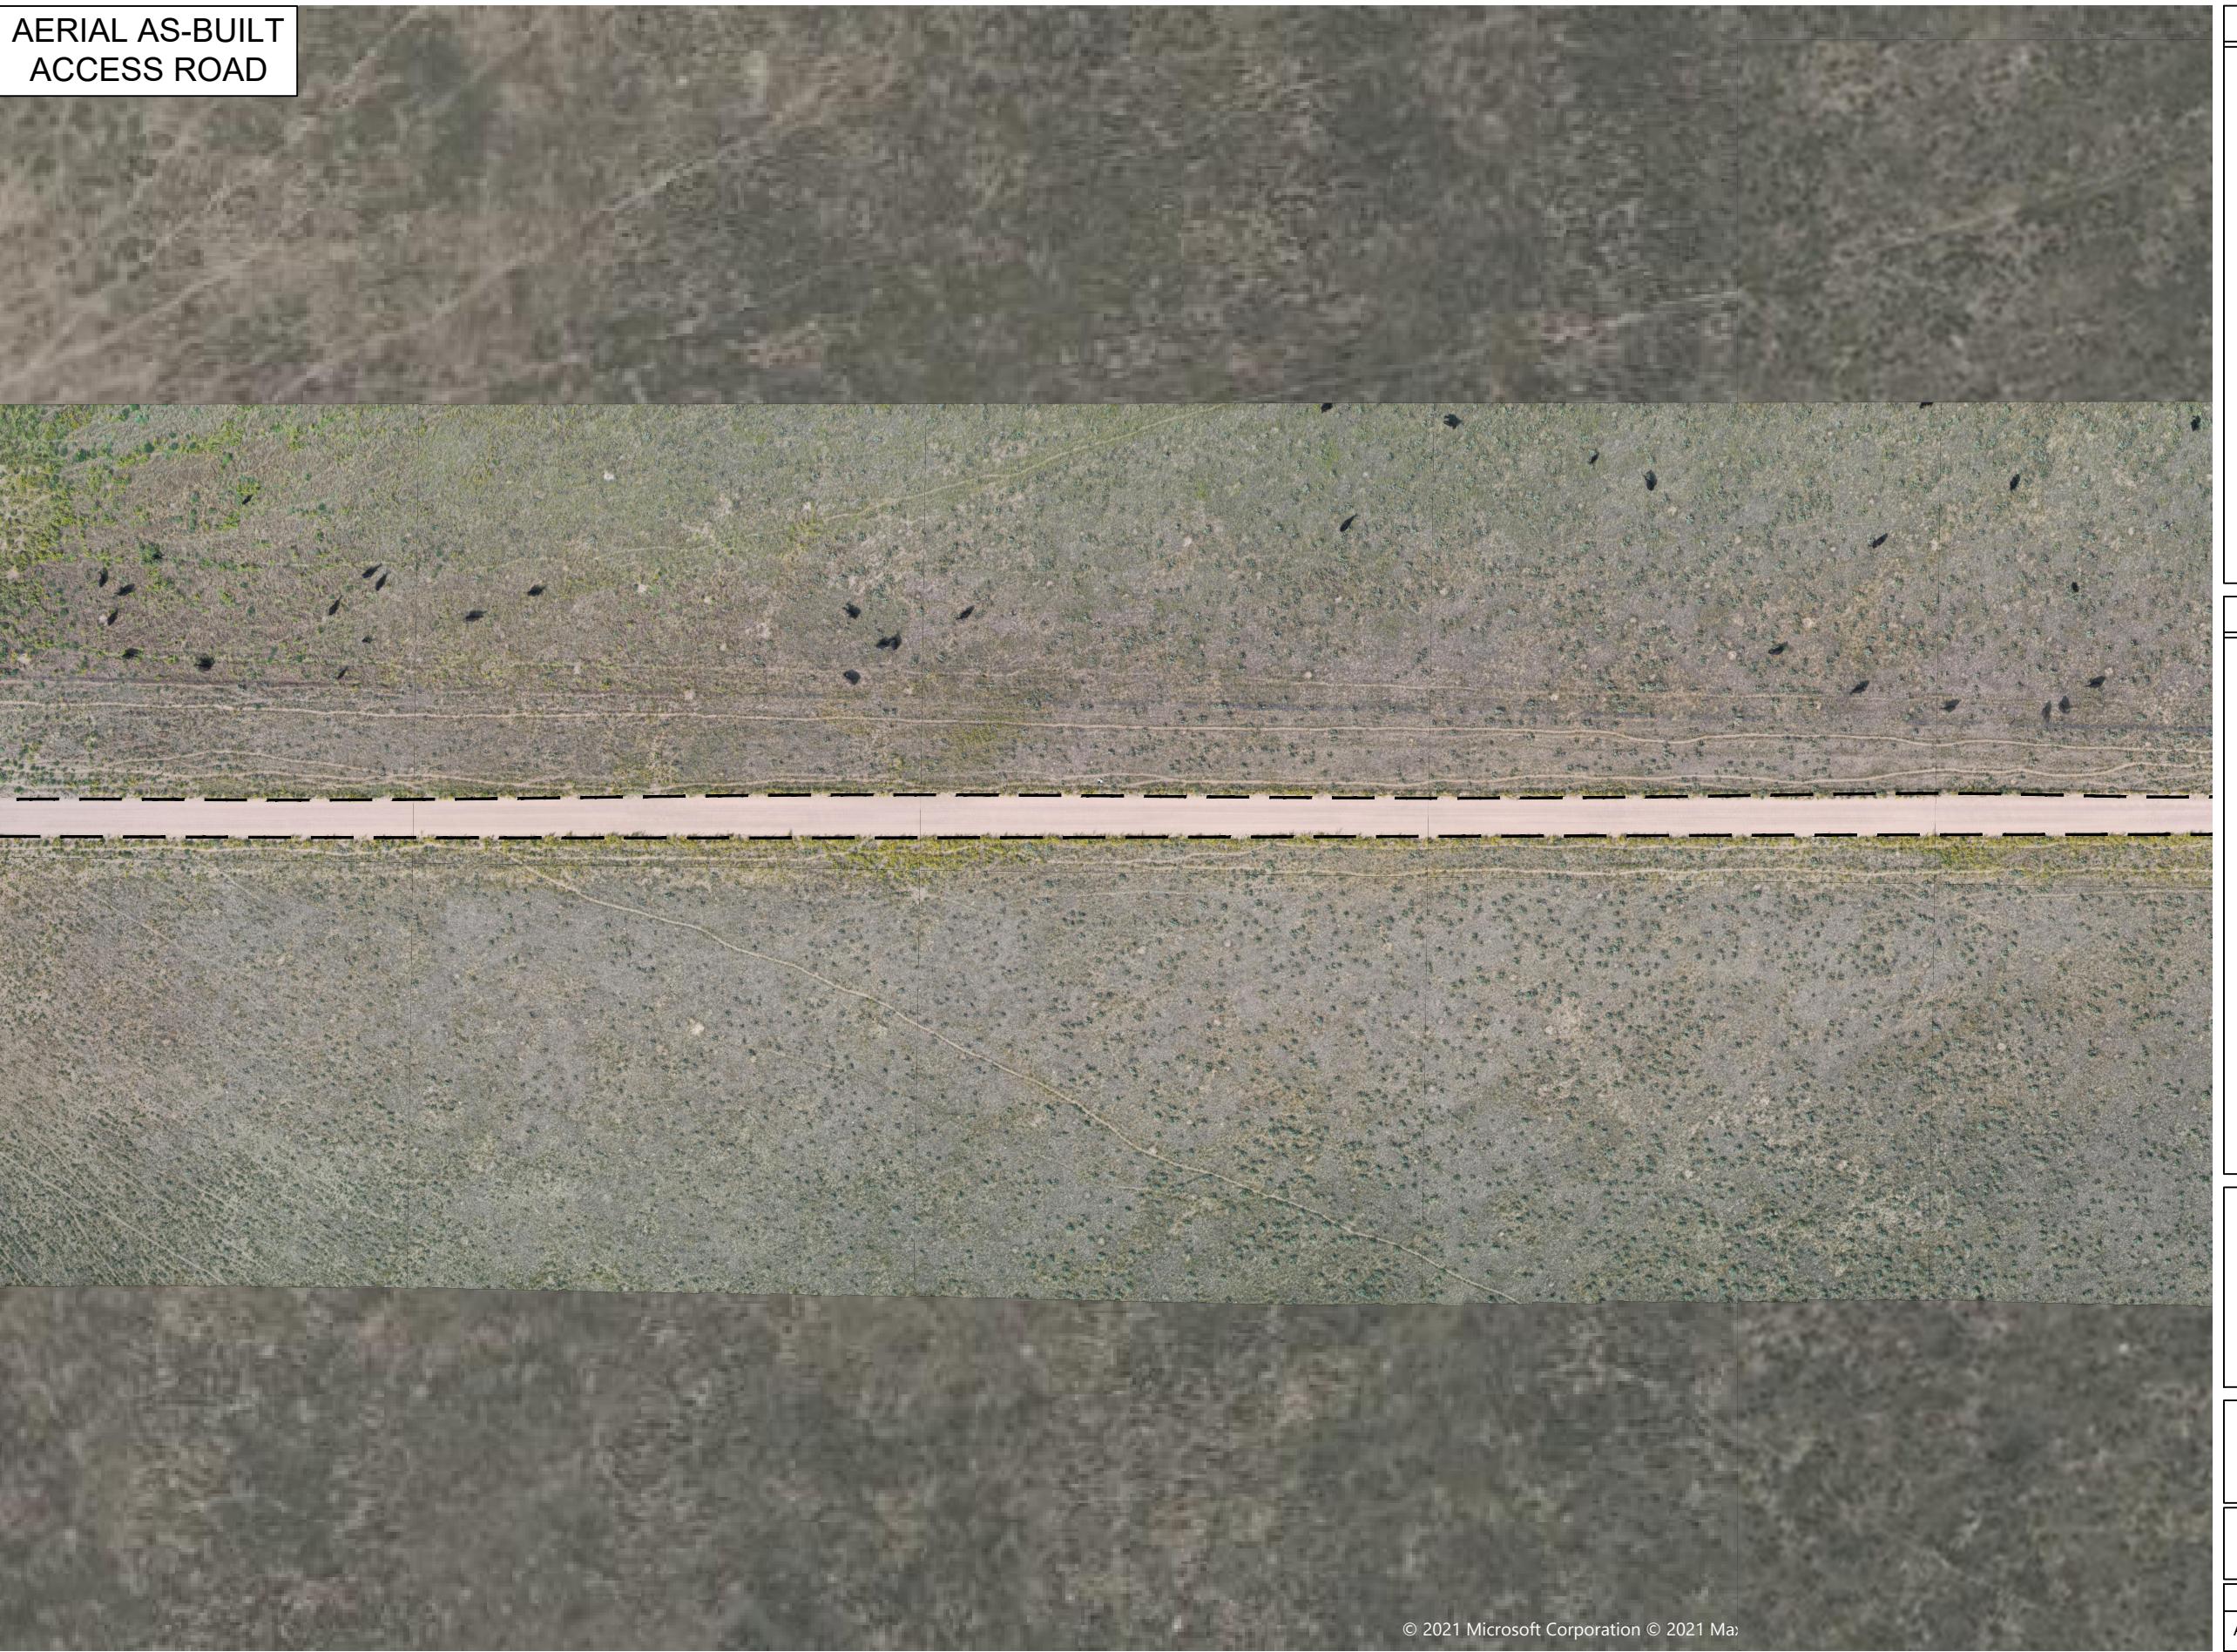

NOTES

**UPDATED AERIAL ORTHOIMAGERY COLLECTED BY
RPG RESOURCES BY USE OF UAV IN SEPTEMBER,
2021**
PERMITTED DISTURBANCE AREA: 5.75 ACRES
AREA INSIDE FENCE: 6.54 ACRES
INT. RECLAMATION PAD FOOTPRINT AREA: 2.41 ACRES
ACCESS ROAD SURFACE AREA: 1.55 ACRES

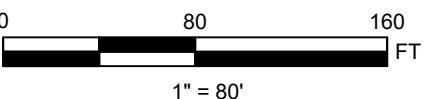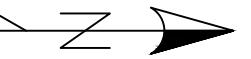

LEGEND

— — — — ACCESS ROAD




STATE ANTELOPE D-13
AS-BUILT EXHIBITS

SECTION 13, TOWNSHIP 5N, RANGE 62W,
WELD COUNTY, COLORADO

SHEET NAME:	SHEET NO.
ACCESS ROAD IMAGERY 3	7 OF 10

**TOPO AS-BUILT
ACCESS ROAD**

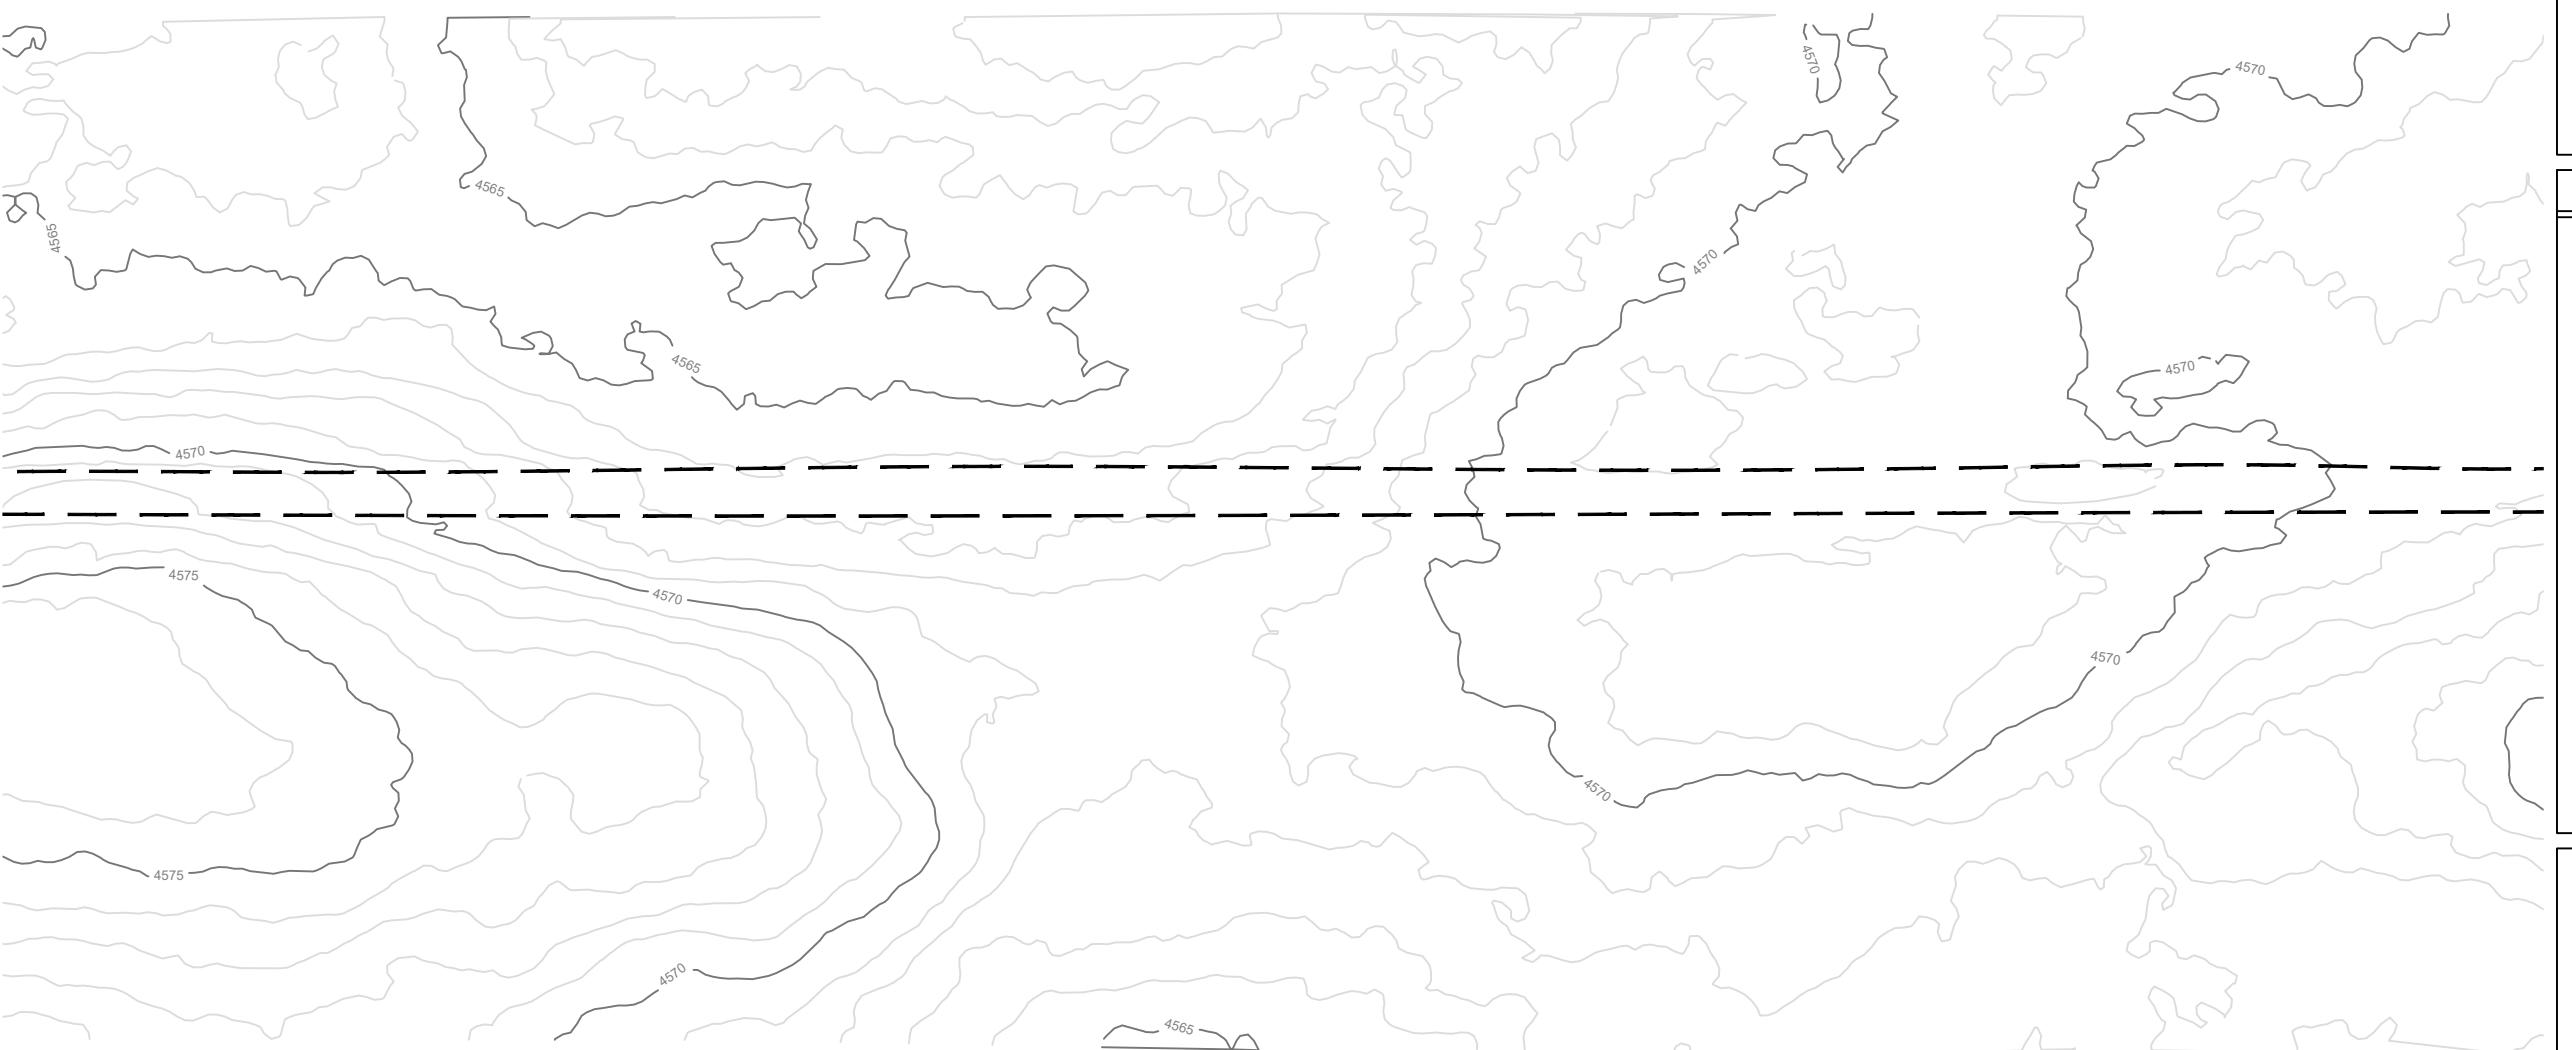

NOTES



**UPDATED TOPO DATA COLLECTED BY RPG
RESOURCES BY USE OF UAV IN SEPTEMBER, 2021**

PERMITTED DISTURBANCE AREA: 5.75 ACRES

AREA INSIDE FENCE: 6.54 ACRES

INT. RECLAMATION PAD FOOTPRINT AREA: 2.41 ACRES

ACCESS ROAD SURFACE AREA: 1.55 ACRES

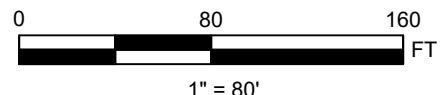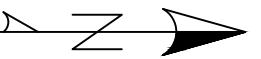

LEGEND

- 4505 — MAJOR CONTOUR
- 4570 — MINOR CONTOUR
- - - - - ACCESS ROAD



**STATE ANTELOPE D-13
AS-BUILT EXHIBITS**

SECTION 13, TOWNSHIP 5N, RANGE 62W,
WELD COUNTY, COLORADO



SHEET NAME:	SHEET NO.
ACCESS ROAD TOPO 3	8 OF 10

AERIAL AS-BUILT ACCESS ROAD



NOTES

UPDATED AERIAL ORTHOIMAGERY COLLECTED BY RPG RESOURCES BY USE OF UAV IN SEPTEMBER, 2021
PERMITTED DISTURBANCE AREA: 5.75 ACRES
AREA INSIDE FENCE: 6.54 ACRES
INT. RECLAMATION PAD FOOTPRINT AREA: 2.41 ACRES
ACCESS ROAD SURFACE AREA: 1.55 ACRES

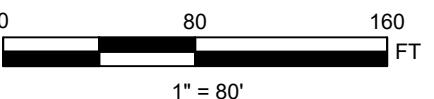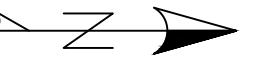

LEGEND

— — — — ACCESS ROAD




STATE ANTELOPE D-13 AS-BUILT EXHIBITS

SECTION 13, TOWNSHIP 5N, RANGE 62W,
WELD COUNTY, COLORADO

SHEET NAME:	SHEET NO.
ACCESS ROAD IMAGERY 4	9 OF 10

**TOPO AS-BUILT
ACCESS ROAD**

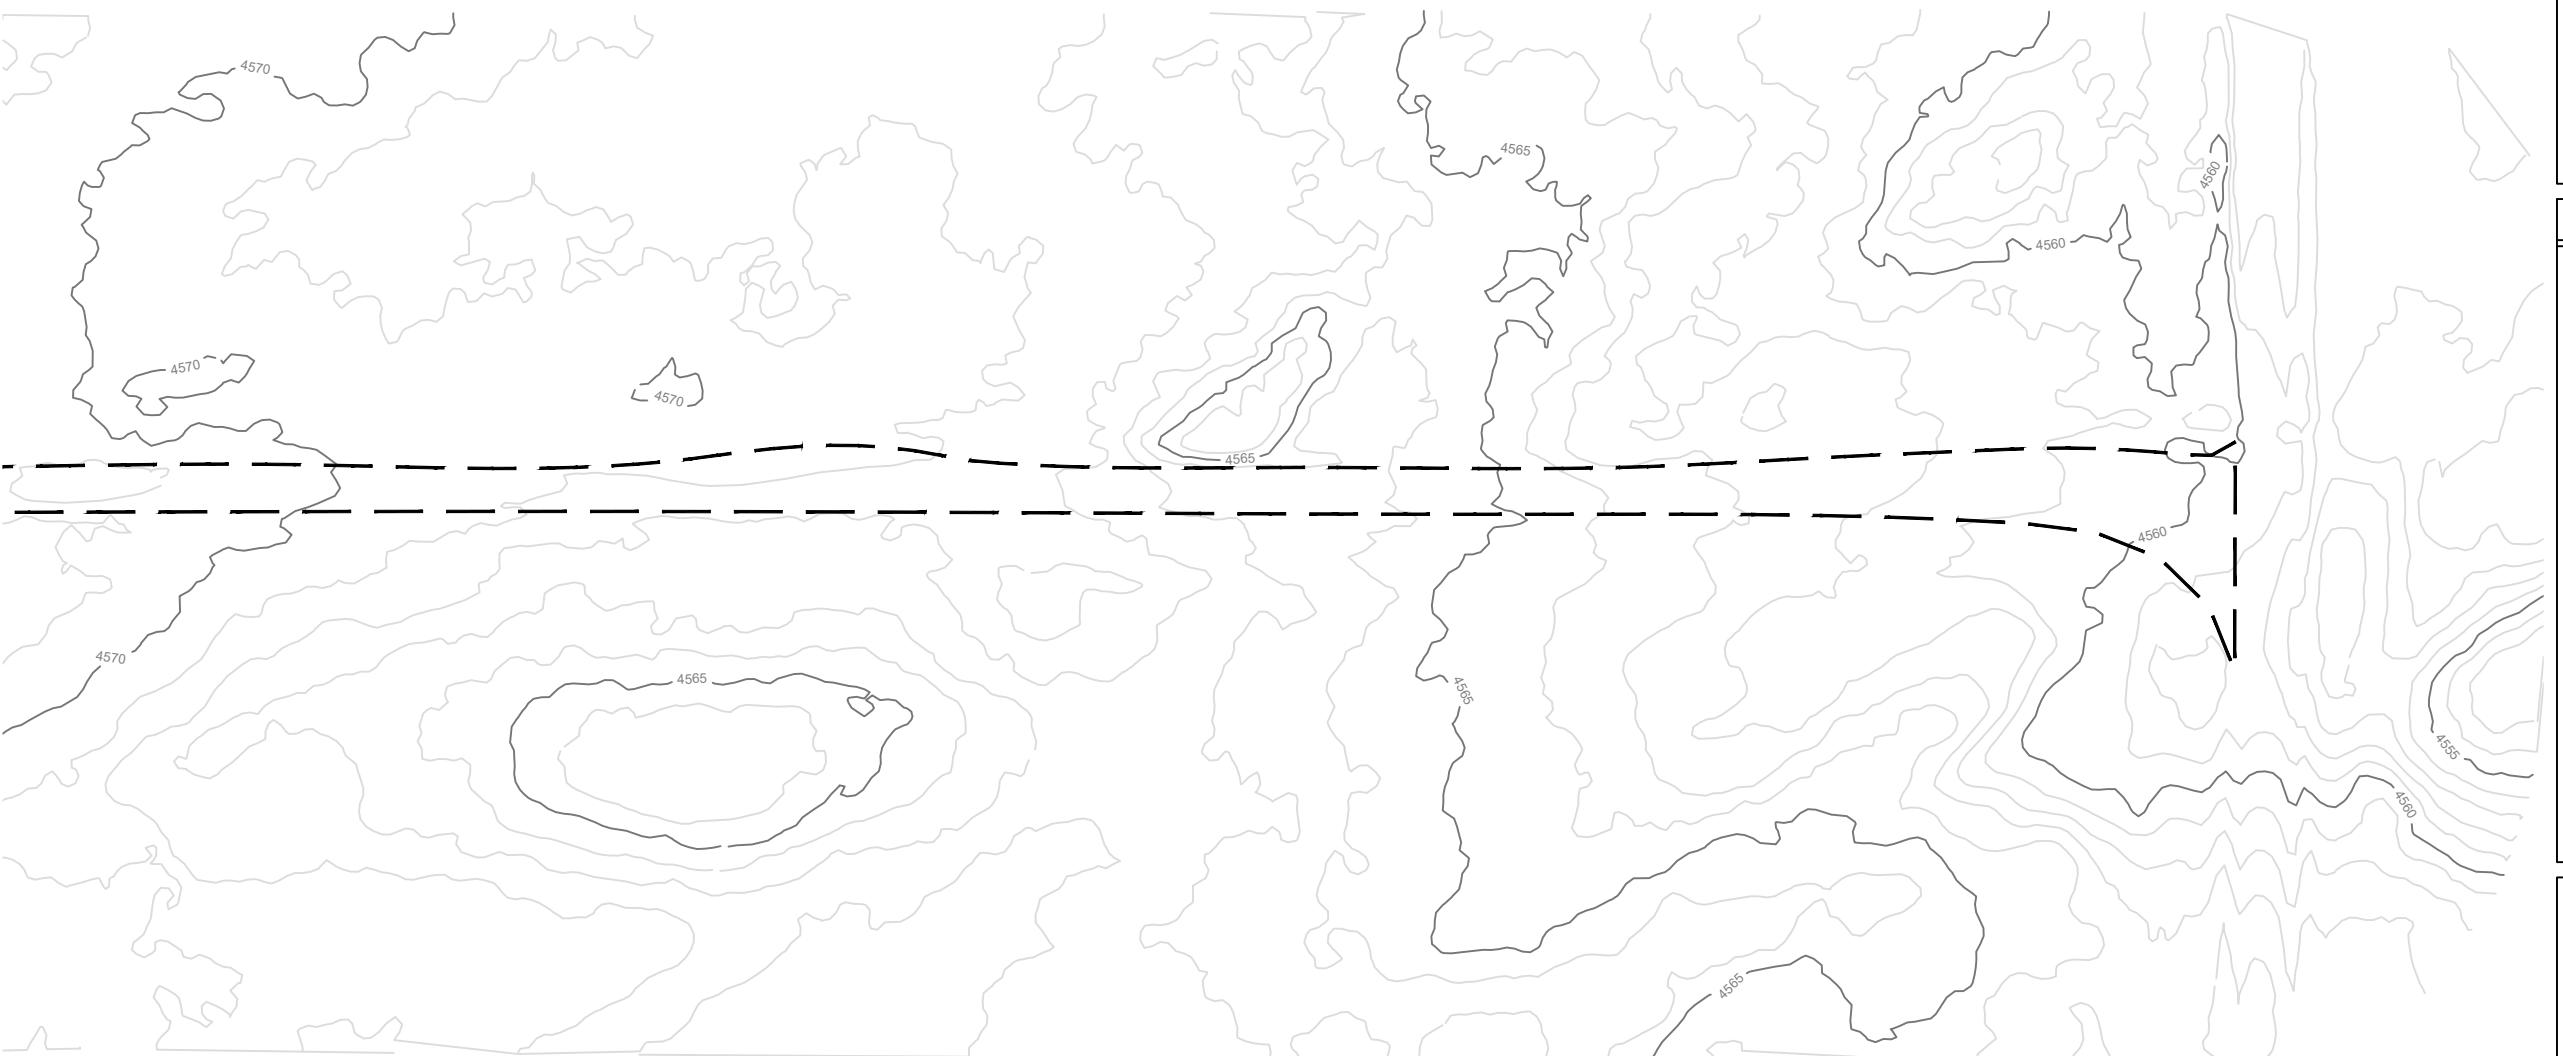

NOTES



**UPDATED TOPO DATA COLLECTED BY RPG
RESOURCES BY USE OF UAV IN SEPTEMBER, 2021**

PERMITTED DISTURBANCE AREA: 5.75 ACRES

AREA INSIDE FENCE: 6.54 ACRES

INT. RECLAMATION PAD FOOTPRINT AREA: 2.41 ACRES

ACCESS ROAD SURFACE AREA: 1.55 ACRES

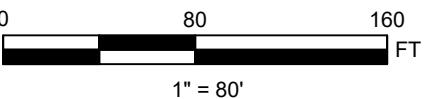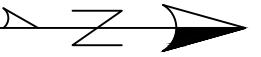

LEGEND

- 4505 — MAJOR CONTOUR
- 4565 — MINOR CONTOUR
- - - - - ACCESS ROAD



**STATE ANTELOPE D-13
AS-BUILT EXHIBITS**

SECTION 13, TOWNSHIP 5N, RANGE 62W,
WELD COUNTY, COLORADO

SHEET NAME:	SHEET NO.
ACCESS ROAD TOPO 4	10 OF 10